


TEXACO 157 Gal. 3237.


Class 'A' - Barge to be towed.
"For Coastwise Service in the Gulf of Mexico."
Longitudinal Framing
"Carrying petroleum in bulk."

THIS PLATE PLUS NEW TANKS RENEWED BY 1/2 PLATES

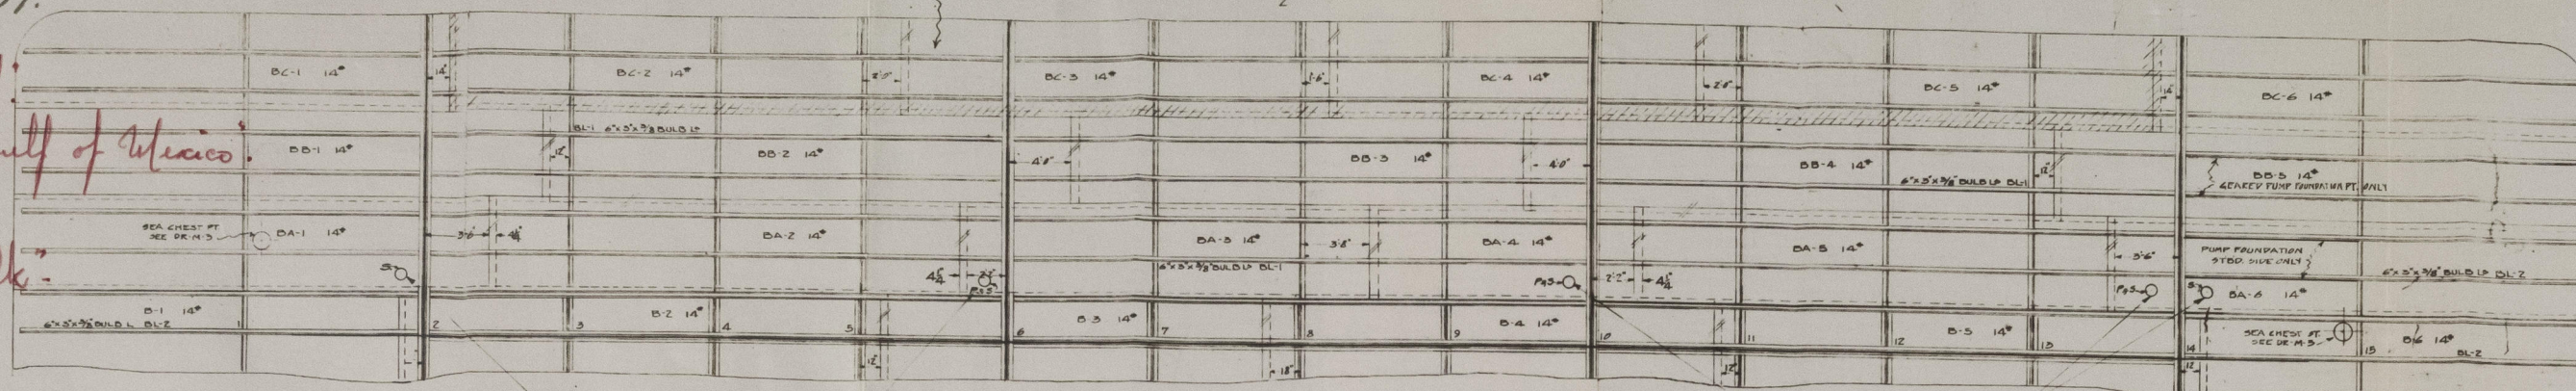


PLAN OF INNER BOTTOM

Location of Sleeper Plugs

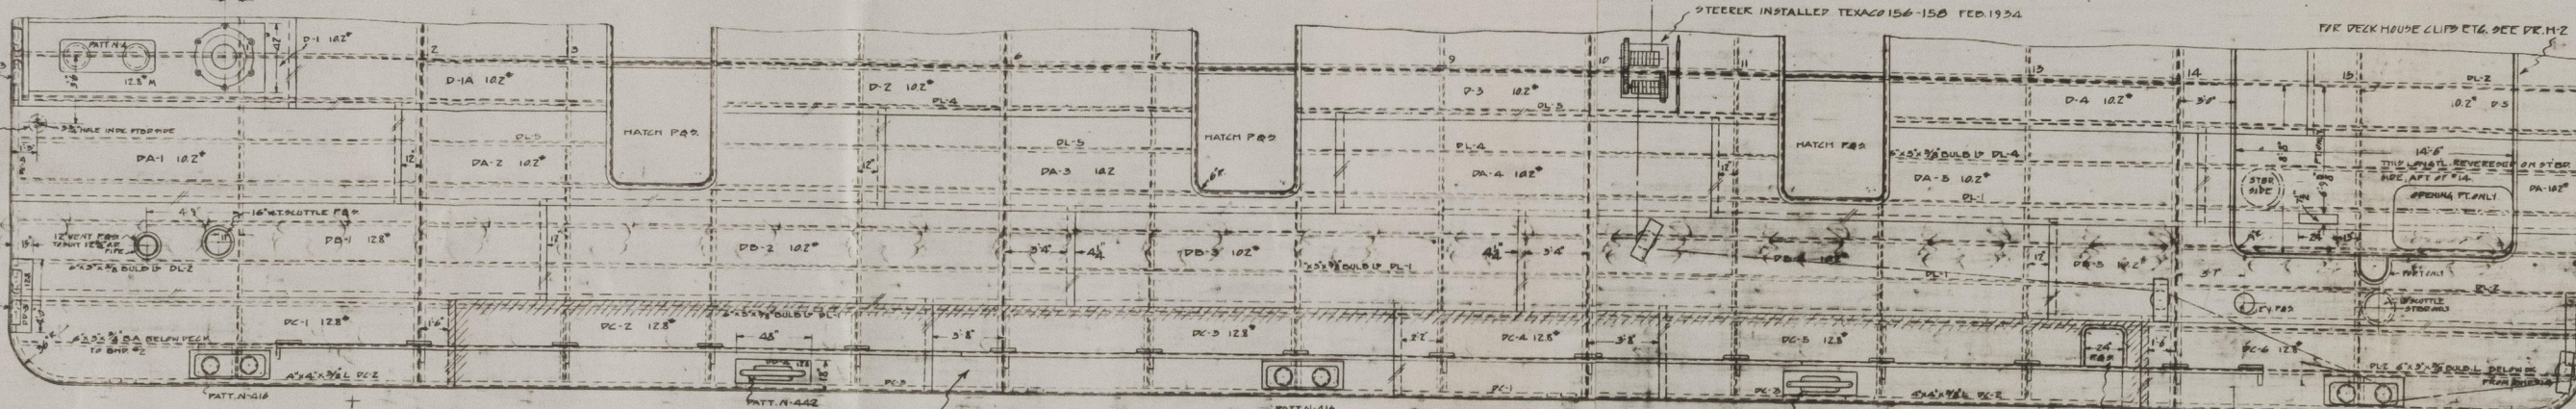


DECK PLAN


THIS PLATE PLUS NEW TANKS RENEWED BY 1/2 PLATES

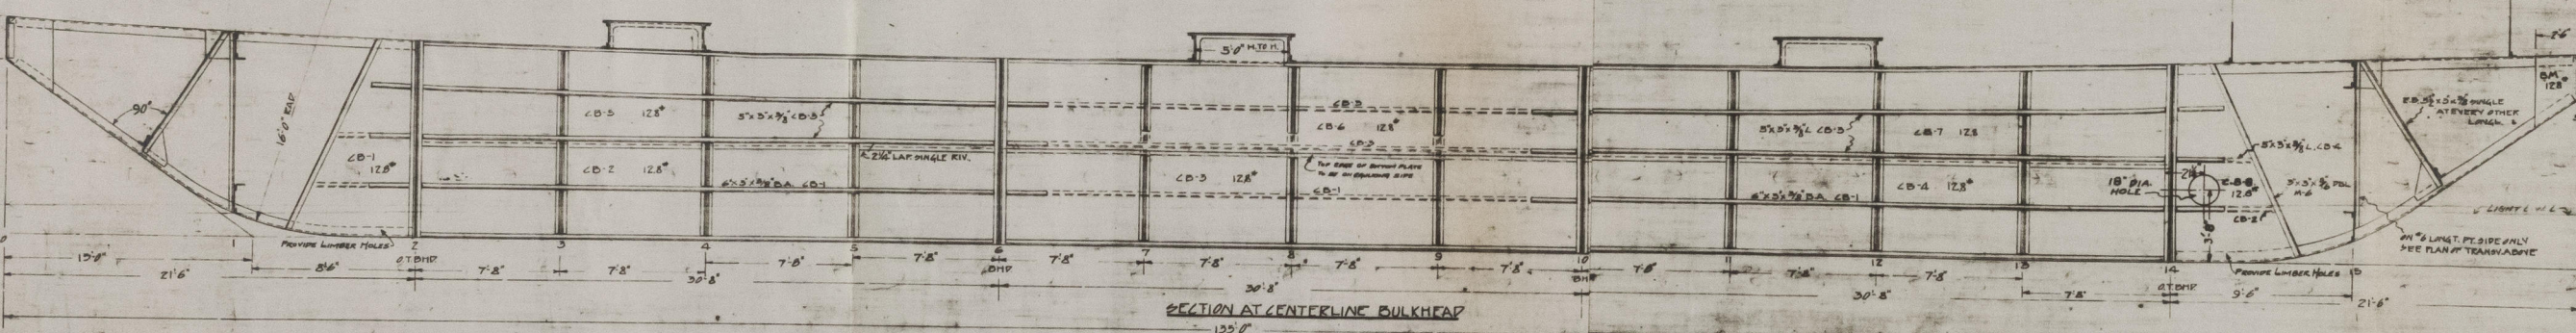


SECTION AT CENTERLINE BULKHEAD

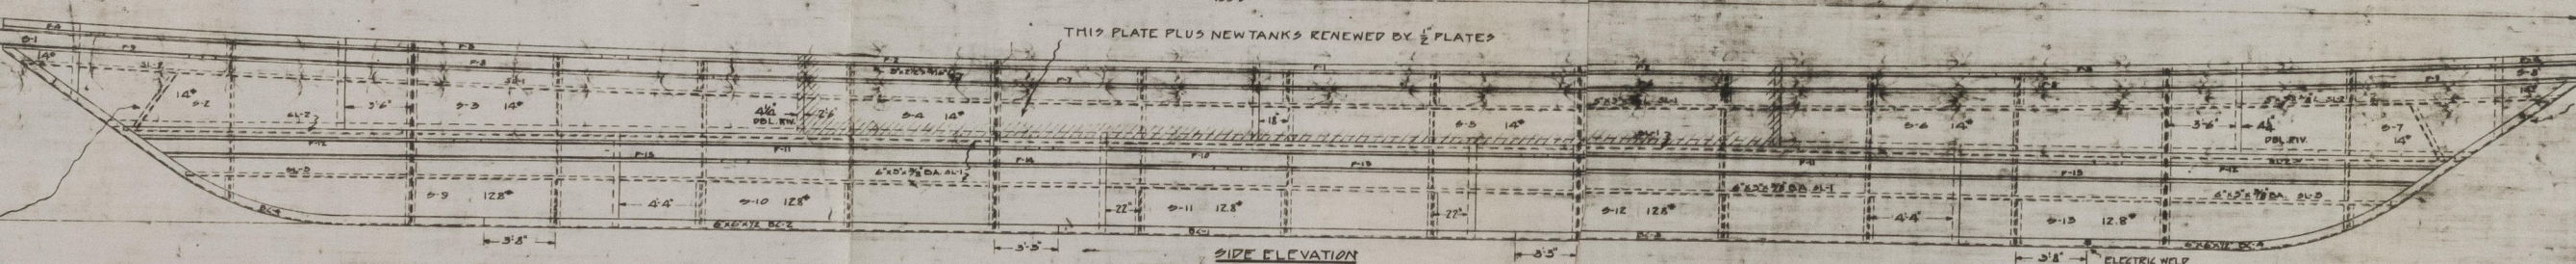

SIDE ELEVATION

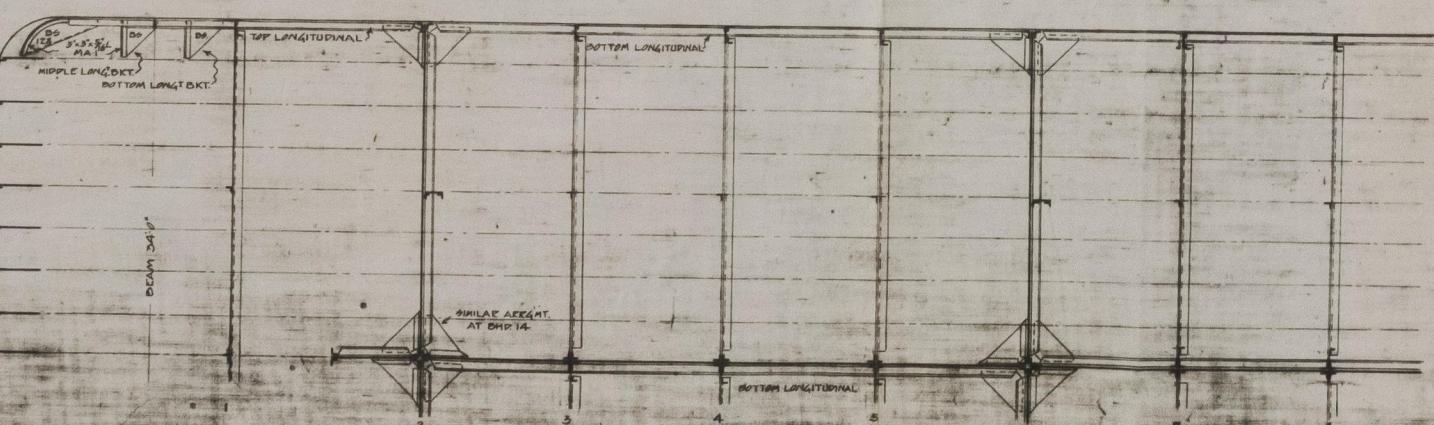



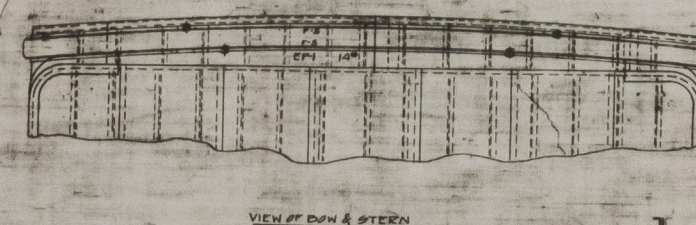


VIEW OF BOW & STERN


LONG SECTION THROUGH

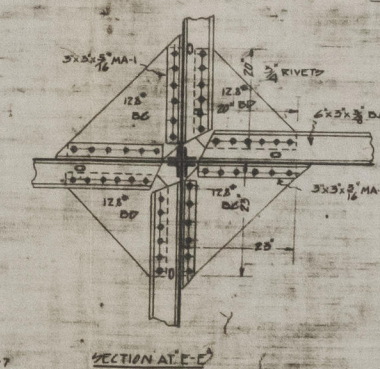



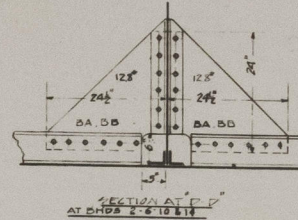



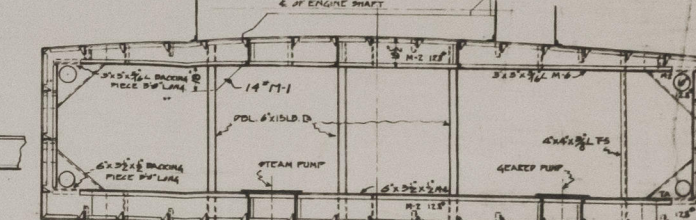



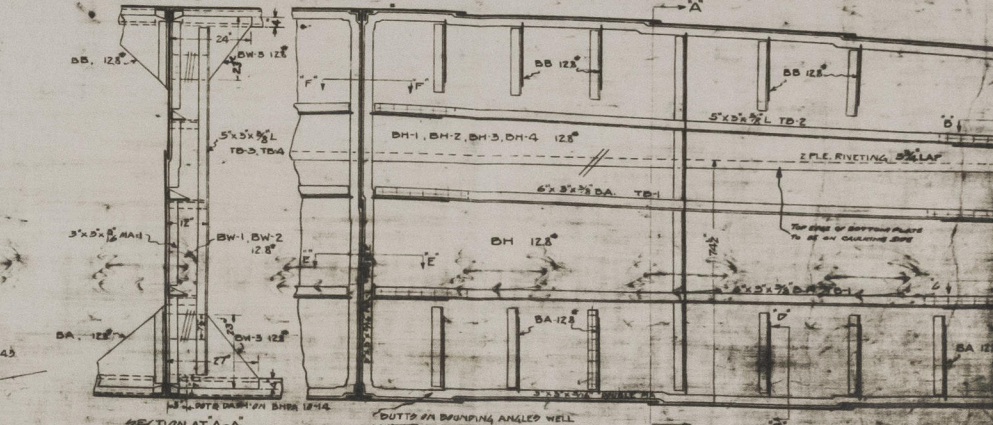



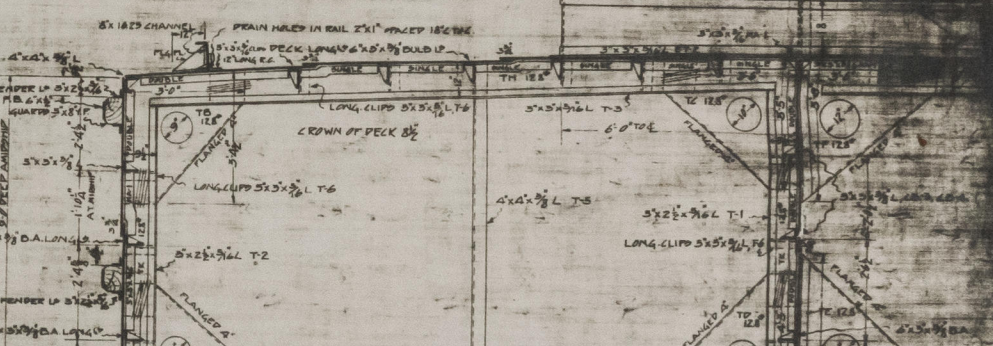



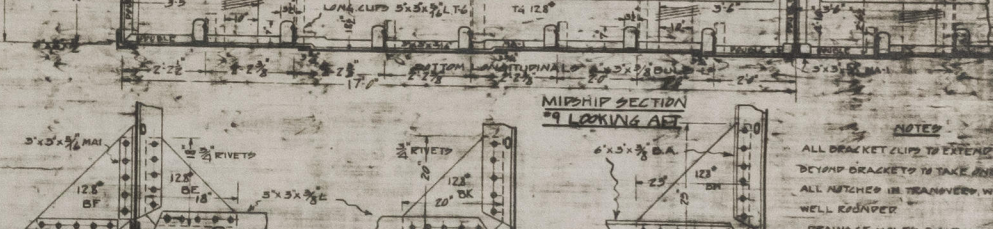


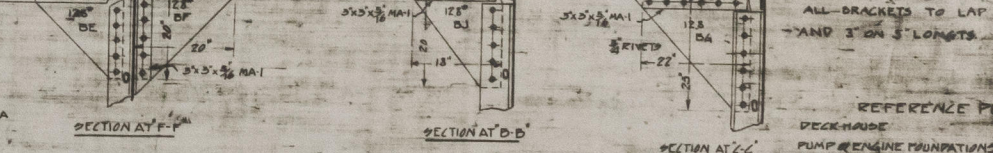


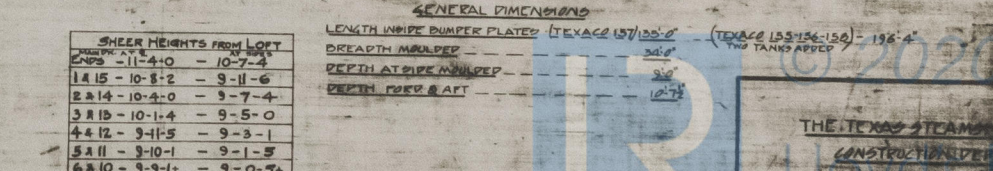


RIVETING SCHEDULE		

NOTES
ALL DRACKET CUTS TO EXTEND TO CENTERLINE
BEHIND DRACKET TO TAKE ALL SHEER
ALL NOTCHED IN TRANSVERSE WELLS
WELL EXPOSED
DRAINAGE HOLES & AIR HOLES TO BE DRILLED
WALL LONGIT. & APPROX. 1/2"
ALL DRACKET TO LAP 1" ON 3" LONGT.
AND 1" ON 3" LONGT.

REFERENCE PLANS
DECKHEAD
PUMP ENGINE FOUNDATIONS
EXPANSION TANK COLLAR

GENERAL DIMENSIONS

THE TEXAS STEAMSHIP
CONSTRUCTION
LLOYD'S REGISTER
HULL & ENGINE
MIDSHIP FOUNDATION

REPAIR PLUGS OF LOWER HULLS...
TWO TANKS...
PLATING INCREASED IN THICKNESS...

APPROVED

JUL 6 1937

LLOYD'S REGISTER OF SHIPPING
NEW YORK

Superior Copy

0000-012800-102800