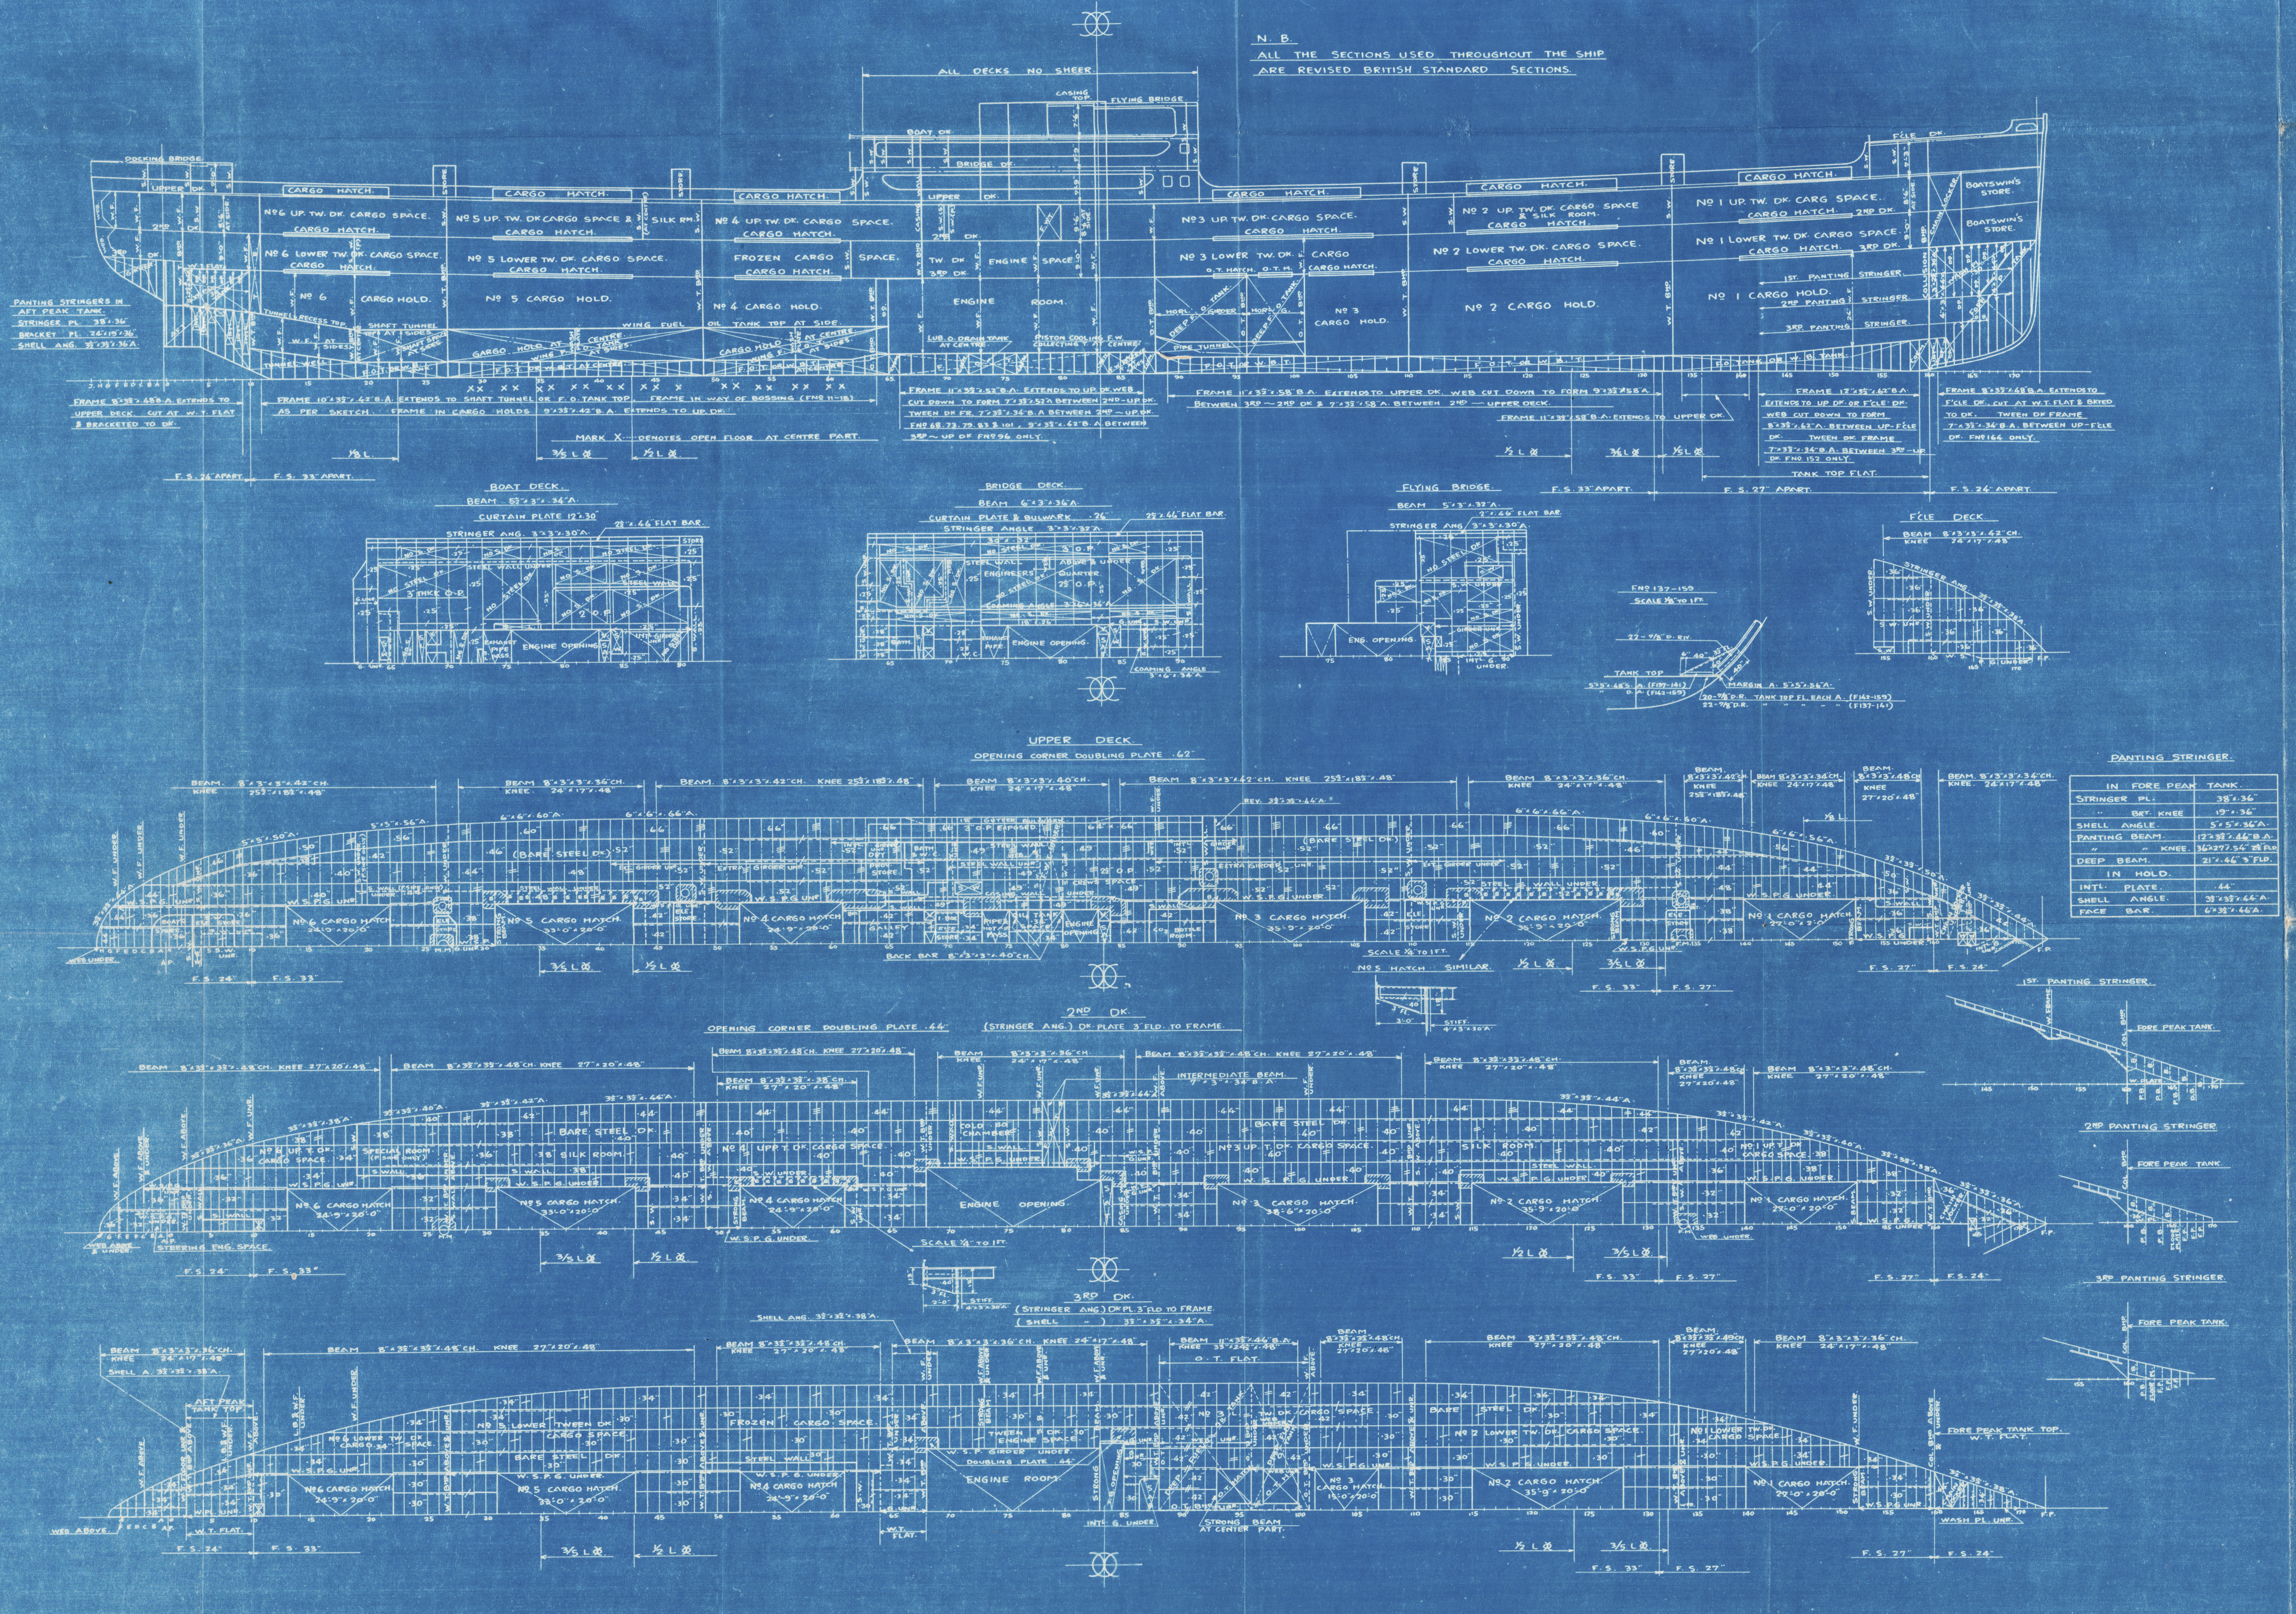

"KINAI MARU"

M.V. "TOKAI MARU".

Nagasaki Report No.1743.

"HOKUROKU MARU"

CONSTRUCTION PROFILE
& DECK PLAN.
SCALE ⅛ INCH TO 1 FOOT.
(445'-0" × 60'-6" × 40'-9")
(FINISHED PLAN)

NAGASAKI WORKS, MITSUBISHI ZOSENKAISHA, LTD. 三菱造船株式會社
NO. 17383
SHIP DESIGNING OFFICE
DATE AUG 18 1930
長崎造船所

June 19th 1930.

© 2020 Lloyd's Register Foundation
00820-0048-210-0064