

Lloyd's Register of Shipping.

SURVEYS FOR FREEBOARD.

(CONDITIONS OF ASSIGNMENT.)

Ship's Name **STEEL SINGLE SCREW TUG, "EMPIRE TITAN"**

Port of Survey **HULL.**


Official Number **167132**

Surveyor's Signature *J. Macleod*

Nationality and Port of Registry **BRITISH. HULL**

Date of Survey **WHILE BUILDING.**

Disposition and dimensions of superstructures, trunks, deckhouses and machinery casings to be inserted in the diagrams and tabular statement :-

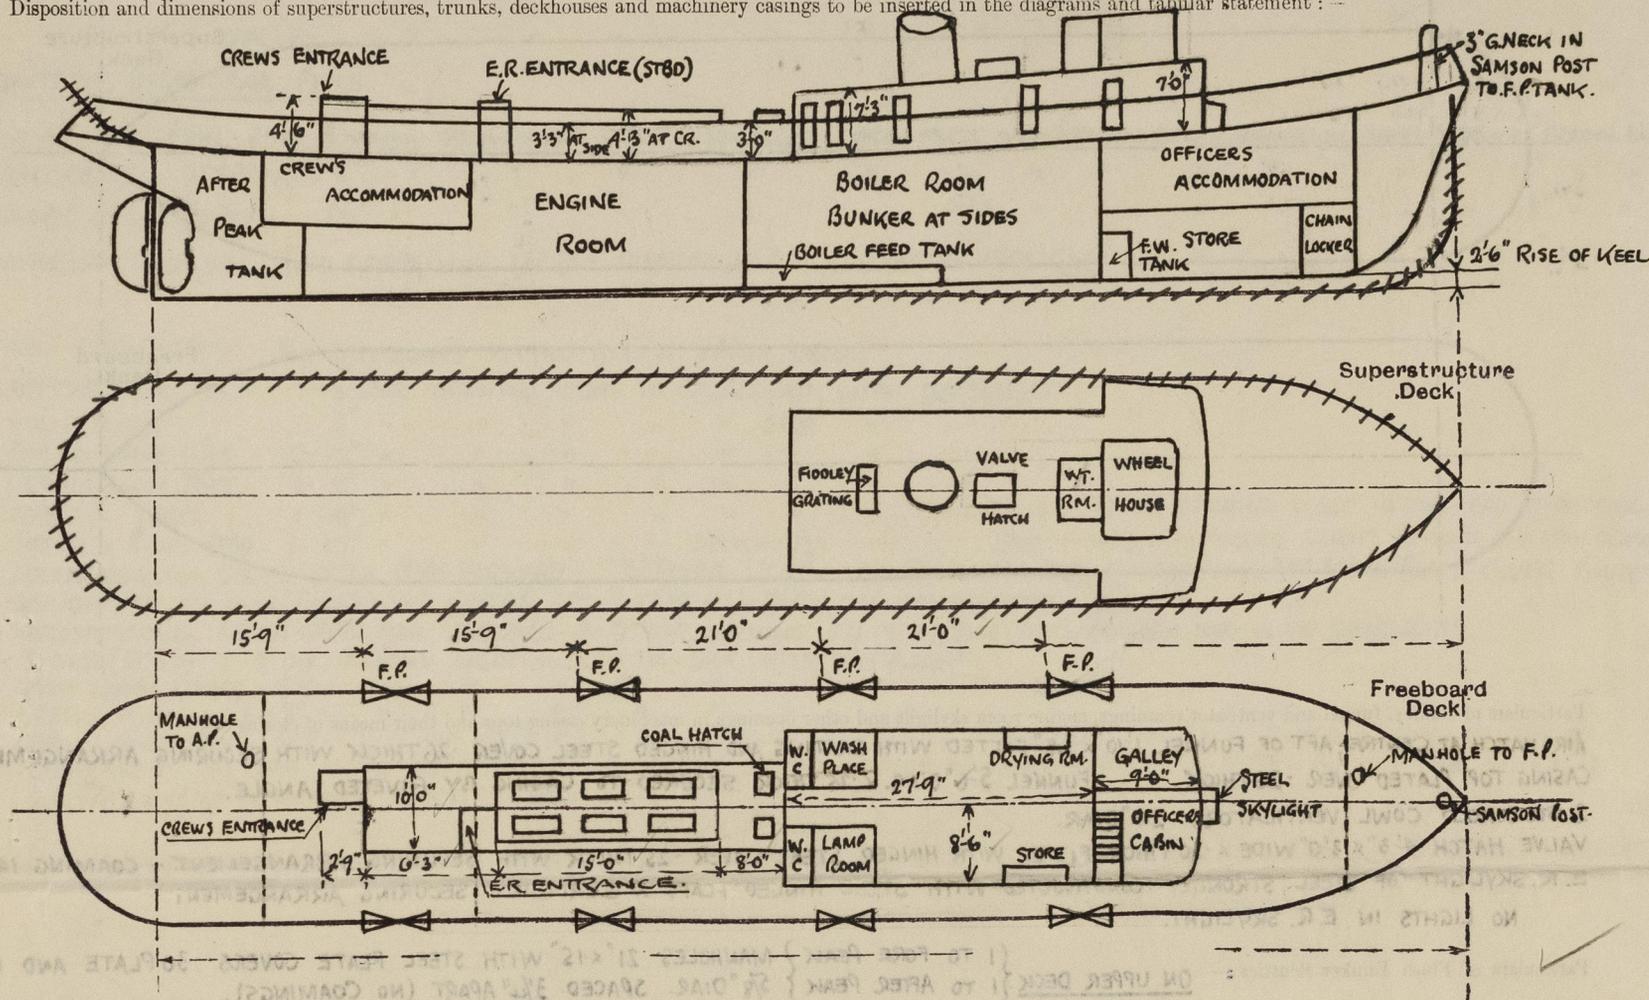

Particulars of Superstructures, Trunks, Casings, Deckhouses.

	Coaming	Plating	Stiffeners	Spacing	End Attachments of Stiffeners	Size of Openings	Height of Sills	Height of Casings
Poop Bulkhead								
Raised Quarter Deck Bulkhead								
Bridge, After Bulkhead								
Bridge, Forward Bulkhead								
Forecastle Bulkhead								
Trunk, Aft								
Trunk, Forward								
Exposed Machinery Casings on Freeboard or Raised Quarter Decks	18" x 31	26	6 x 3 x 3/8 B.A. IN WAY OF FUNNEL 3 x 2 1/2 x 28 T	23" to 28"	KNEES AT TOP	4' 11" x 23"	18"	7' 3"
Exposed Machinery Casings on Superstructure Decks								
Machinery Casings within Superstructures not fitted with Class I Closing Appliances								
Deckhouses on Flush Deck Ships	18" x 31	26	3" x 2 1/2" x 28 T	28"	KNEES AT TOP	4' 11" x 23"	18"	7' 0"

Particulars of Closing Appliances (state if capable of being manipulated from both sides).

Poop Bulkhead	
Raised Quarter Deck Bulkhead	
Bridge, After Bulkhead	
Bridge, Forward Bulkhead	
Forecastle Bulkhead	
Exposed Machinery Casings on Freeboard or Raised Quarter Decks	BOILER ROOM ENTRANCE (PORT & STBD) STEEL DOOR IN HALVES 4' 11" x 23" WITH SPRING LOCK & HANDLES BOTH SIDES STEEL DOORS PORT SIDE TO W.C. WASH PLACE & DRYING ROOM 4' 11" x 23" " " " " " " STEEL DOORS STBD SIDE TO W.C. LAMP ROOM & STORE ROOM 4' 11" x 23" " " " " " " SILLS 18" HIGH.
Exposed Machinery Casings on Superstructure Decks	
Machinery Casings within Superstructures not fitted with Class I Closing Appliances	
Deckhouses on Flush Deck Ships	STEEL DOOR PORT SIDE TO GALLEY, IN HALVES 4' 11" x 23" WITH SPRING LOCK & HANDLES BOTH SIDES. STEEL DOOR STBD SIDE TO OFFICERS CABIN 4' 11" x 23" " " " " " " SILLS 18" HIGH.

PARTICULARS OF PROTECTION TO OPENINGS, ETC.

HATCHWAYS ON FREEBOARD AND SUPERSTRUCTURE DECKS.

Description of Hatchway		2 COAL HATCHES (TRUNK TOP). (3'0" ABOVE UPPER DECK)	HATCH TO STORE AFT.
Dimensions of Hatchway		5'9" x 5'6"	2'6" x 2'6"
COAMINGS	Height above Deck	6"	18"
	Thickness	6 x 3" x 20 B.A.	9/16"
	Sides	✓	✓
	Ends	✓	✓
Stiffeners		✓	✓
Brackets, Stays		✓	✓
HATCH BEAMS	Number	(2 x 2)	"
	Spacing	"	"
	Scantling and Sketch	NONE.	NONE
	Bearing Surface	"	"
FORE AND AFTERS	Number	"	"
	Spacing	"	"
	Unsupported Lengths	"	"
	Scantling* and Sketch	NONE	NONE
Bearing Surface		"	"
HATCH COVERS	Material	PINE	PINE
	Thickness	2 1/2"	2 1/2"
	How fitted	F. & A.	THWART SHIPS
	Bearing Surface	3"	3"
Spacing of Cleats		24"	24"
Number of Tarpaulins		2	2
*Are wood fore and afters steel shod at all bearing surfaces?		✓	✓
Are battens and wedges efficient and in good condition?		Yes.	Yes.
Are tarpaulins in good condition and in accordance with rule requirements?		Yes.	Yes.
Are lashings provided in accordance with rule requirements?		✓	✓

Particulars of any special features:—

STEEL OUTWARK ALL FORE AND AFT 8'0" HIGH STRONGLY CONSTRUCTED

Endorsement at first survey and at surveys for renewal of Certificate:—

NONE

The fittings and appliances are in accordance with the particulars shown on this form (or as now modified) and are in good condition.

FOR POSITION SEE SKETCH ON PAGE 1.
7 1/2" ABOVE DECK



© 2021

Lloyd's Register Foundation