


No.	ALTERATION	BY	B. S. C.	DATE	APP.	DATE	APP.

EQUIPMENT
 1- 1/25 # BOWER ANCHOR (STOCKLESS)
 1- 560 # STREAM ANCHOR
 150 FATHOMS 1/8" STUD CHAIN CABLE
 HAWSERS & WARPS TO CLASS


*Equipment to be tested
 in sea trials*

NOTES
 RIVETING IN ACCORDANCE TO LLOYDS RULES.

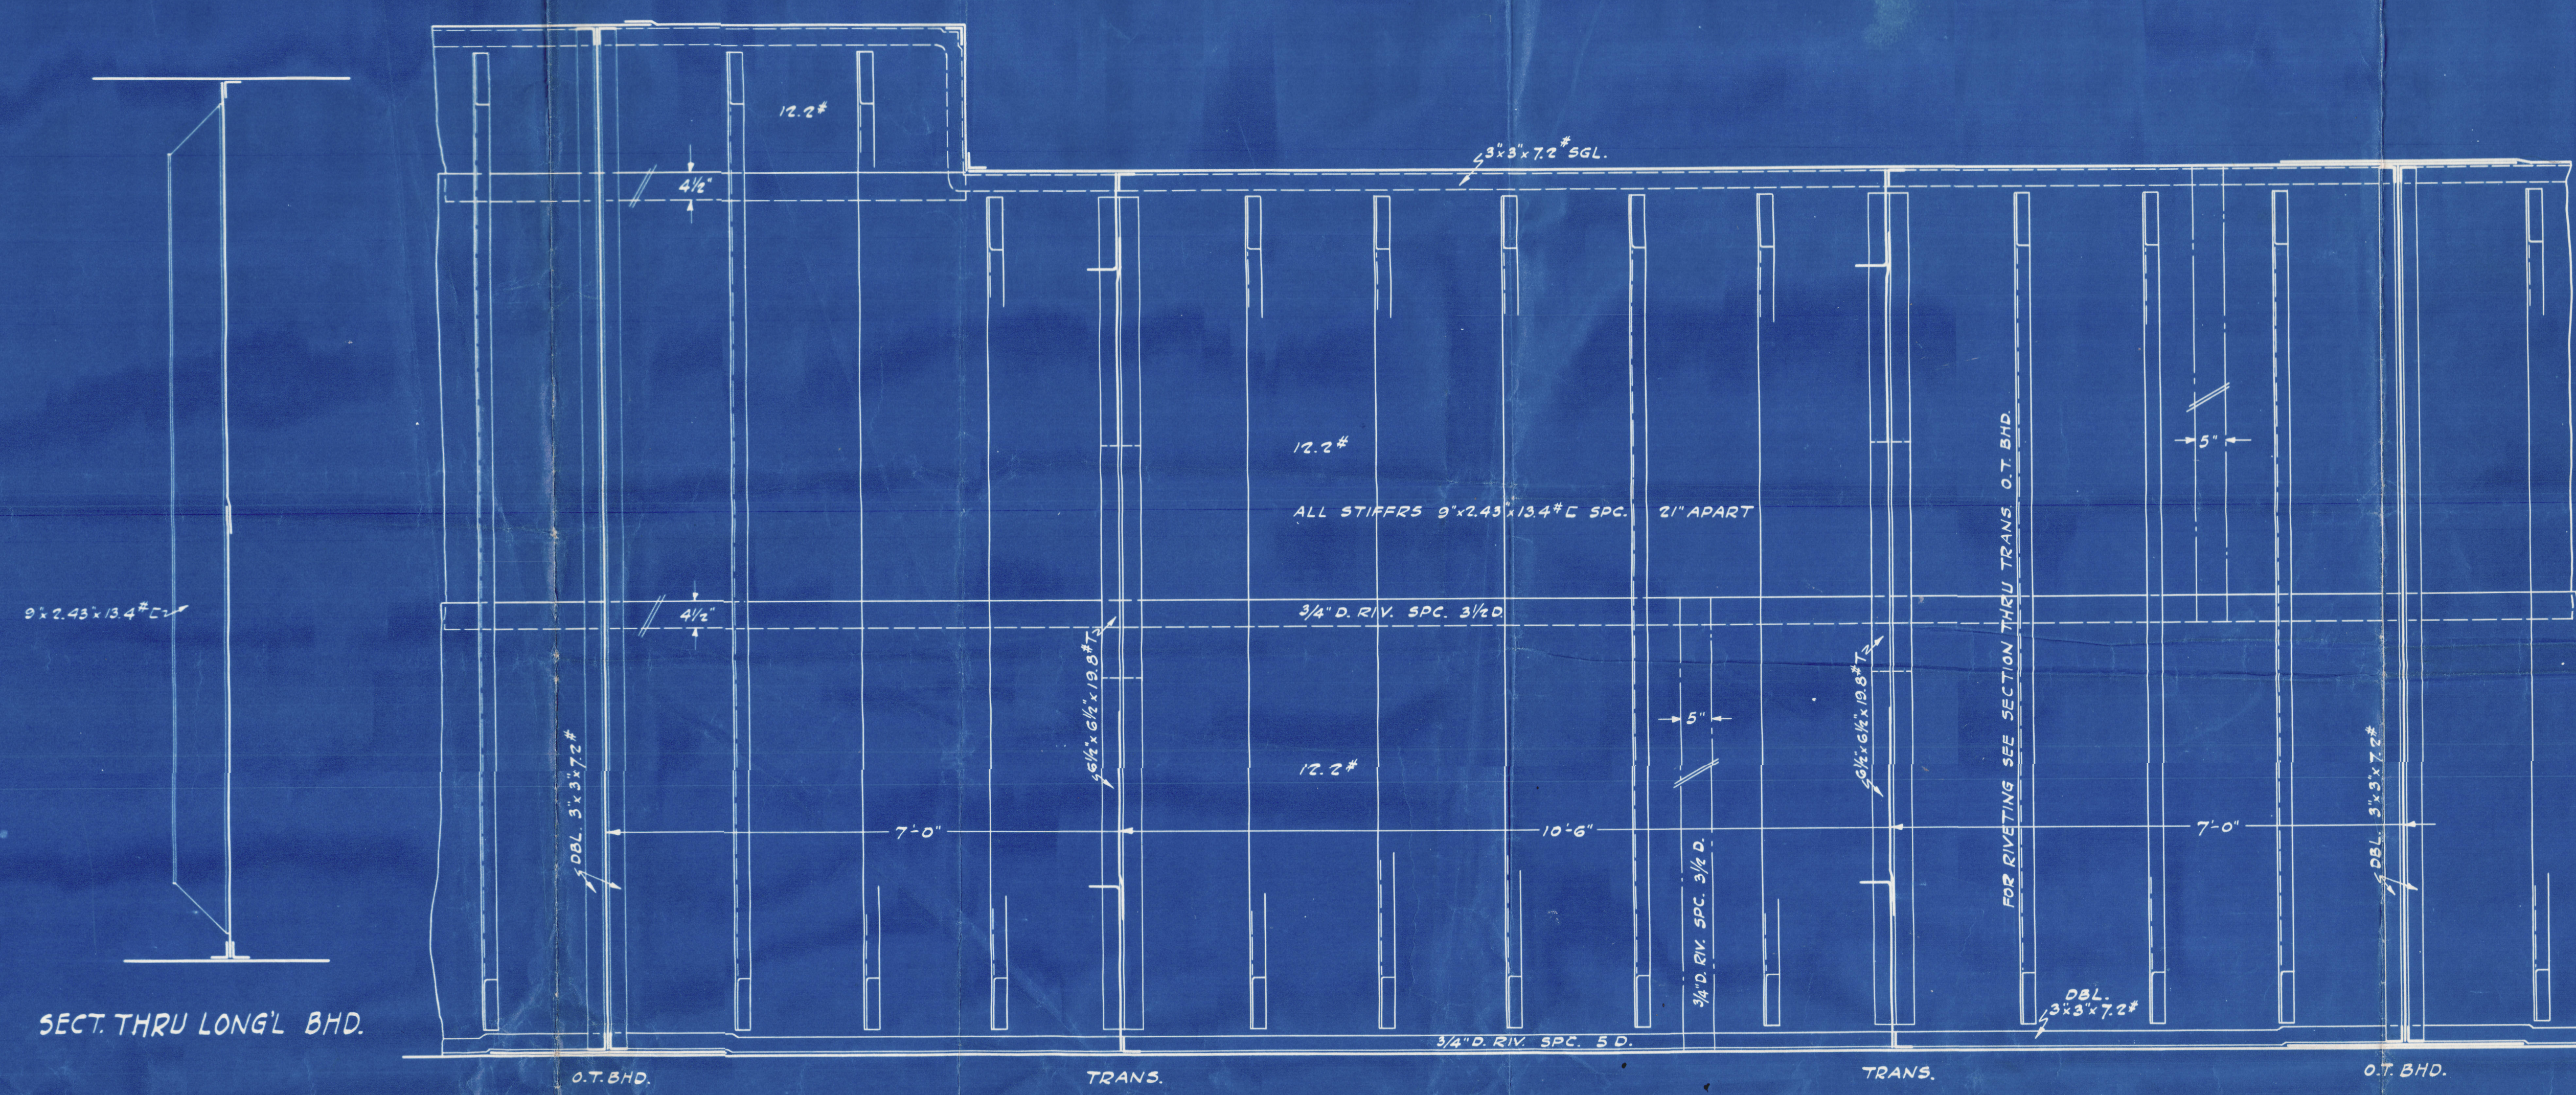


SECT. THRU LONG'L BHD.

TRANS. & BHD. AT TANK NO. 3 CONTINUOUS & O.T.

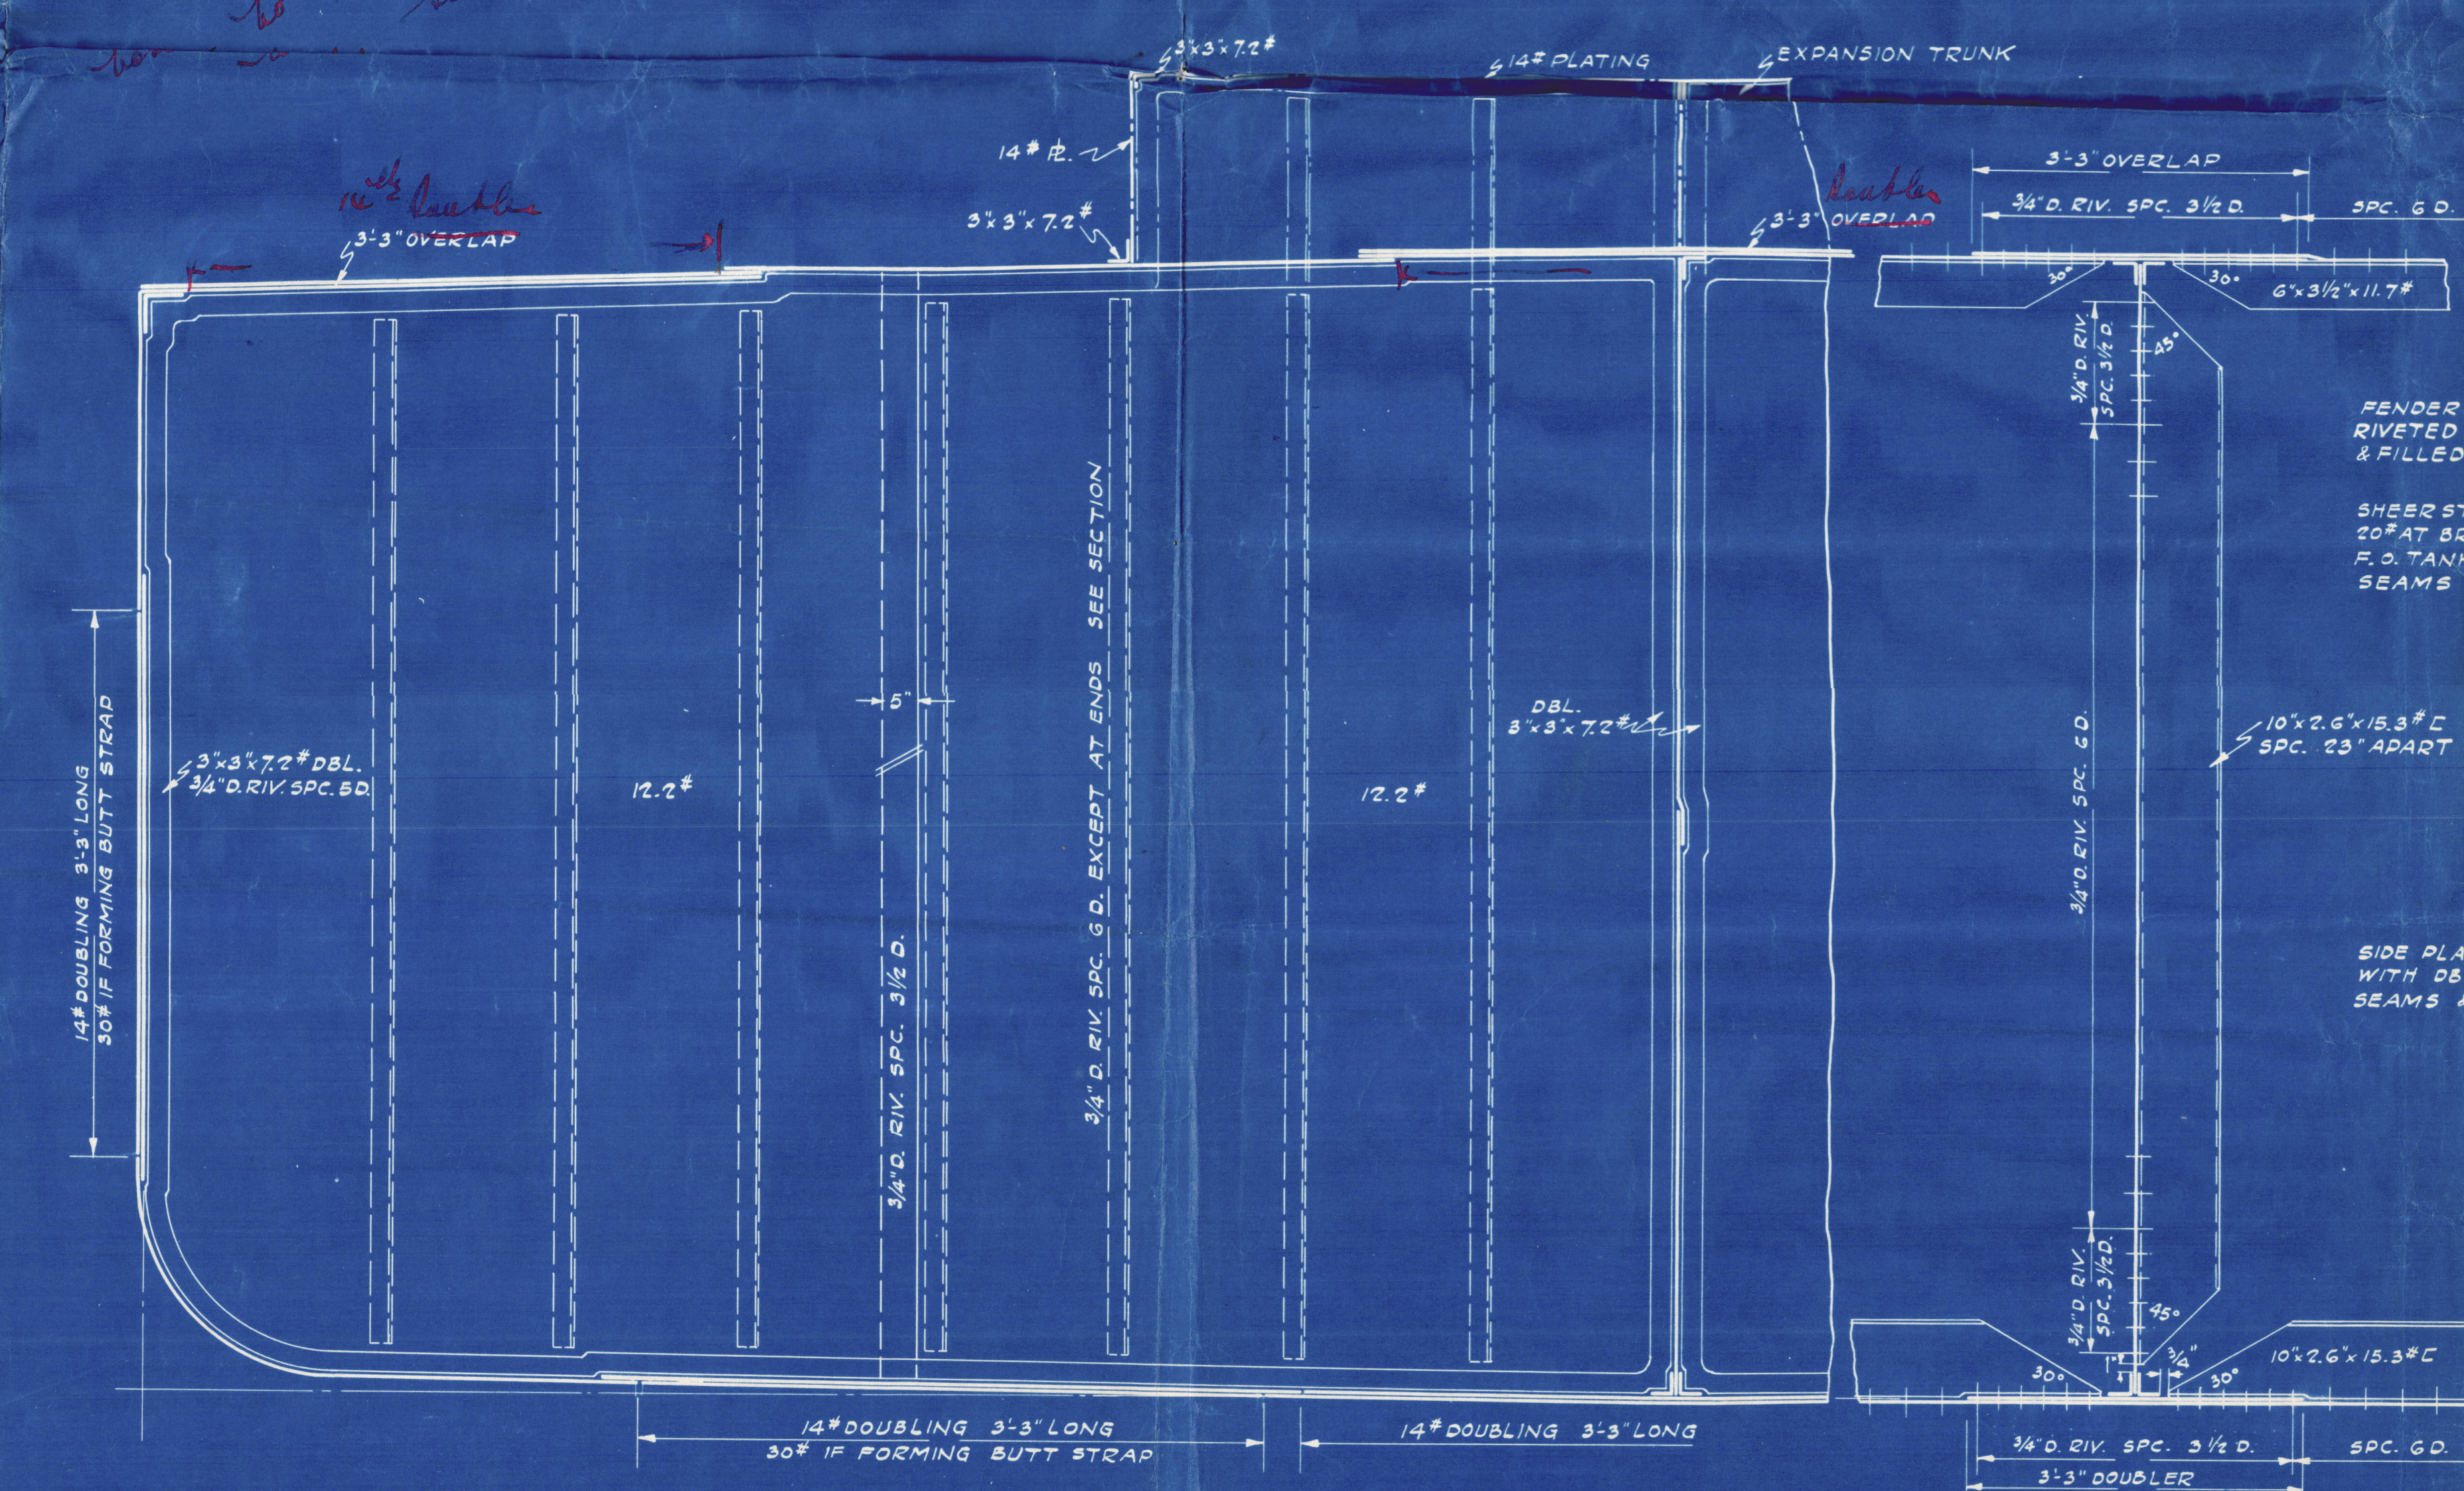

TRANS. O.T. BHD. #37, 40 & 43.
 LOOKING AFT.

SECT. THRU BHD.

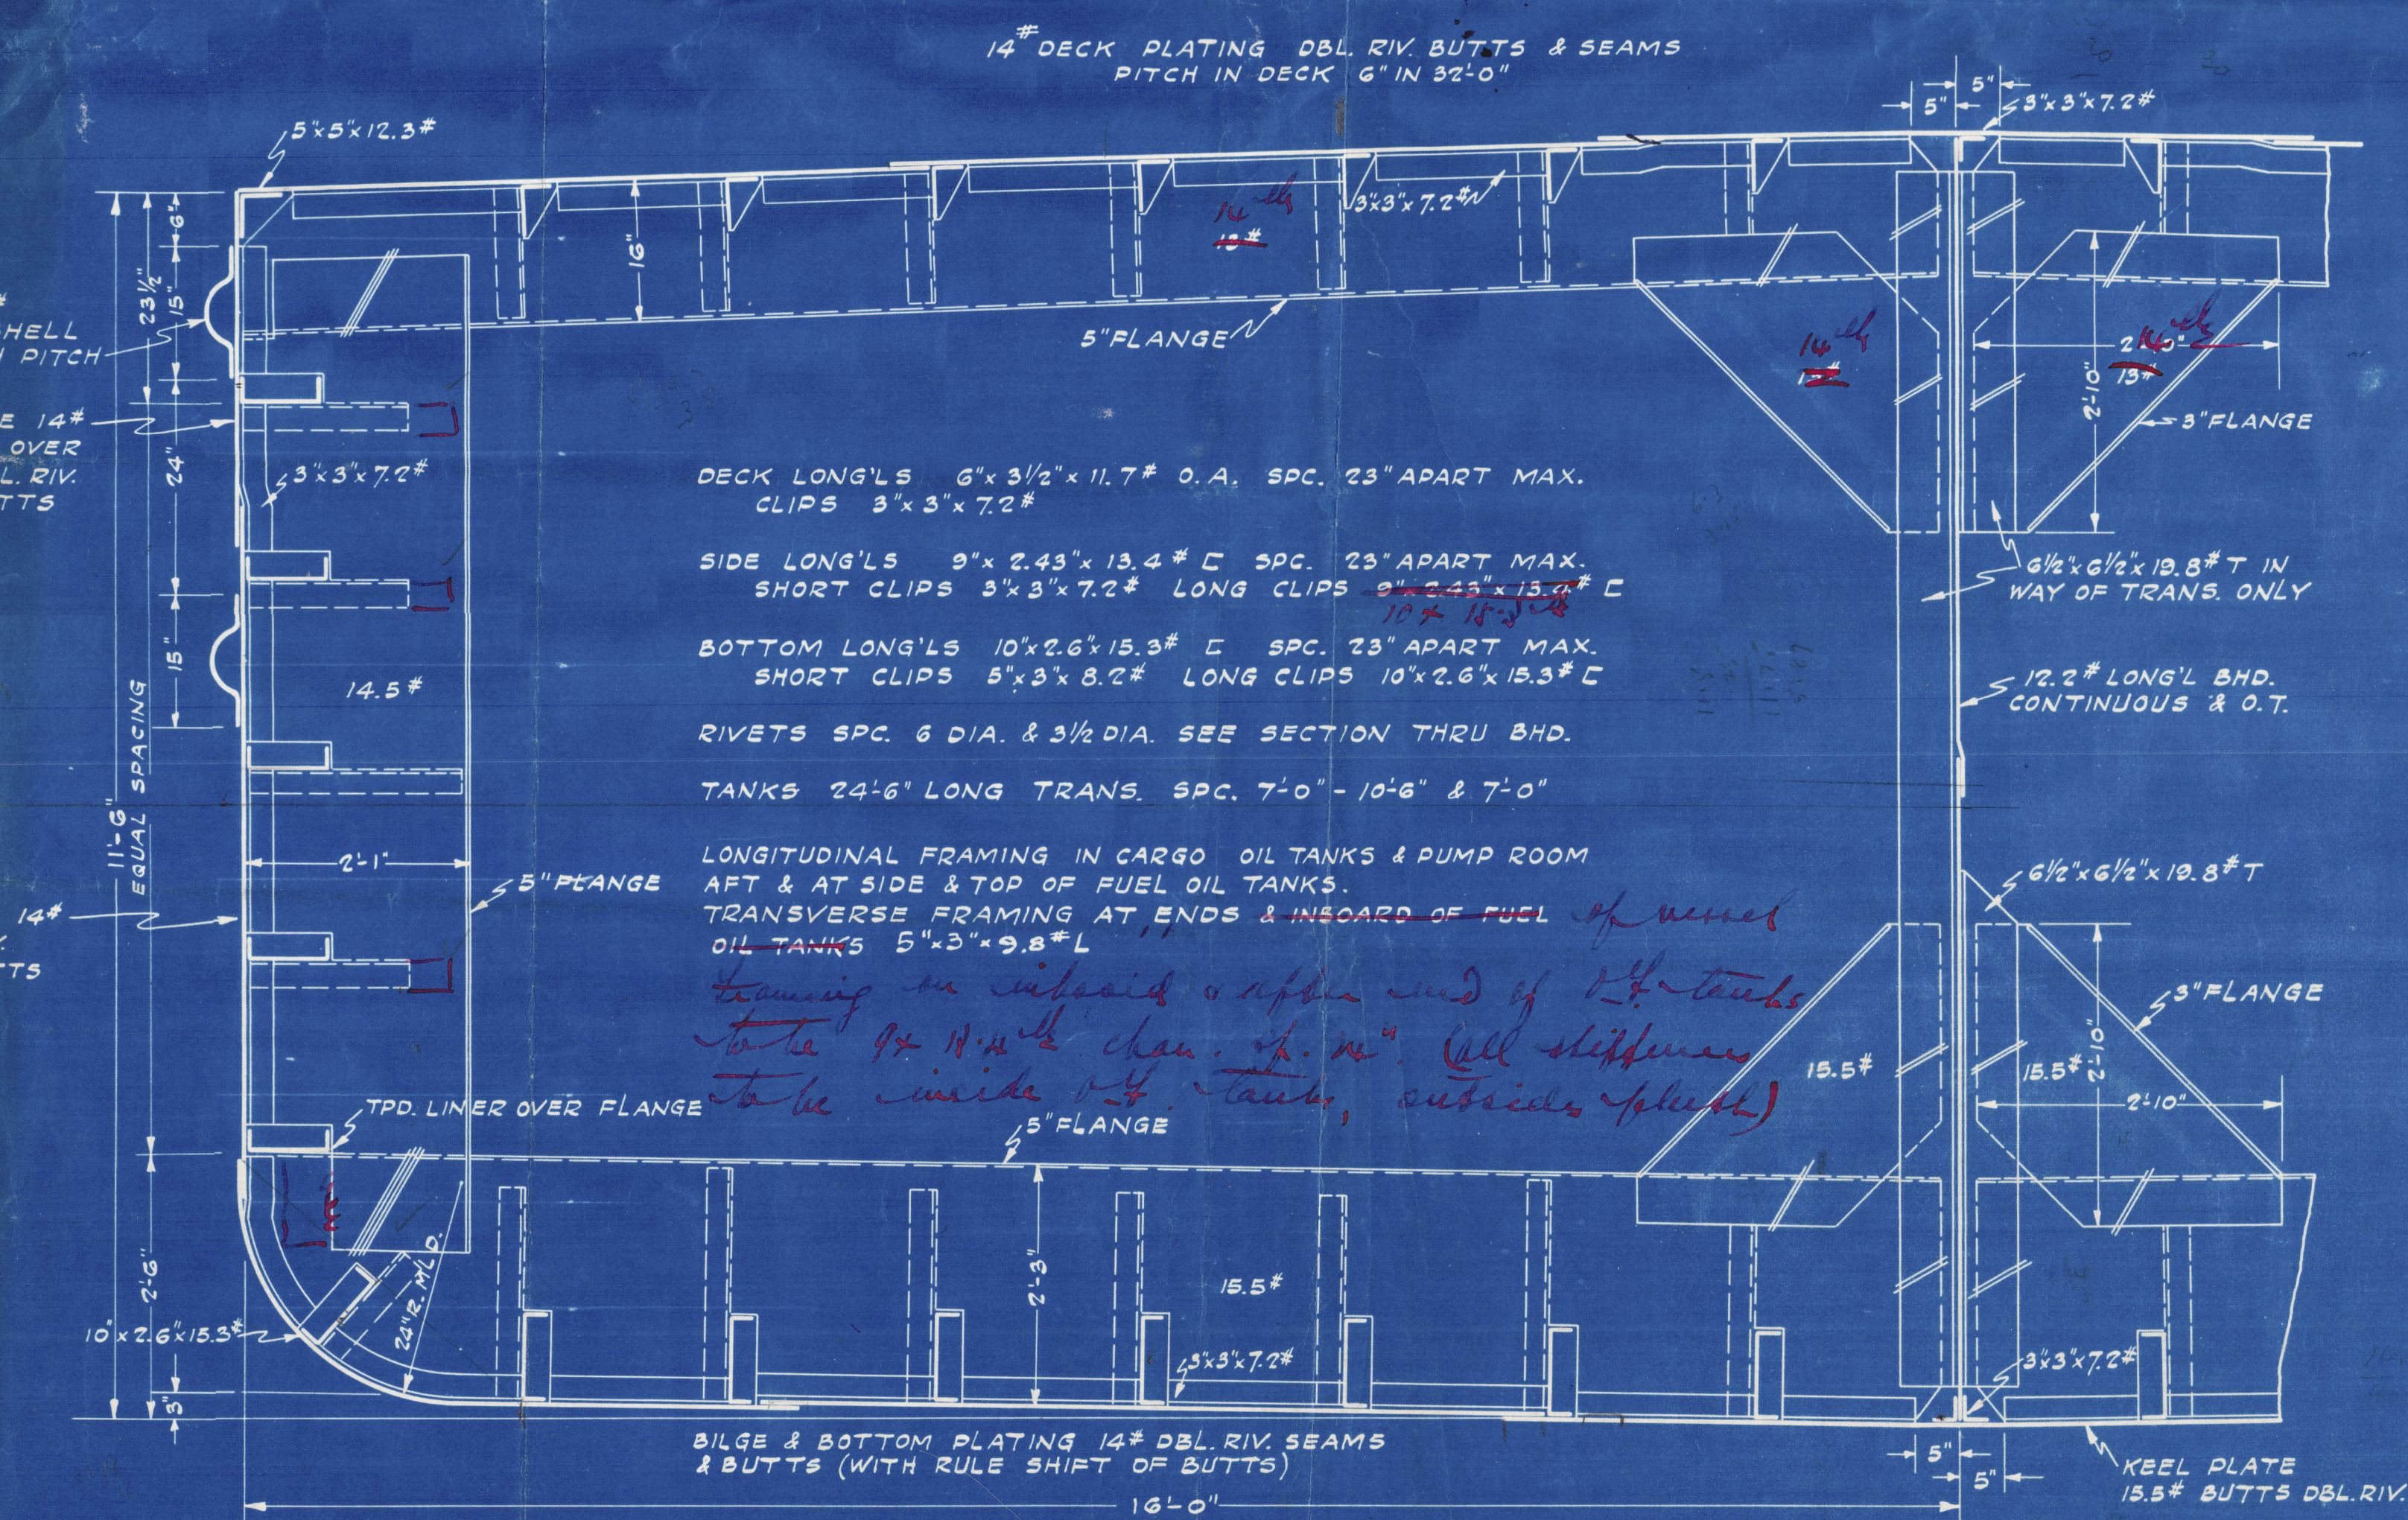

MIDSHIP SECTION
 TRANSVERSES #35, 36, 38, 39, 41, 42 & 44.
 LOOKING AFT.

DATE	
PRINTS	

APPROVED
 DEC 2 1922
 NEW YORK

1437	1436	NAME OF VESSEL
HULL NO.		BETHLEHEM SHIPBUILDING CORP., LTD.
		QUINCY, MASS.
		DEPARTMENT
TYPE SECTION		
TYPICAL O.T. BHDS.		
SCALE 3/4" = 1'-0"	DATE 27 NOV - 22	
DRAWN E.O.P. R.H.P.	APPROVED	
TRACED R.H.P.	APPROVED	
CHECKED	APPROVED	
JOB NO. 1436-122 & 125	PLAN NO. 36/2-1	

P "Y-126"

Reit 20
 Box 2538.