




PROFILE & DECK PLAN

STEEL SCREW TRAWLER

Nº 369

LENGTH 120'0" x 21'6" x 11'6"

SCALE $\frac{1}{4}" = 1$ FOOT.

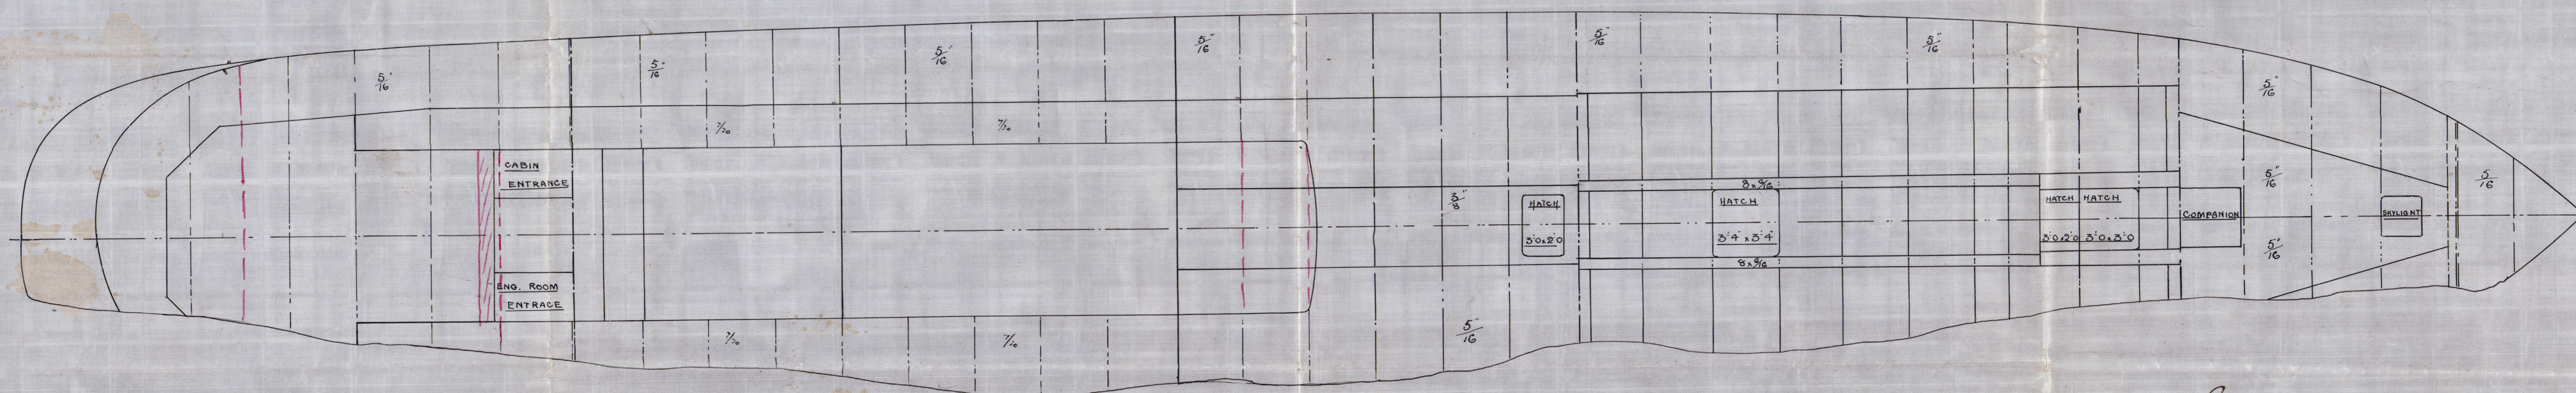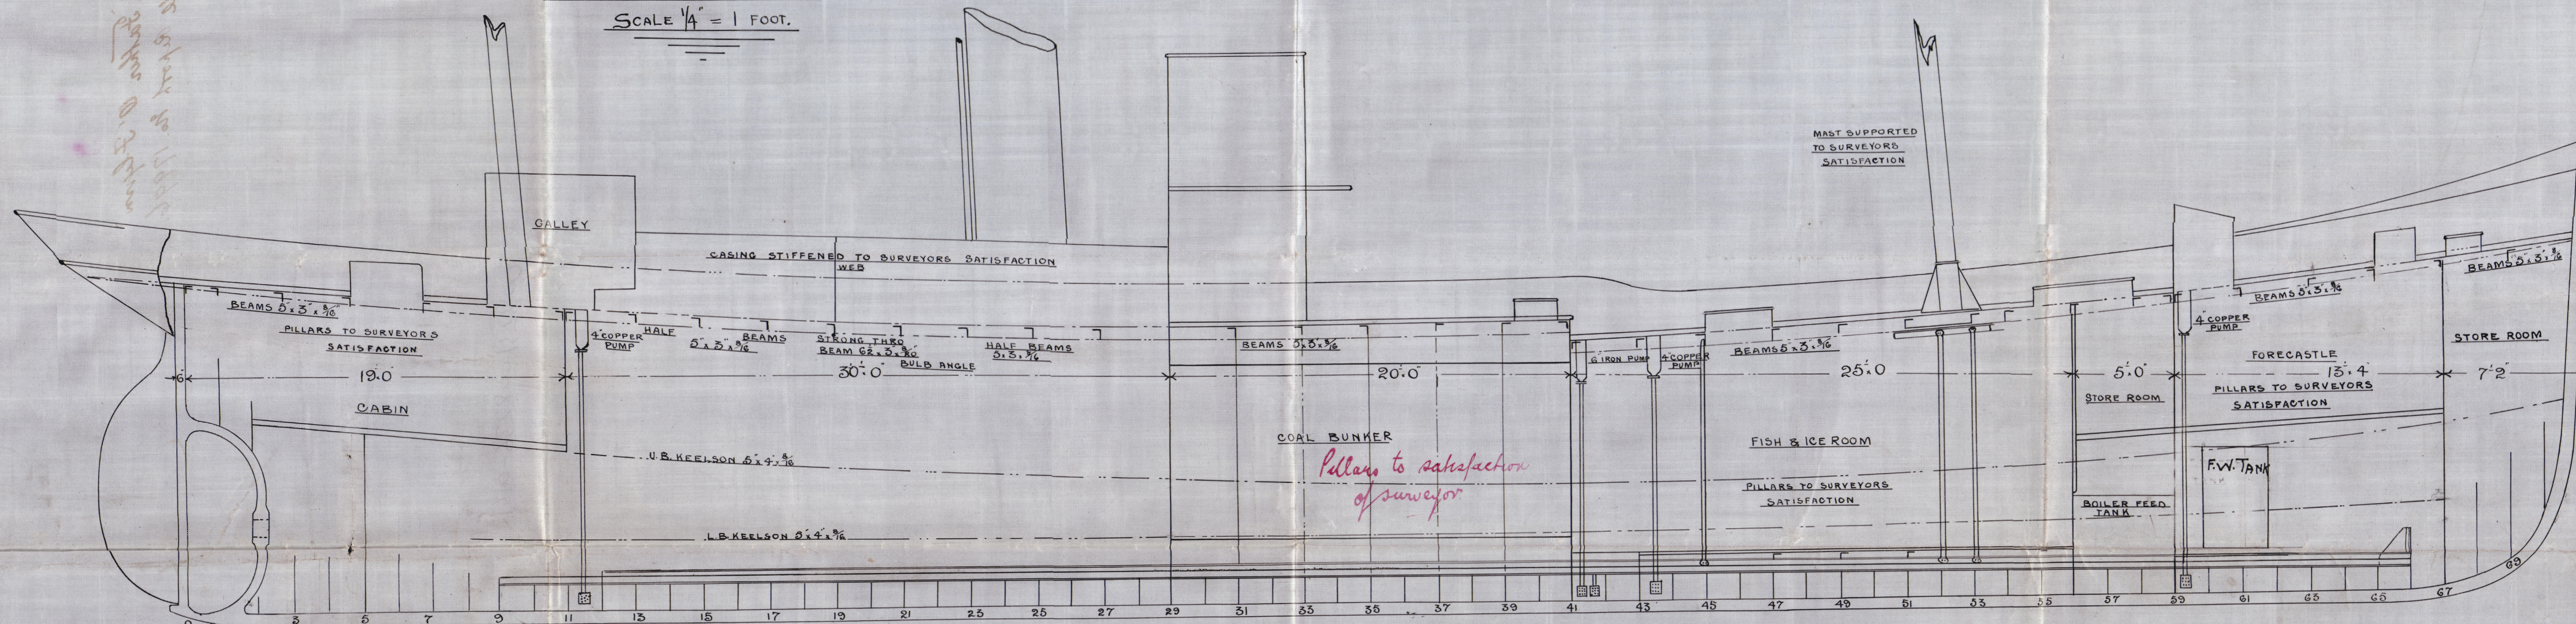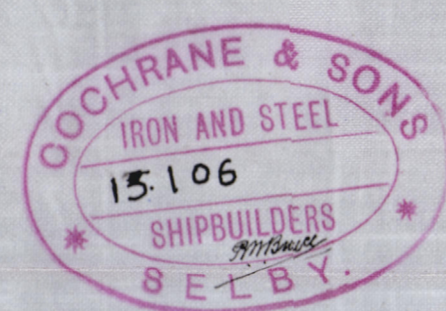

answ

Cochrane & Sons.


No. 369.

Profile & Deck Plan

Profile & Deck Plan.

18.1

S/s Father O'Flynn
Hull Report No. 17996.

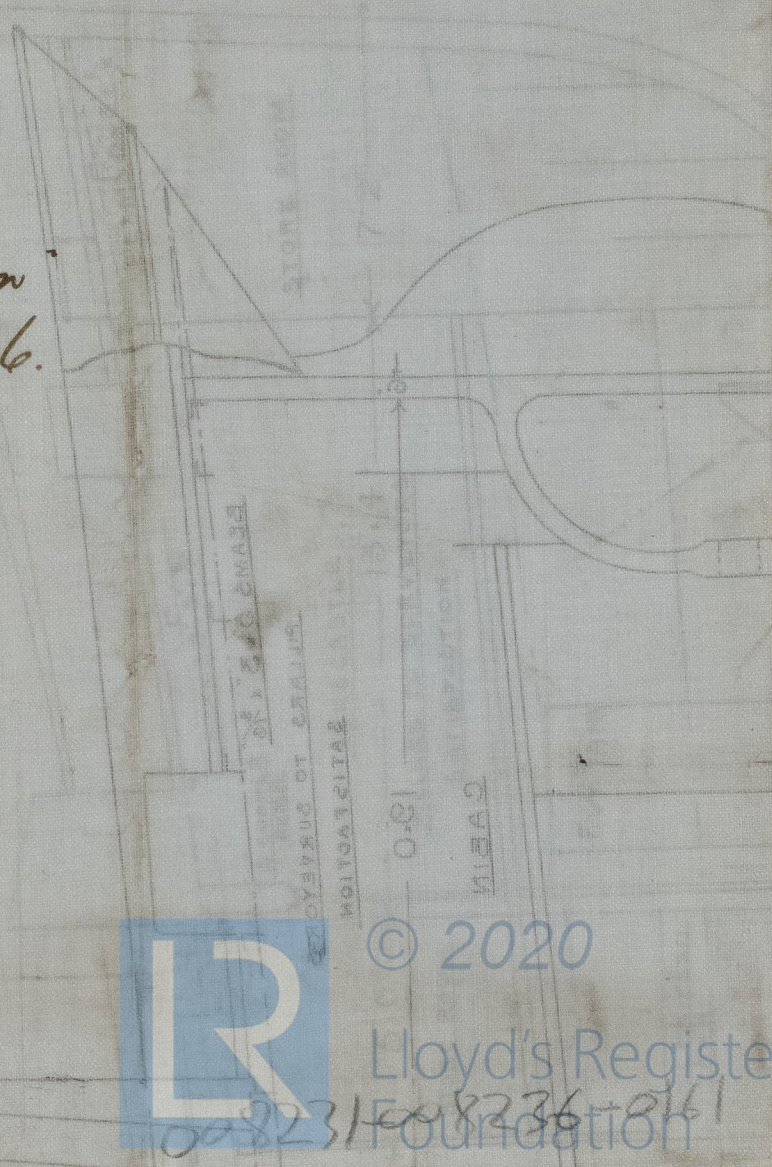

© 2020

Lloyd's Register

008231/008236-0161

Foundation

008231-008236-0161