


H.M WATER TANK VESSELS
 "FRESHWATER" & "FRESHET" "FRESHBROOK"
 GENERAL ARRANGEMENT & RIG
 YARD N^{os} 862/3 868
 SCALE: 1/4" = 1 FOOT
 LENGTH B.P. 120^{FT} 0^{INS} BEAM M.L.D. 24^{FT} 6^{INS}
 DEPTH M.L.D. 12^{FT} 6^{INS}

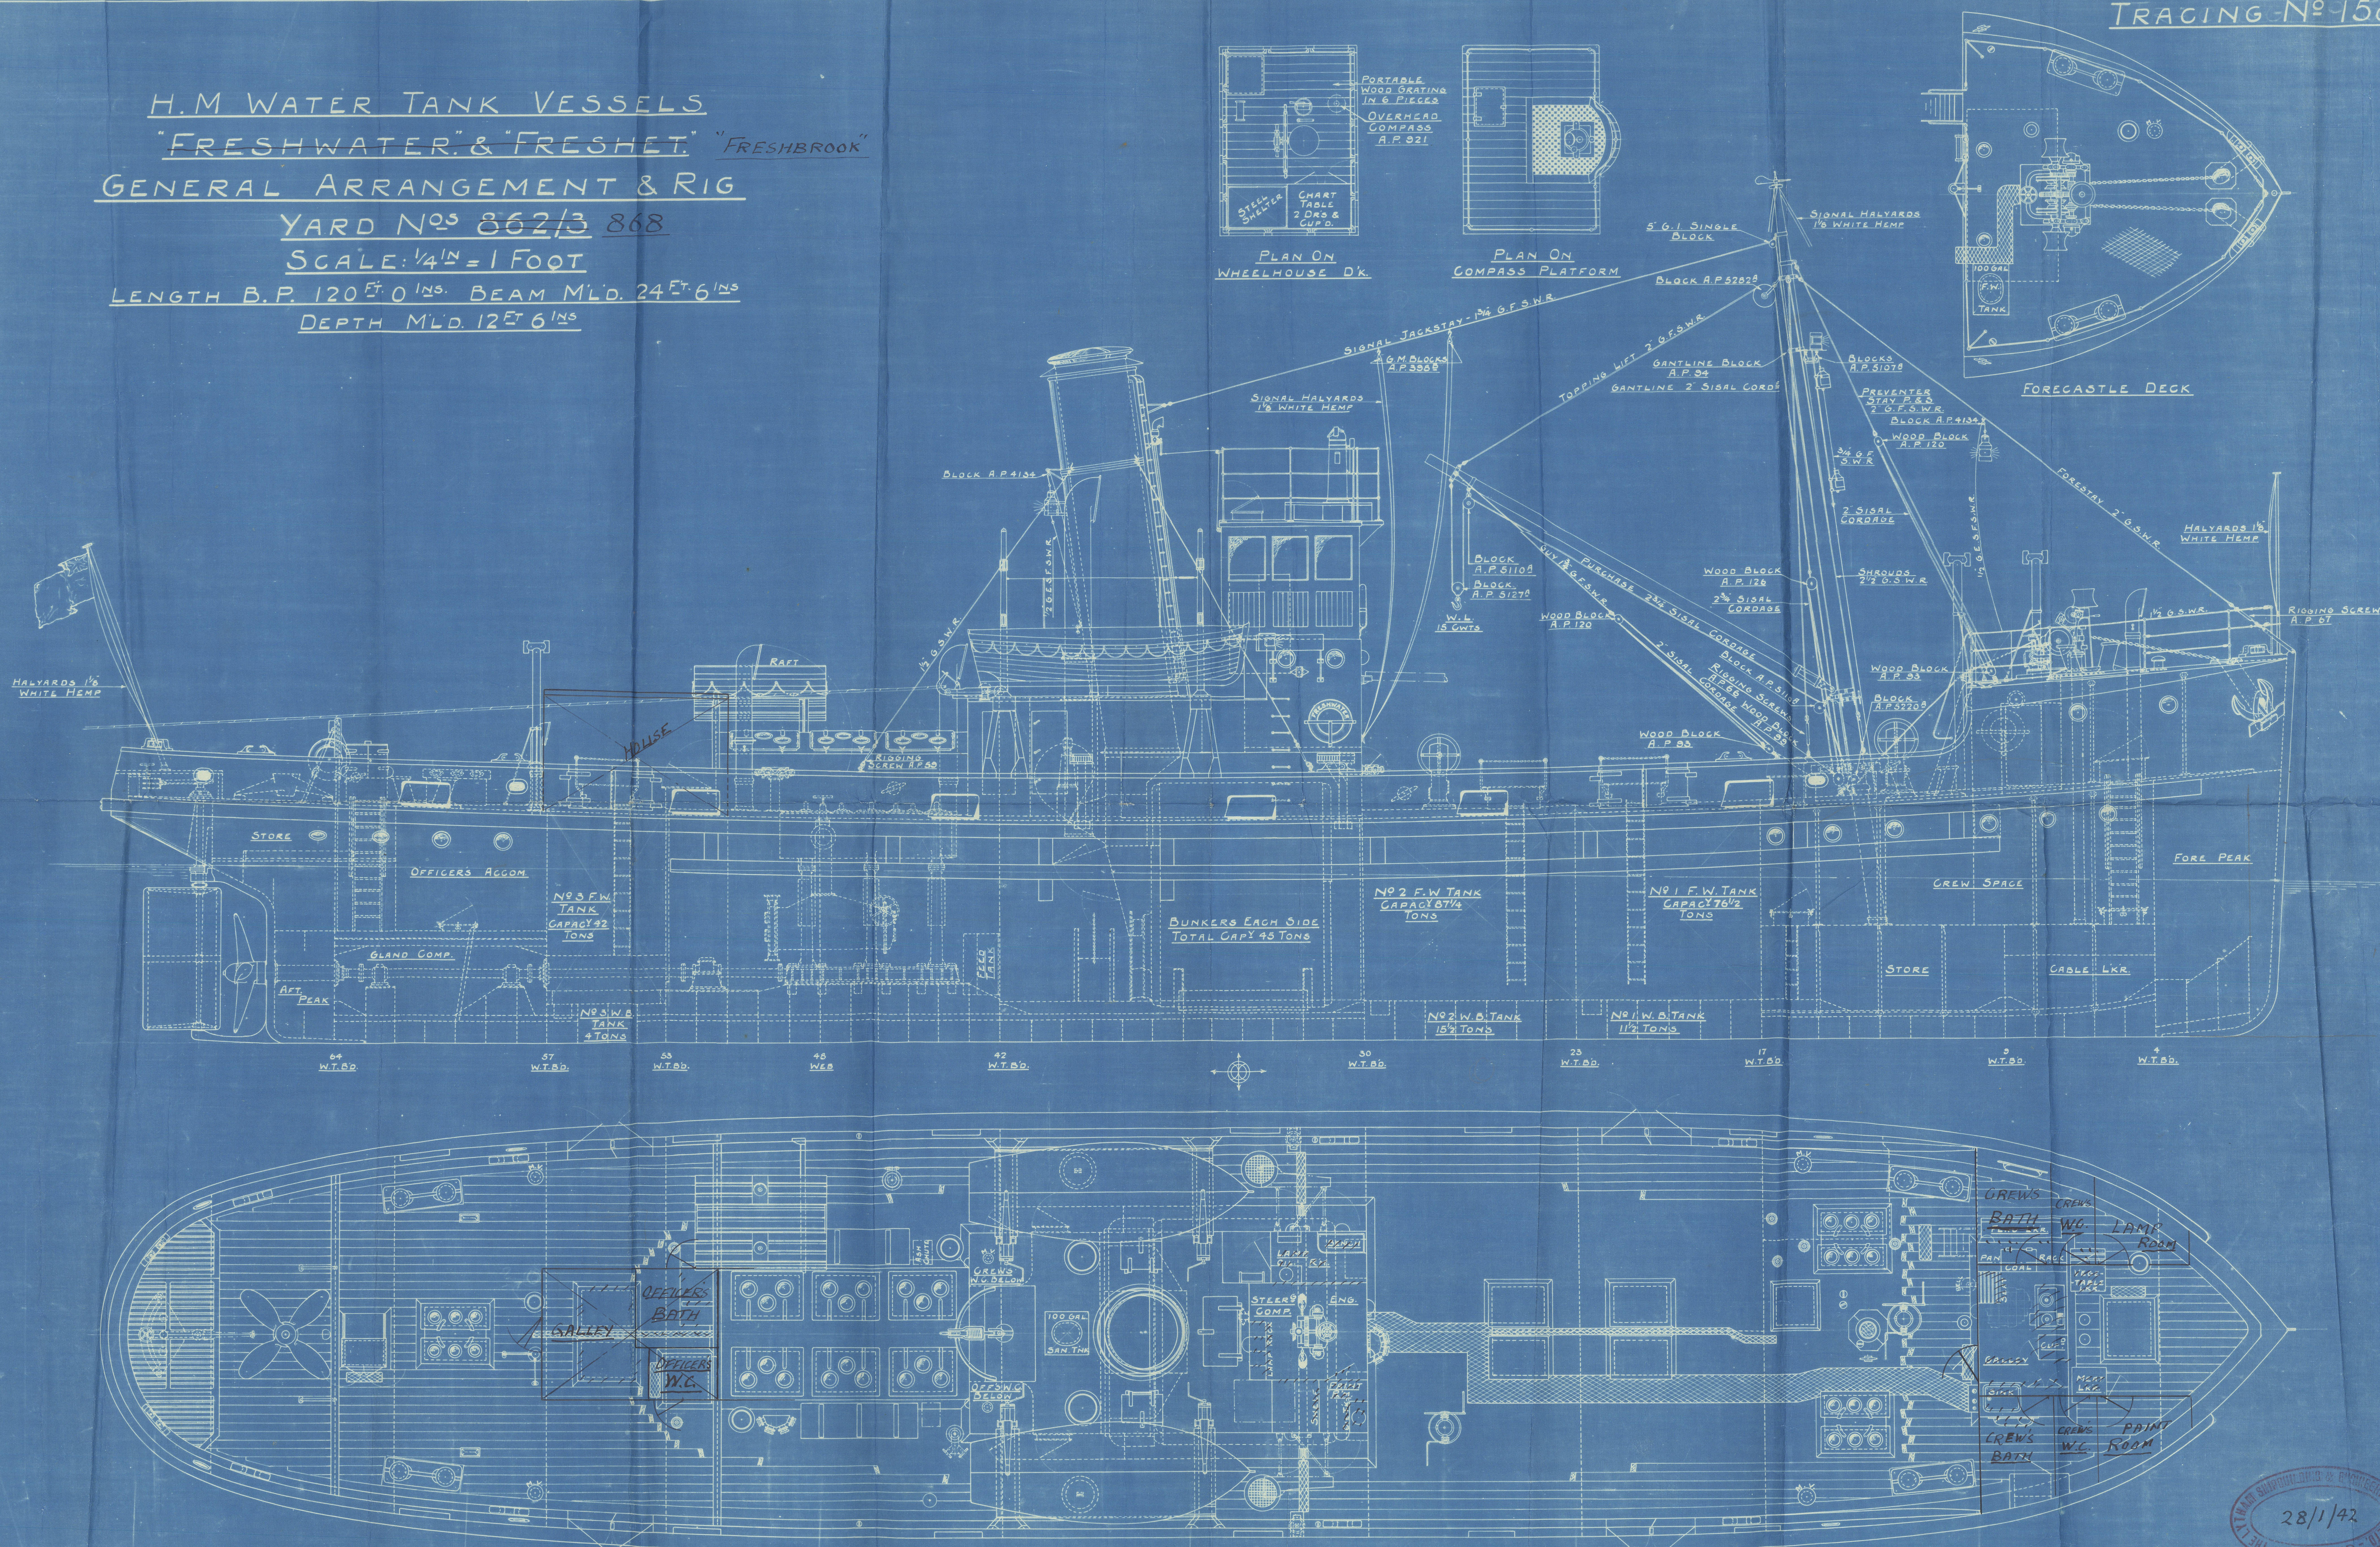

28/1/42

Freshbrook

General Arrangement

Amended Profile

Lytham S B & E Co Ltd

YAN^D 868 to 873

(H.M. Waterboats).



"FRESHBROOK"



© 2021

008237-008247-00461

Lloyd's Register
Foundation