


Lloyd's Register of Shipping.

SURVEYS FOR FREEBOARD.

(CONDITIONS OF ASSIGNMENT.)


Ship's Name "T.R.V. 6" Port of Survey HULL.
 Official Number ✓ Surveyor's Signature F. J. Palmer.
 Nationality and Port of Registry ✓ Date of Survey During construction.

Disposition and dimensions of superstructures, trunks, deckhouses and machinery casings to be inserted in the diagrams and tabular statement:—

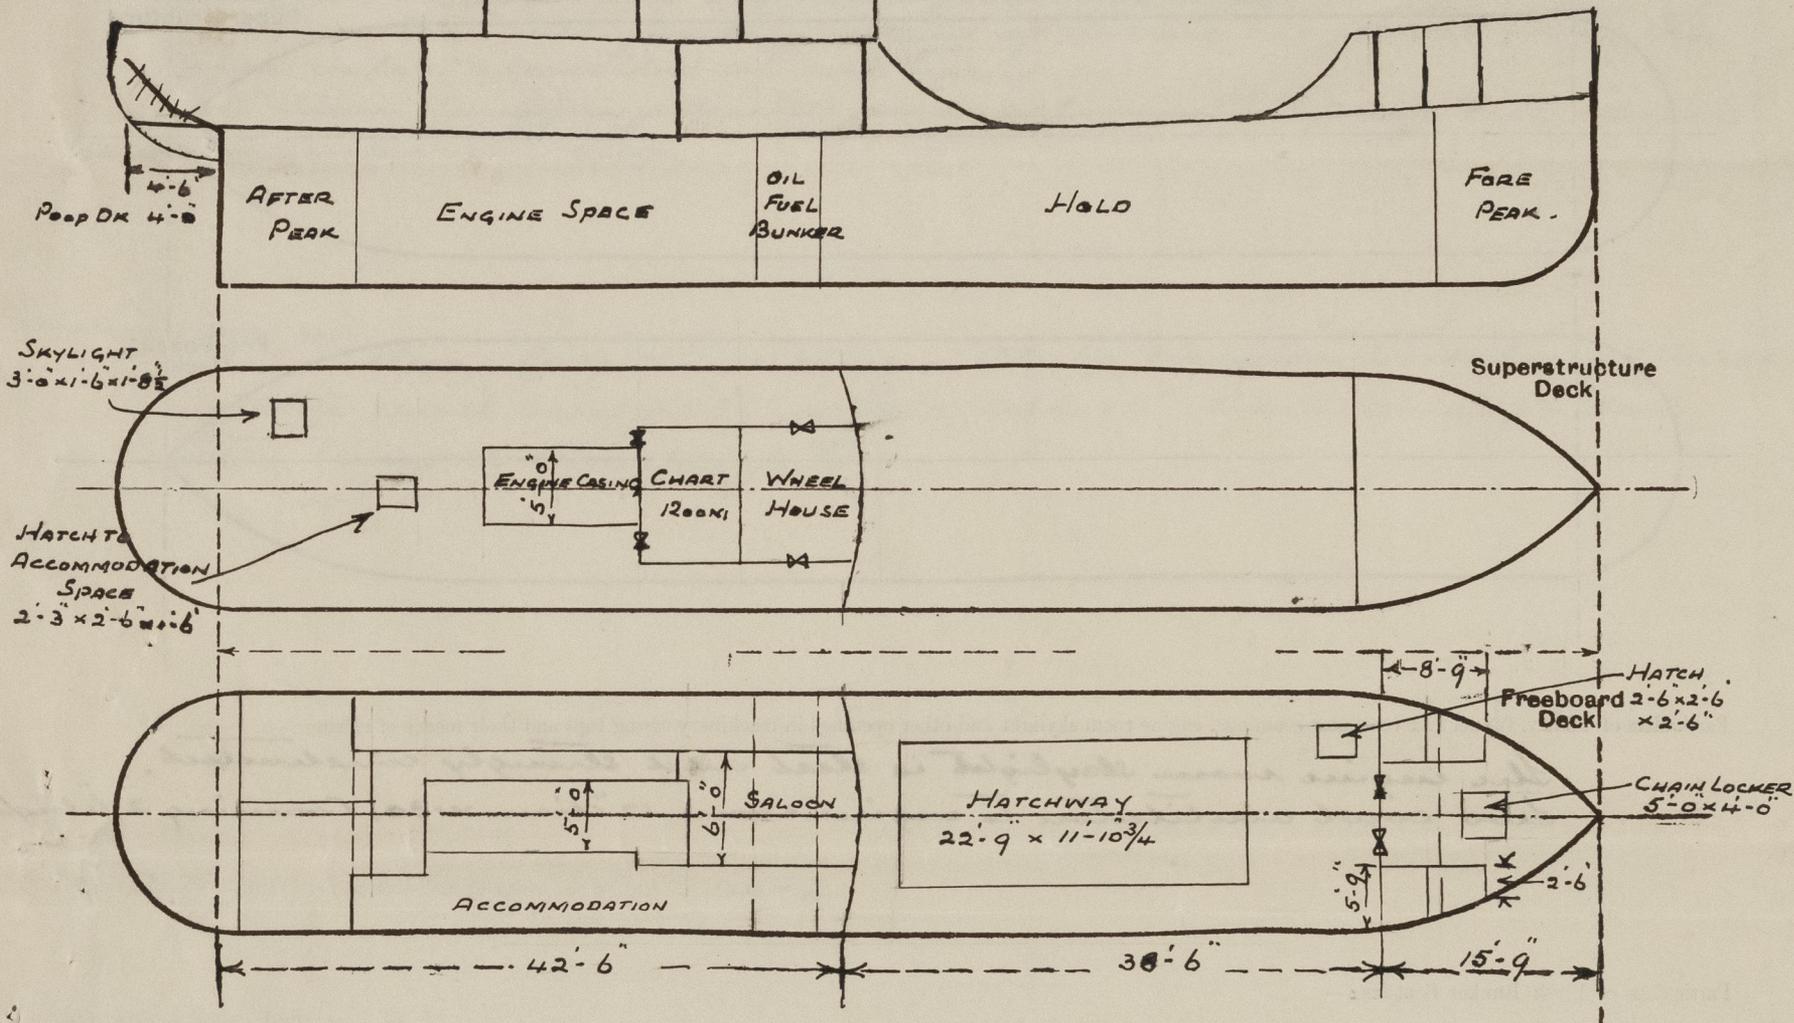


Particulars of Superstructures, Trunks, Casings, Deckhouses.								
	Coaming	Plating	Stiffeners	Spacing	End Attachments of Stiffeners	Size of Openings	Height of Sills	Height of Casings
Poop Bulkhead ...	✓	30	5 x 3 x 37 5/16	31	BKTS AT BOTTOM LUGS AT TOP	NONE	✓	7'-0
Raised Quarter Deck Bulkhead ...								
Bridge, After Bulkhead ...								
Bridge, Forward Bulkhead ...								
Forecastle Bulkhead ...	✓	20	2 1/2 x 2 1/2 x 25	25	NONE	TWO 4'-0 x 3'-6	15	6'-6
Trunk, Aft ...								
Trunk, Forward ...								
Exposed Machinery Casings on Freeboard or Raised Quarter Decks ...								
Exposed Machinery Casings on Superstructure Decks ...	✓	25	2 1/2 x 2 1/2 x 25	21	BKTS AT TOP ONLY.	TWO 4'-7 x 1'-9 (SS) ONE 4'-7 x 1'-9 (PL)	18	3'-0
Machinery Casings within Superstructures not fitted with Class I Closing Appliances ...								
Deckhouses on Flush Deck Ships ...								

Particulars of Closing Appliances (state if capable of being manipulated from both sides).	
Poop Bulkhead ...	✓
Raised Quarter Deck Bulkhead ...	
Bridge, After Bulkhead ...	
Bridge, Forward Bulkhead ...	
Forecastle Bulkhead ...	2 3/8" SHIFTING BOARDS IN ANGLES FORMING CHANNELS RIVETED TO BULKHEAD
Exposed Machinery Casings on Freeboard or Raised Quarter Decks ...	
Exposed Machinery Casings on Superstructure Decks ...	
Machinery Casings within Superstructures not fitted with Class I Closing Appliances ...	THREE HINGED STEEL DOORS OPERATED FROM BOTH SIDES; TWO HORIZONTAL SLIDING STEEL DOORS TO WHEELHOUSE 5'-6 x 1'-10"
Deckhouses on Flush Deck Ships ...	

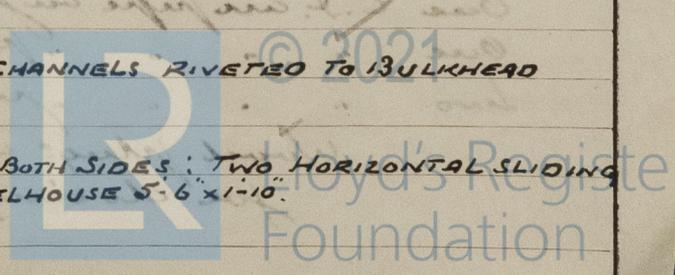

PARTICULARS OF PROTECTION TO OPENINGS, ETC.

The following diagrams should be used to indicate the positions of cargo and coaling hatchways, gangway, cargo and coaling ports, ventilators, companionways, etc., which would affect the seaworthiness of the ship:—

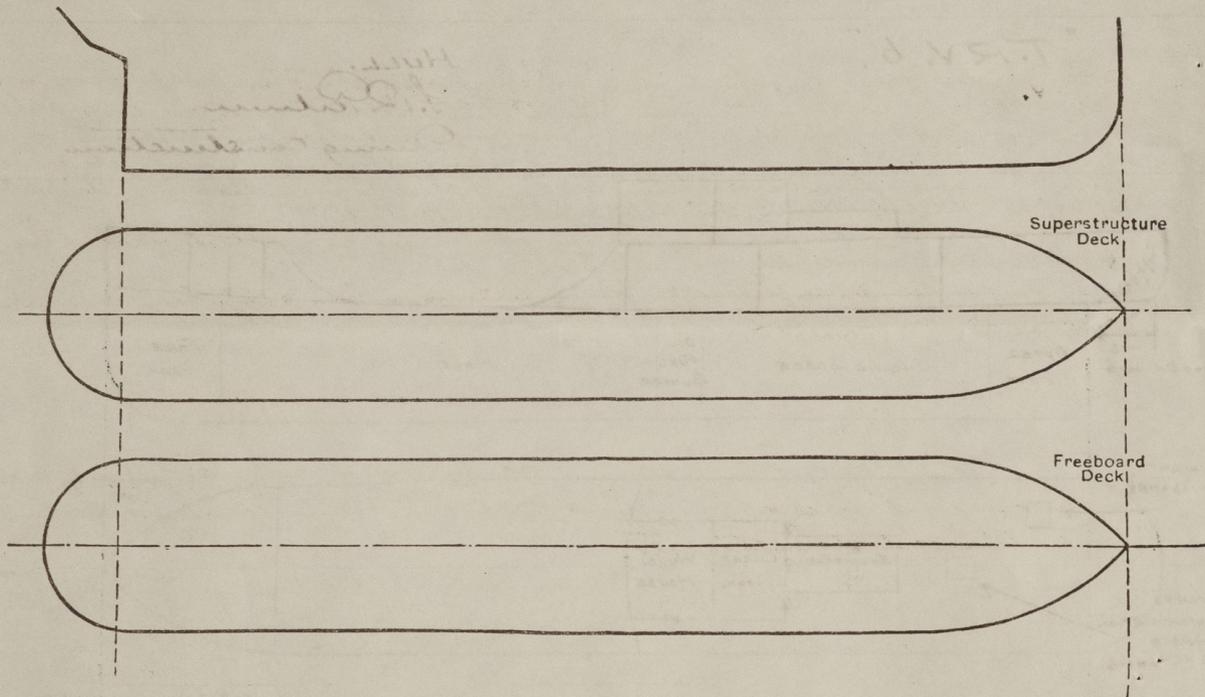

Particulars of fiddle, funnel and ventilator coamings, engine room skylight and other openings in machinery casing tops and their means of closing:—

The engine room skylight is steel and strongly constructed. Two cowl ventilators to engine room 12" diam x 30". Coaming 2.6 high.

Particulars of Flush Bunker Scuttles:—

None ✓

Particulars of Companionways:—

None.

Particulars of Ventilators in exposed positions on freeboard and superstructure decks:—

Two ventilators on fore deck 6" diam, coaming 36" led to fore space.
Two " " " foreboard " 12" " " 36" " " hold
Four " " " poop " 6" " " 30" " " poop space.

All ventilators are constructed in accordance with the Rules and provided with wood plugs and canvas cover.

Particulars of Air Pipes in exposed positions on freeboard, raised quarter, or superstructure decks:—

One C.I. air pipe on fore deck 2.0 high x 3" diam to F.P. tanks.
One " " " poop " 1.6 " x 3 " " A.P. "
Two " " " foreboard " 3.3 " x 2.2 " " F.W. tanks

Wood plugs with chain attachments are provided for closing the openings.

Particulars of Gangway Cargo and Coaling Ports:—

None ✓

Particulars of Scuppers and Sanitary Discharge Pipes:—

2-4" diam discharge (sanitary) pipes from W.C.'s in poop space on port side, two automatic non-return valves fitted to each discharge, ship's side valve (gun metal) about 2.0 below freeboard deck in machinery space. 4 (ps) and 2 (ss) 1.2" diam scupper pipes from galley and wash places in poop, two automatic non-return valves fitted to each discharge, ship's side valve (gun metal) about 2.0 below freeboard deck. All valves with positive means of closing are fitted with the upper valve accessible at all times. 2-3" diam scupper pipes (ss) from alleyway in poop led direct to engine room bilge.

Particulars of Side Scuttles:—


Nine (ps) and eleven (ss) to accommodation space in poop and one (ps) in fore, all 10" diam and fitted with hinged deadlights.

Vertical distance of Sill of lowest Side Scuttle above top of keel

14'-2"

Particulars of Guard Rails:—

Fixed round fore (poop) and hinged at sides of freeboard deck.

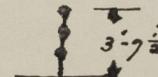

Particulars of Gangways, Lifelines, etc.:—

Lifelines fitted from poop to fore (ps).

Particulars of Freeing Arrangements.

	Length of Bulwark	Height of Bulwark	Size of Freeing Ports	Number each side	Area each side	Rule area each side
After Well						
Forward Well						

None ✓


State position of each freeing port (After Well:—

(F. and A. position and height above deck edge) (Forward Well:—

State whether the freeing ports are fitted with shutters, bars, or rails, and give particulars of such:—

Additional area where sheer is less than standard.

PARTICULARS OF PROTECTION TO OPENINGS, ETC.

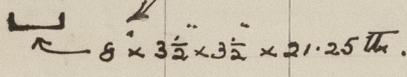		HATCHWAYS ON FREEBOARD AND SUPERSTRUCTURE DECKS.								
		FREEBOARD DK	POOP DK							
Description of Hatchway	...	MAIN	HATCH TO STORE	TO ACCOMMODATION SPACE						
Dimensions of Hatchway	...	22'-9" x 11'-10 3/4"	2'-6" x 2'-6"	2'-3" x 2'-6"						
COAMINGS	Height above Deck	2'-4"	2'-6"	1'-6"						
	Thickness { Sides	.375 ✓	.375 ✓	.375 ✓						
	{ Ends									
	Stiffeners	6 x 3 x .33 / 20.								
Brackets, Stays	4 EACH SIDE.									
HATCH BEAMS	Number									
	Spacing									
FORE AND AFTERS	Scantling and Sketch	✓	✓	✓						
	Bearing Surface									
	Number	3 (FIXED)								
	Spacing									
HATCH COVERS	Unsupported Lengths									
	Scantling and Sketch	 8' x 3 1/2" x 3 1/2" x 21.25 TH.								
	Bearing Surface									
	Material	STEEL TOP	HINGED STEEL							
HATCH COVERS	Thickness	3/8"								
	How fitted	WITH 24	PLATE COVERS							
	Bearing Surface	HINGED STEEL	PLATE COVERS (W.T.)							
Spacing of Cleats	...	1/4" (W.T.)								
Number of Tarpaulins	...	✓								

- Are wood fore and afters steel shod at all bearing surfaces? ✓
- Are battens and wedges efficient and in good condition? ✓
- Are tarpaulins in good condition and in accordance with rule requirements? ✓
- Are lashings provided in accordance with rule requirements? ✓

Particulars of any special features:—

Endorsement at first survey and at surveys for renewal of Certificate:—

The fittings and appliances are in accordance with the particulars shown on this form (or as now modified) and are in good condition.



© 2021

Lloyd's Register Foundation