

No 133-4.

# CONSTRUCTION PROFILE DECKS


## & INNER BOTTOM PLAN

SCALE 1/8" = 1'-0"

*Note: -*  
Scantlings of W.I. Pillars, Girders,  
& Hatch End Beams & Hatch Coaming Girders  
will be dealt with later.

*Hatch Coaming girder continuous 24" above deck  
between frames 150 & 157*

*Hatch Coaming girder continuous 24" above dk  
between frames 150 & 157*

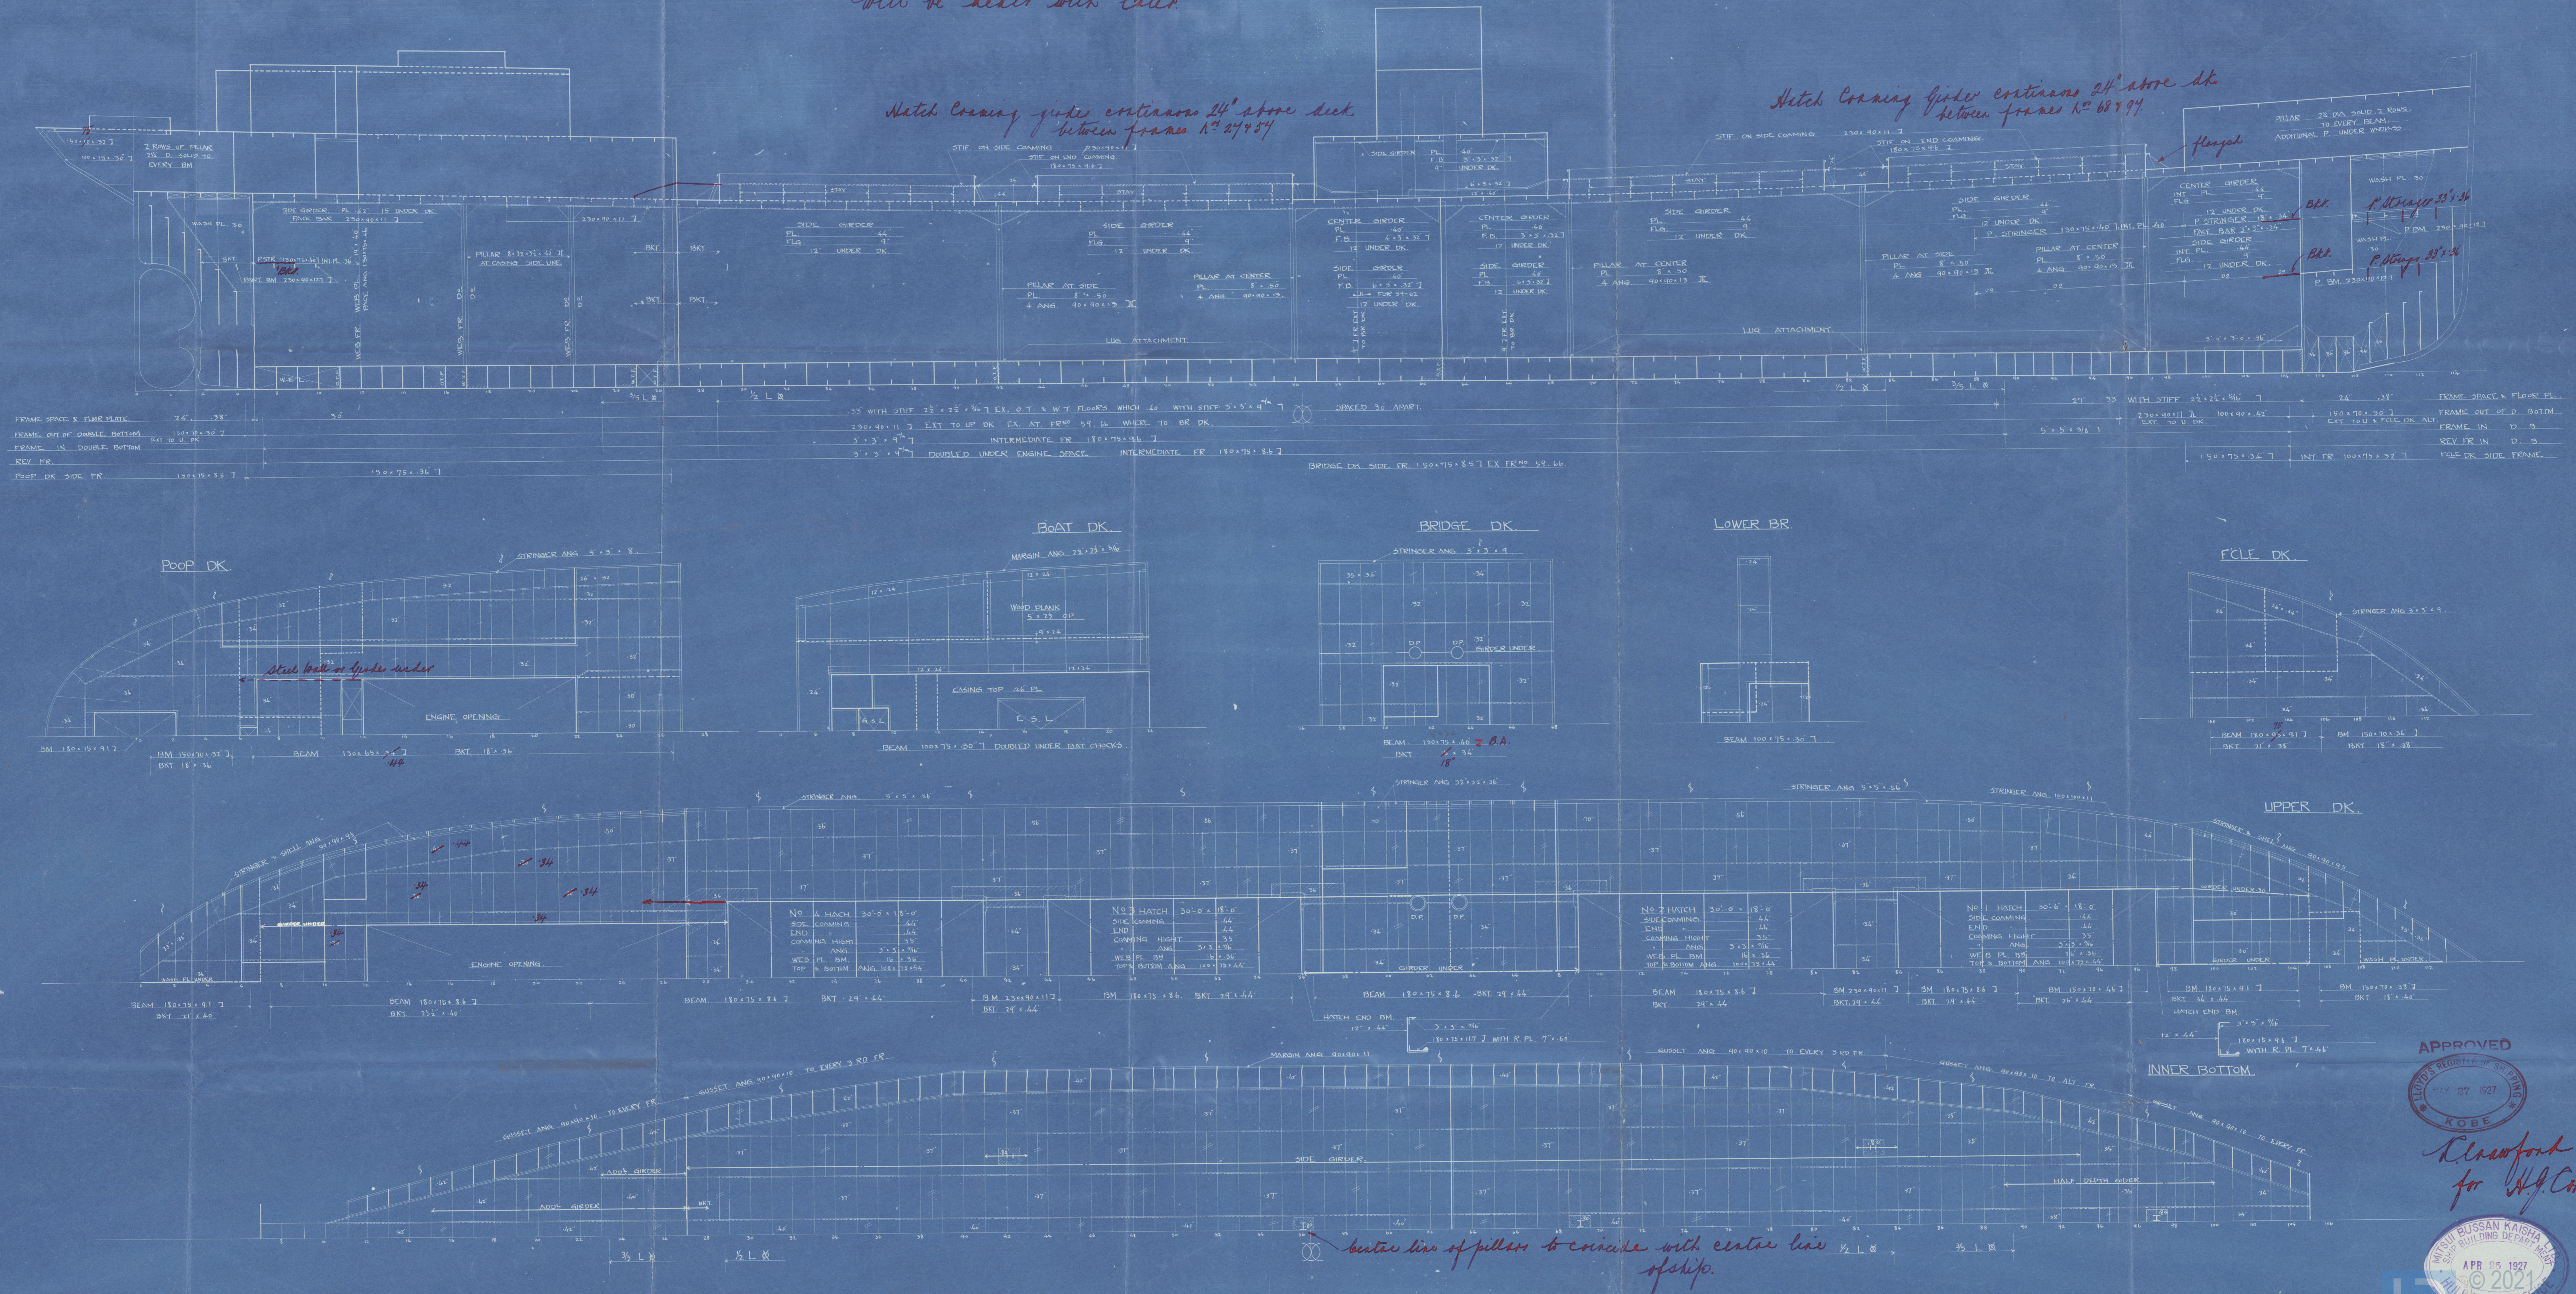

APPROVED  
LLOYD'S REGISTER OF SHIPS  
ROBE

*Approved for H.A. Co.*

BUSAN KAISHA  
LLOYD'S REGISTER OF SHIPS  
APR 25 1927  
DESIGN OF  
LLOYD'S REGISTER FOUNDATION

London Office Copy.

Profile

~~Tamara~~

GEN. BOX NO.

2692

Takamisa Maru

"Takamisa Maru"



© 2021

Lloyd's Register  
Foundation