


**DIMENSIONS:**

|                                      |         |
|--------------------------------------|---------|
| LENGTH PP                            | 487'-6" |
| BREADTH MOULDED                      | 64'-0"  |
| DEPTH MOULDED                        | 38'-0"  |
| DRAFT SUMMER MOULDED                 | 27'-4"  |
| L+D=18806 : L(B+D)=49808 : L/D=12.77 |         |

Inv. copy  
2.5

CLASS:  
LLOYD'S REGISTER OF SHIPBUILDING  
Subdivided by April 12, 1936  
M/S 490 THORILD  
LONGITUDINAL SECTION  
AND PLANS

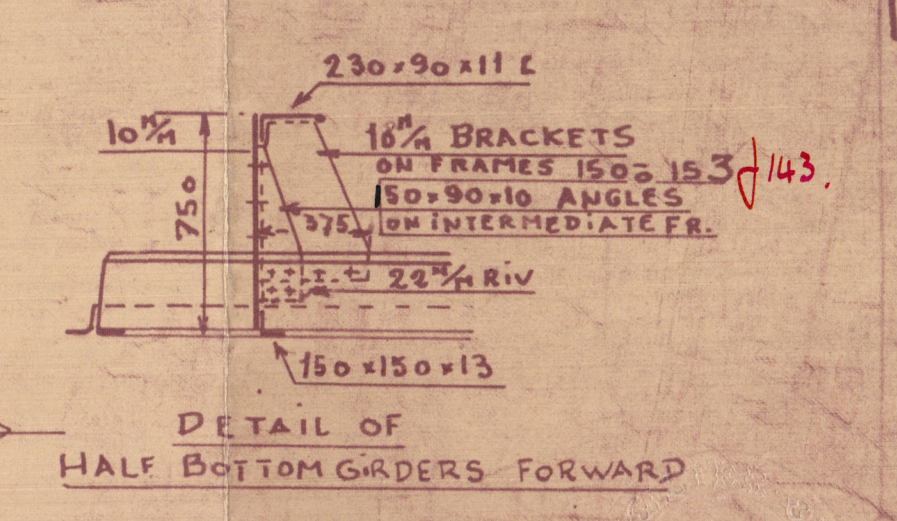



65713

X

008258-008267-0157



© 2021

Lloyd's Register  
Foundation