
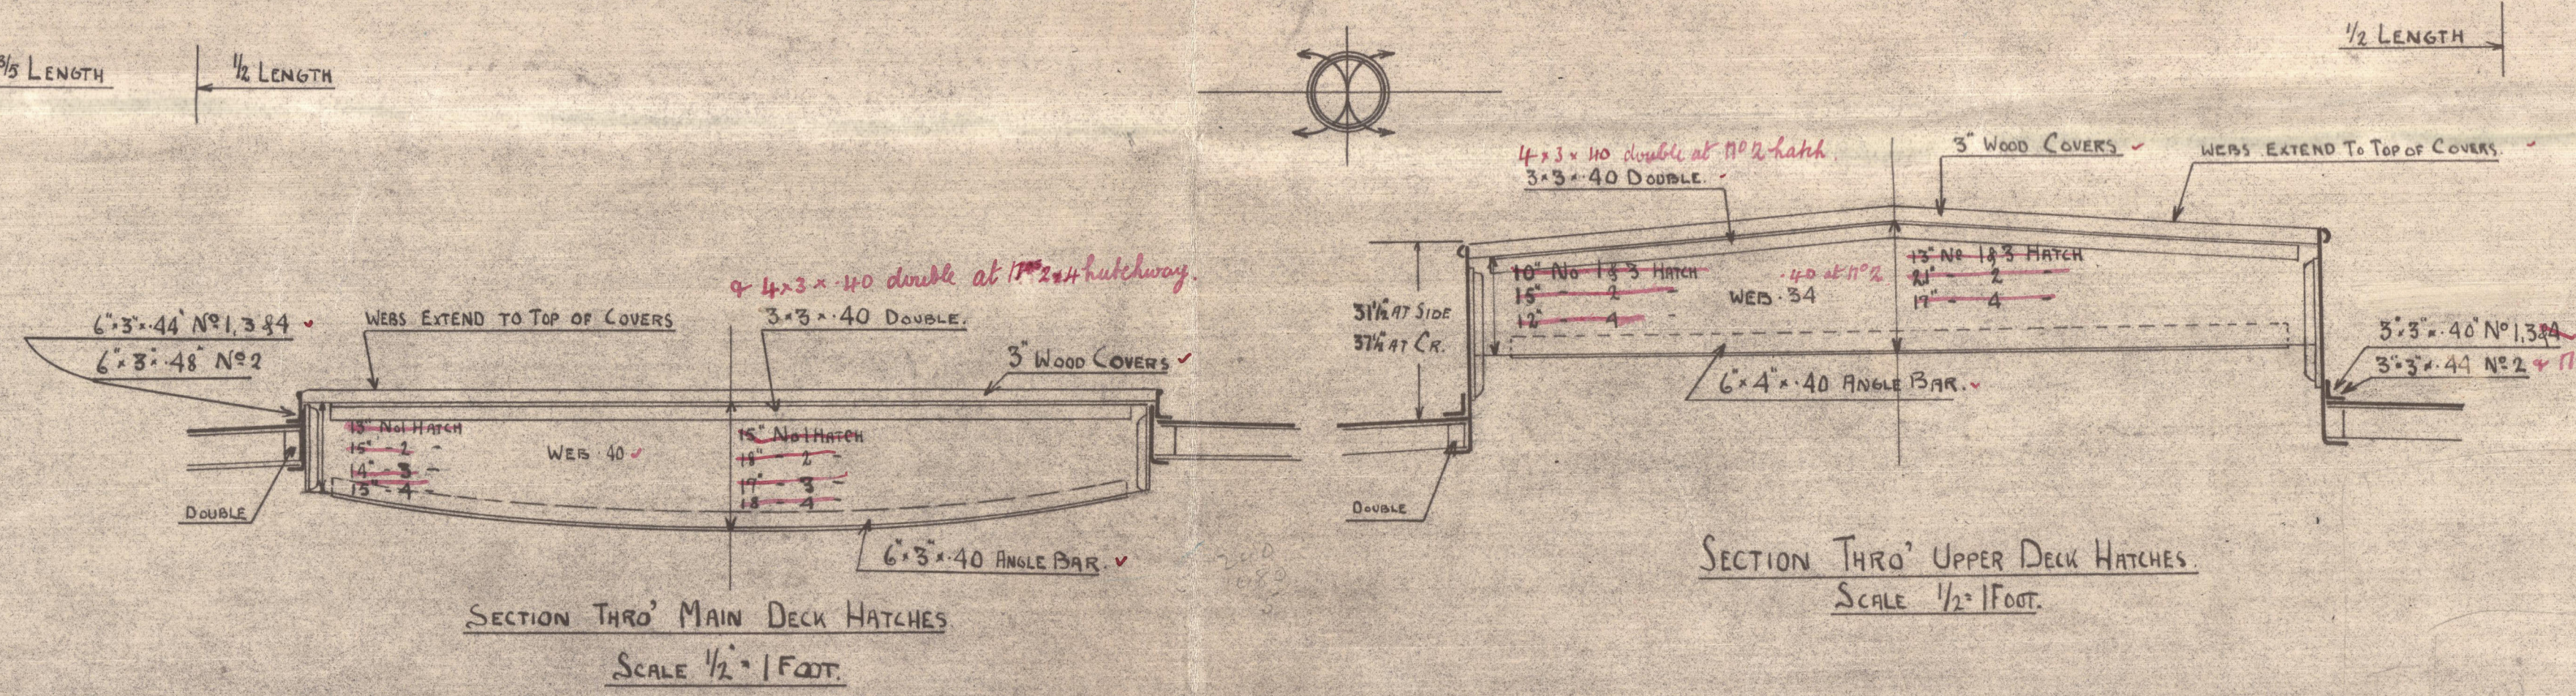
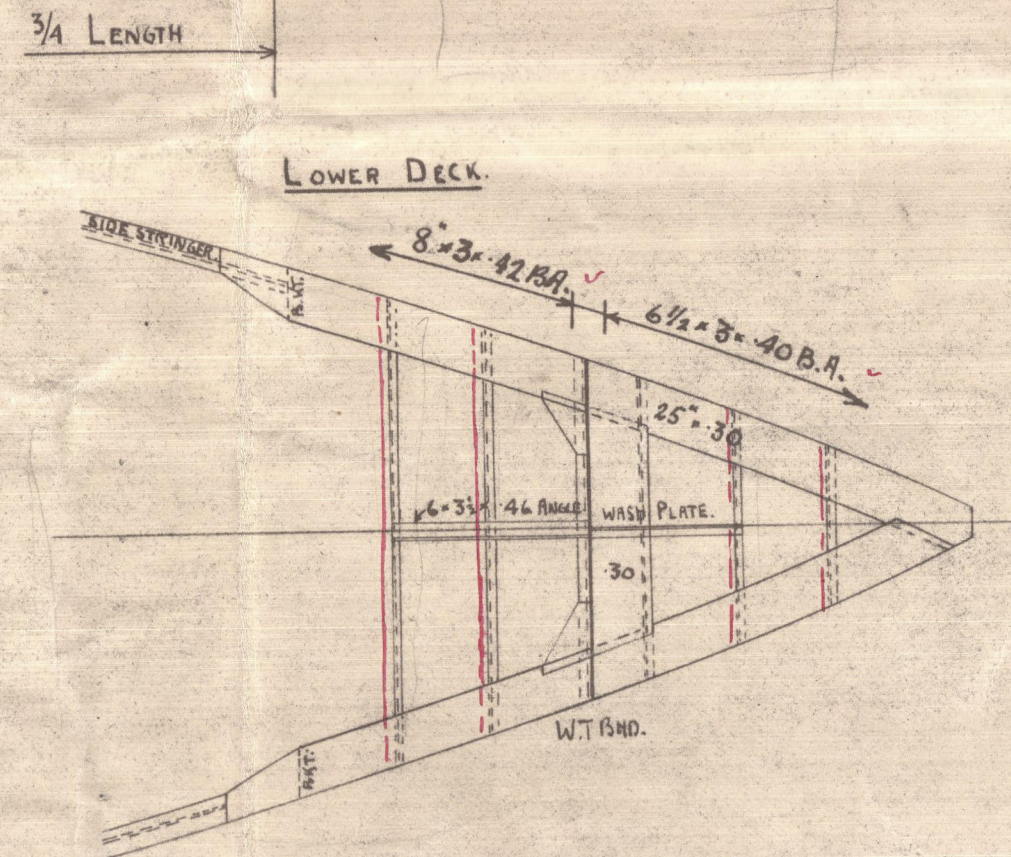
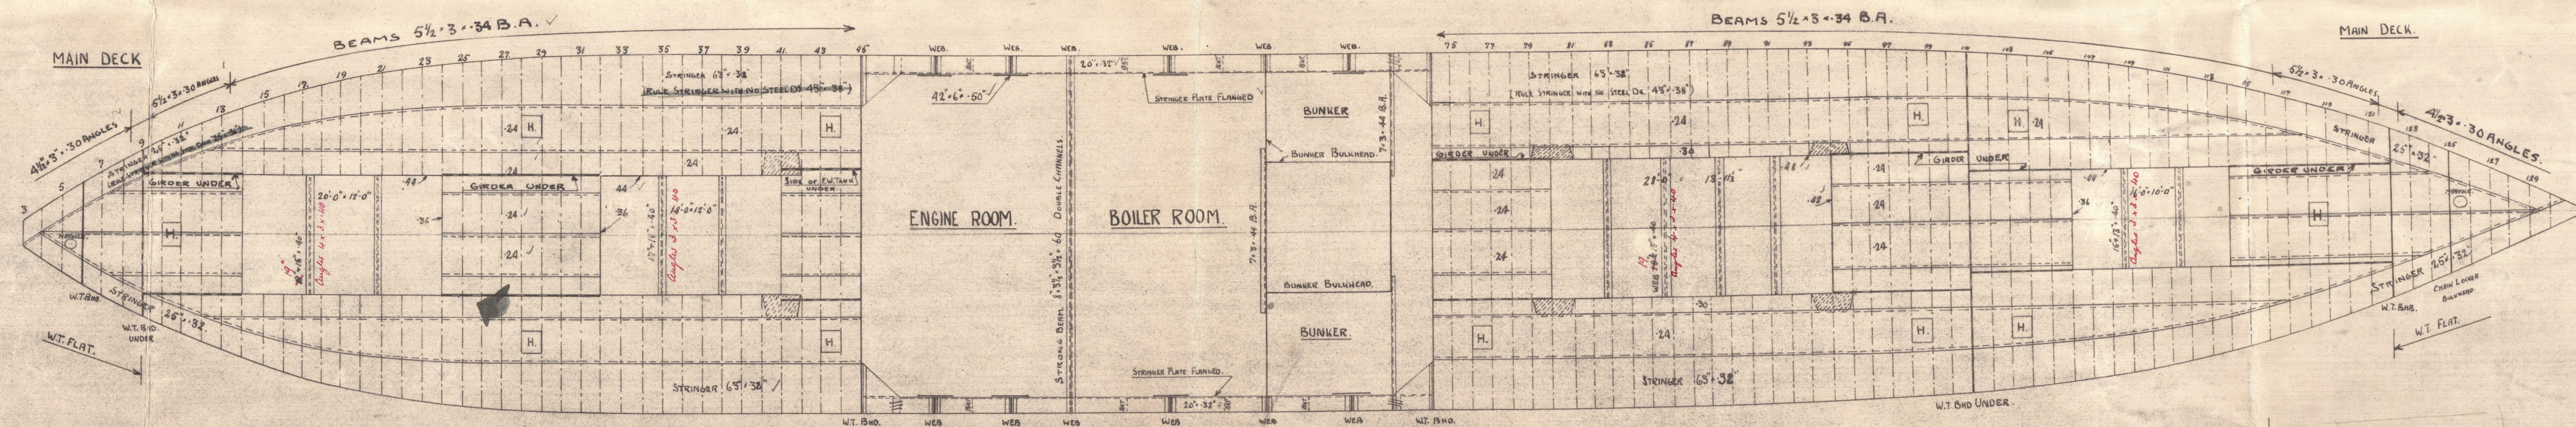
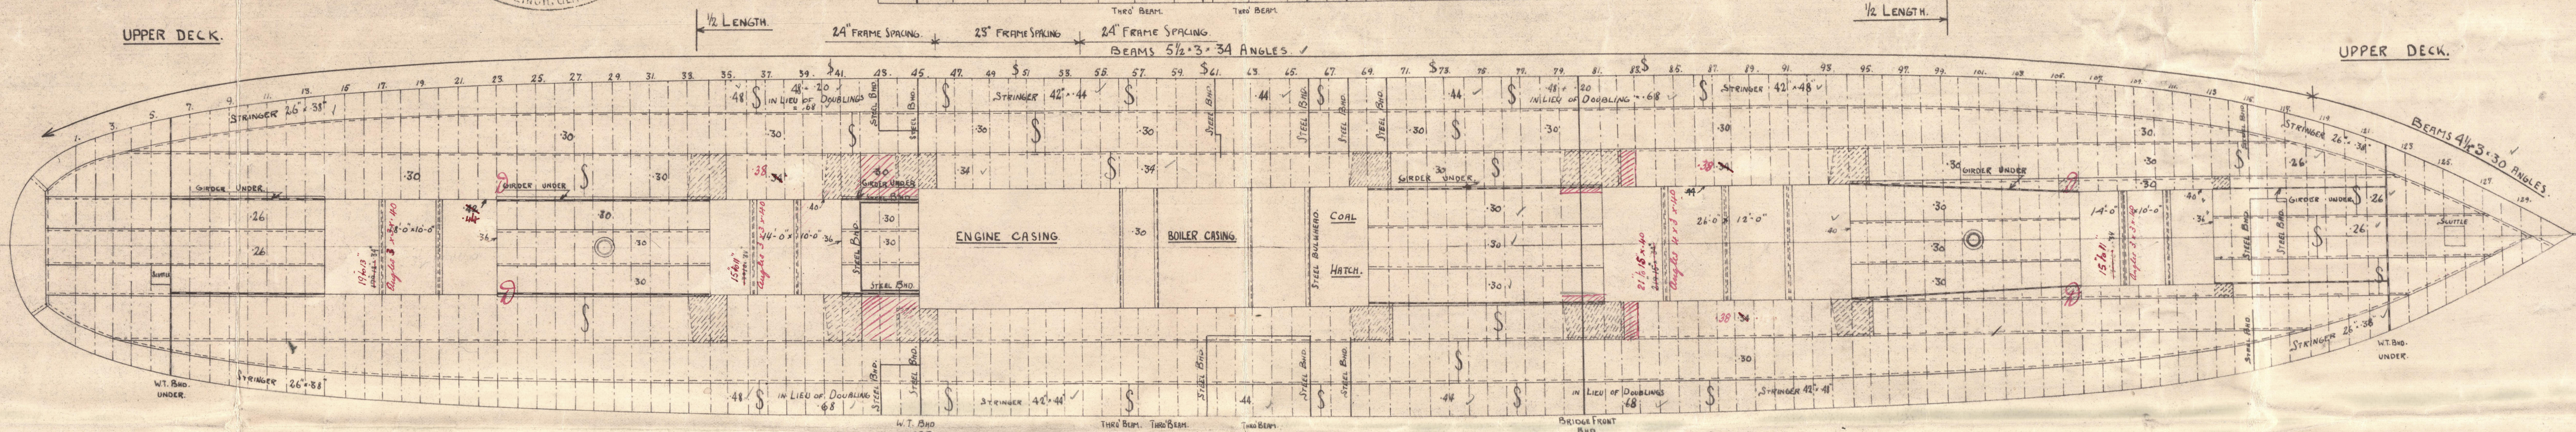
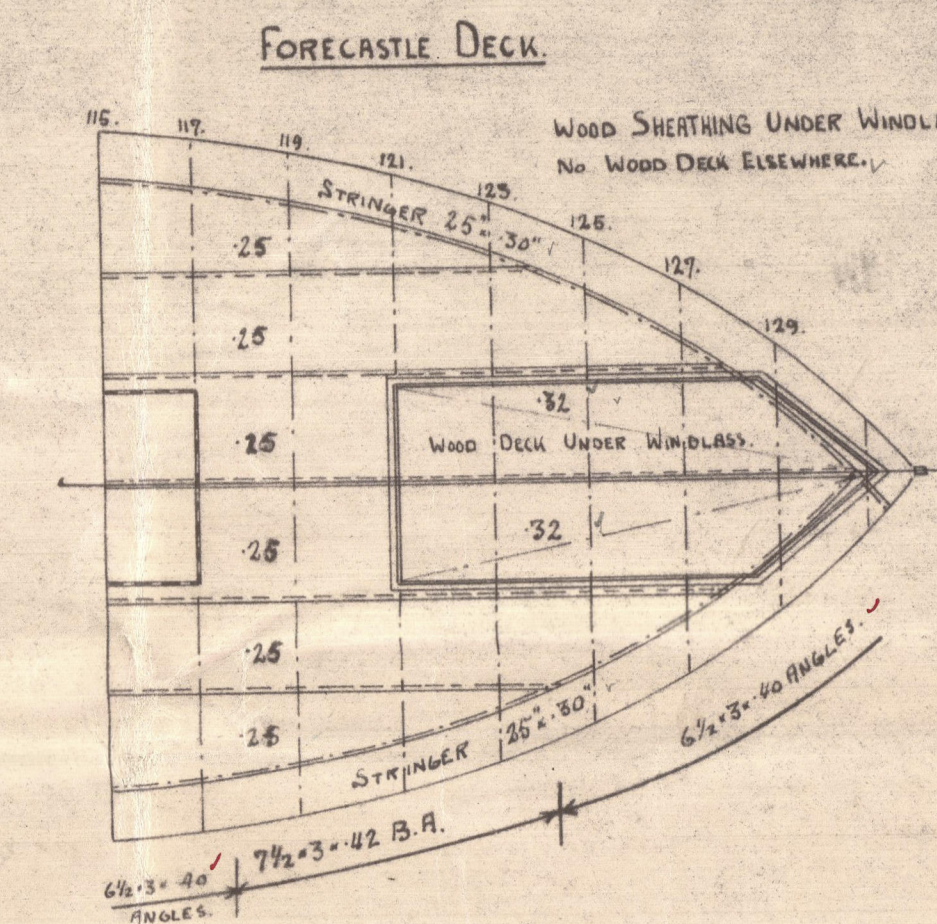
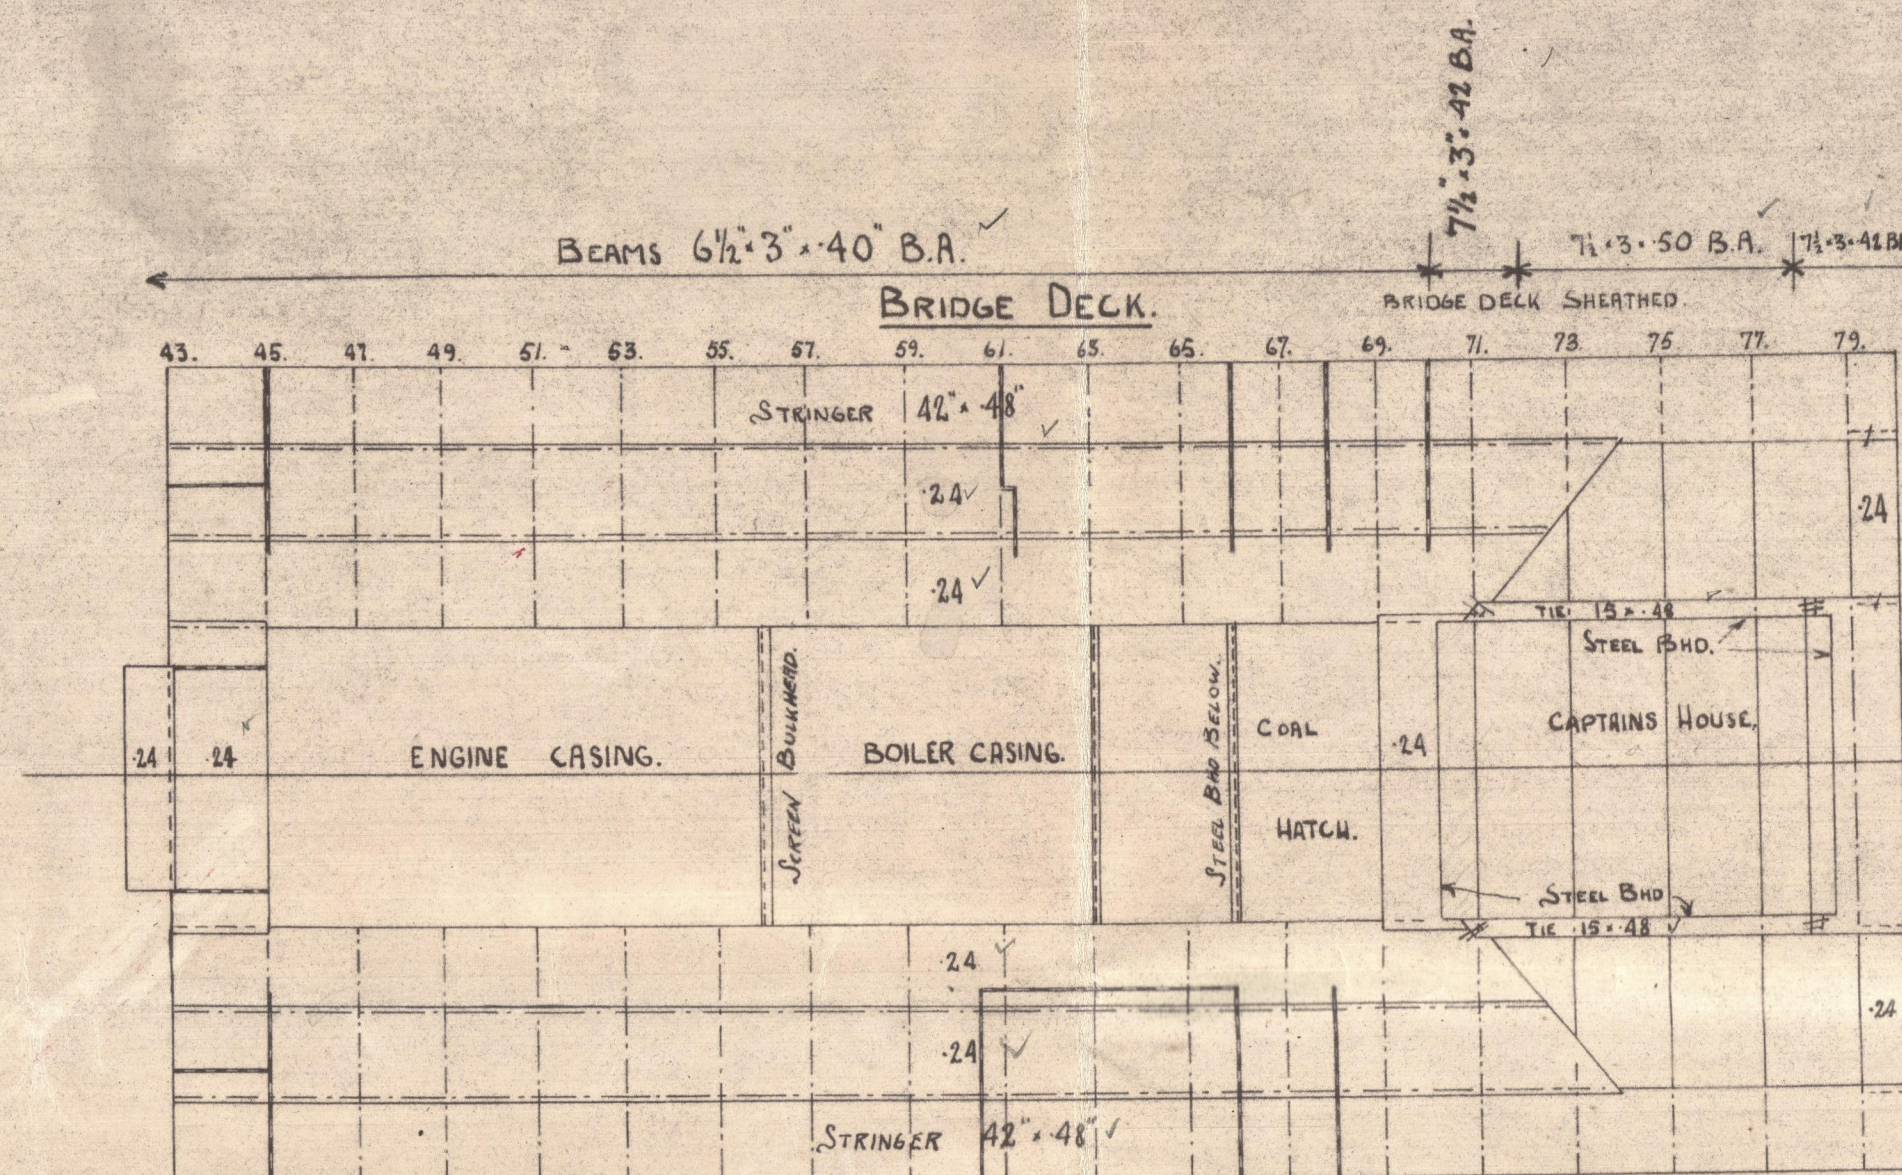


15.2.12

STEEL DECKS S.S. No 503.

MOULDED DIMENSIONS 260'-0" x 35'-10" x 24'-6"

SCALE 1/8" = 1 FOOT.

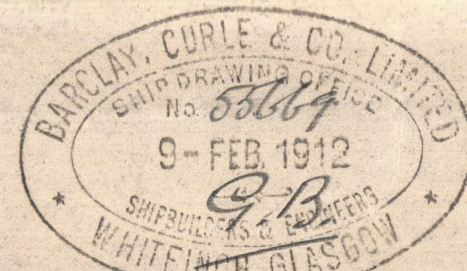

SECTION THRO' UPPER DECK HATCHES
SCALE 1/2" = 1 FOOT.

Barclay Curle & Co.
Dech Plans
No 503

SP BORDERLAND



GLASGOW REPORT No 32197.



© 2021

Lloyd's Register

008288-008295-0087

Lloyd

008288-008295-0087



© 2021

Lloyd's Register
Foundation