
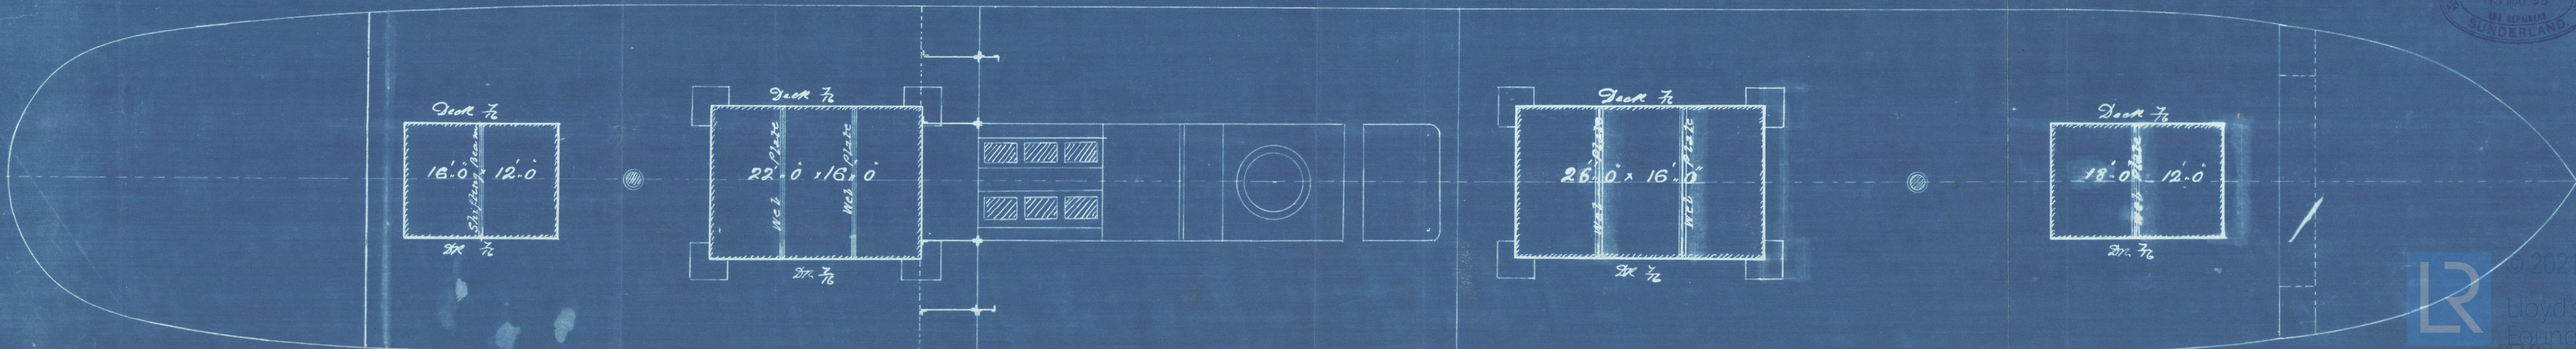


General Arrangement No. 98

Scale 1/8 inch = 1 foot

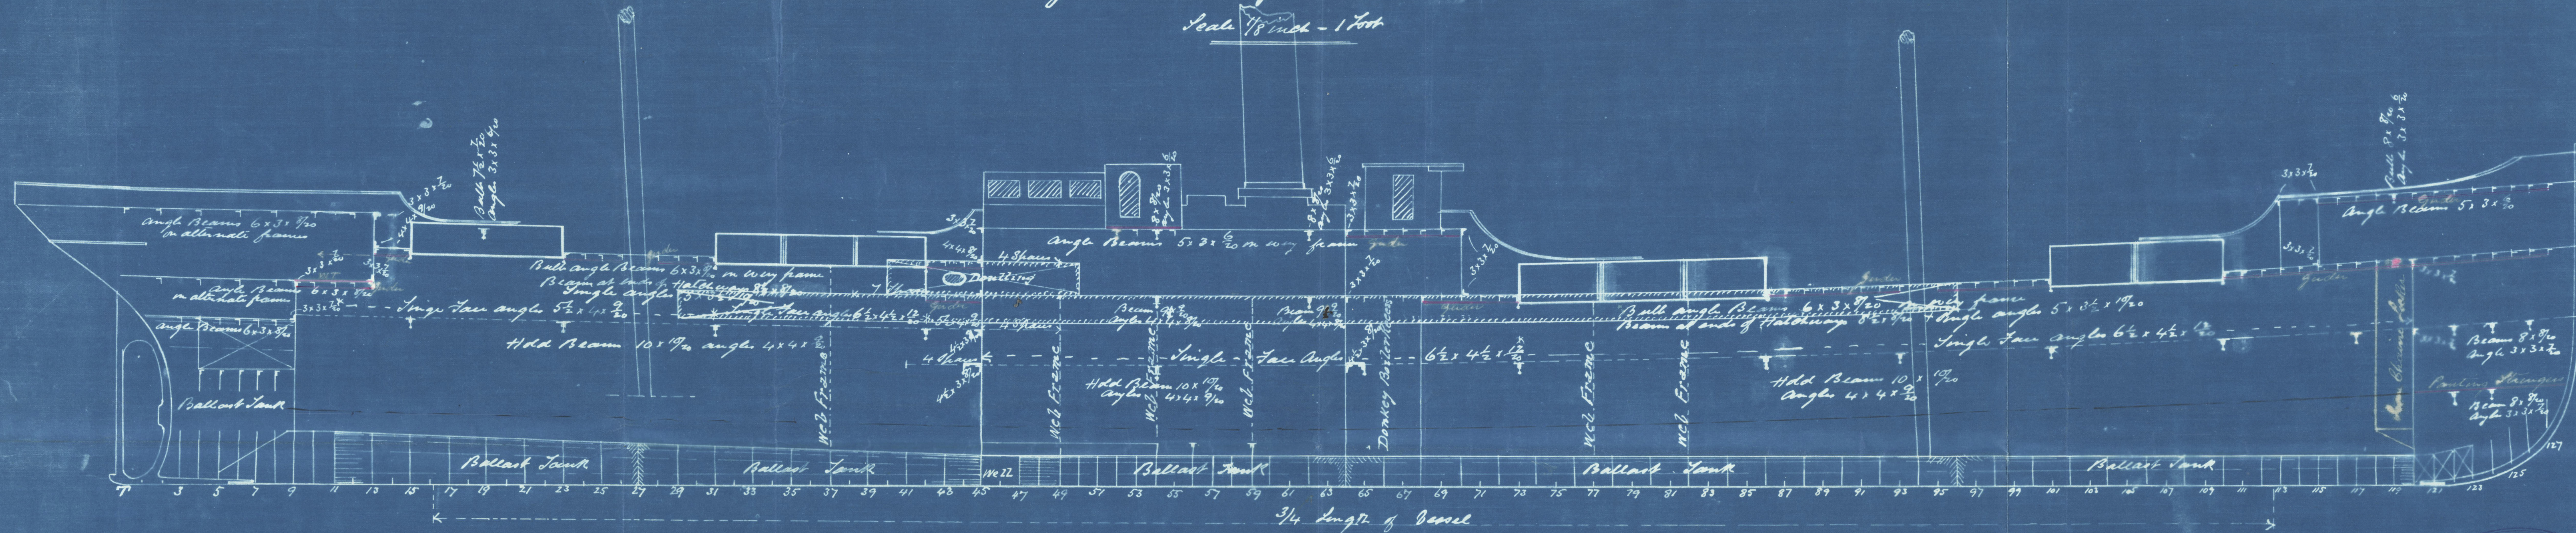

STRAND SLIPWAY CO

S. S. N^o 98

"PROFILE"

S.S. "GOTTFRID"

Tunderland. N^o 19697

Notes vessel to
St. Abchurch
Sea 1948.



© 2021

Lloyd's Register
Foundation

008288-008295-0151