

— EQUIPMENT. —

2 BOWER ANCHORS	53½ CWTs.	STOCKLESS.
1 BOWER ANCHOR	53	"
1 STREAM "	15	" EX STOCK.
1 KEDGE "	6½	" " "
270 FATHOMS	2½"	STUD CHAIN CABLE.
90 "	4½"	STEEL WIRE.
120 "	4½"	" " "
4 @ 90 FATHOMS	2½"	STEEL WIRE.

# P.L.M. 12. MIDSHIP SECTION.

DIMENSIONS: 345'-0" B.P. x 49'-3" MLD. x 27'-3" MLD.

CLASSED 100 A.I. LLOYDS.

SCALE: ½" = 1 FOOT.

LONGITUDINAL NUMBER = 26392.

TRANSVERSE " = 76.50.



**M' STRAKE. OUT.**

PLATING .42 BUTTS DOUBLE

**L' STRAKE. IN.**

PLATING .42 BUTTS DOUBLE

**K' SHEERSTRAKE. IN & OUT.**

PLATING .90 - .30 .44 AT 24" SPACING  
BUTTS QUAD. TO TREBLE WHERE .68  
AND UNDER AT ENDS.

**J' STRAKE. OUT.**

PLATING .64 - .50 .44 AT 24" SPACING  
QUAD FOR ½ L TO TREBLE AT ENDS.

**H' STRAKE. IN.**

PLATING .64 - .50 .44 AT 24" SPACING  
BUTTS TREBLE

**G' STRAKE. OUT.**

PLATING .64 - .50 .44 AT 24" SPACING  
BUTTS TREBLE

**F' STRAKE. IN.**


PLATING .64 - .50 .44 AT 24" SPACING  
BUTTS TREBLE

**BOSS PLATING .68.**

BUTTS, QUADRUPLE RIV'D

**E' STRAKE. OUT.**

PLATING .68 - .50 .44 AT 24" SPACING  
BUTTS TREBLE  
BUTTS QUAD. RIV'D FOR ½ L WHERE  
OVER RULE WIDTH

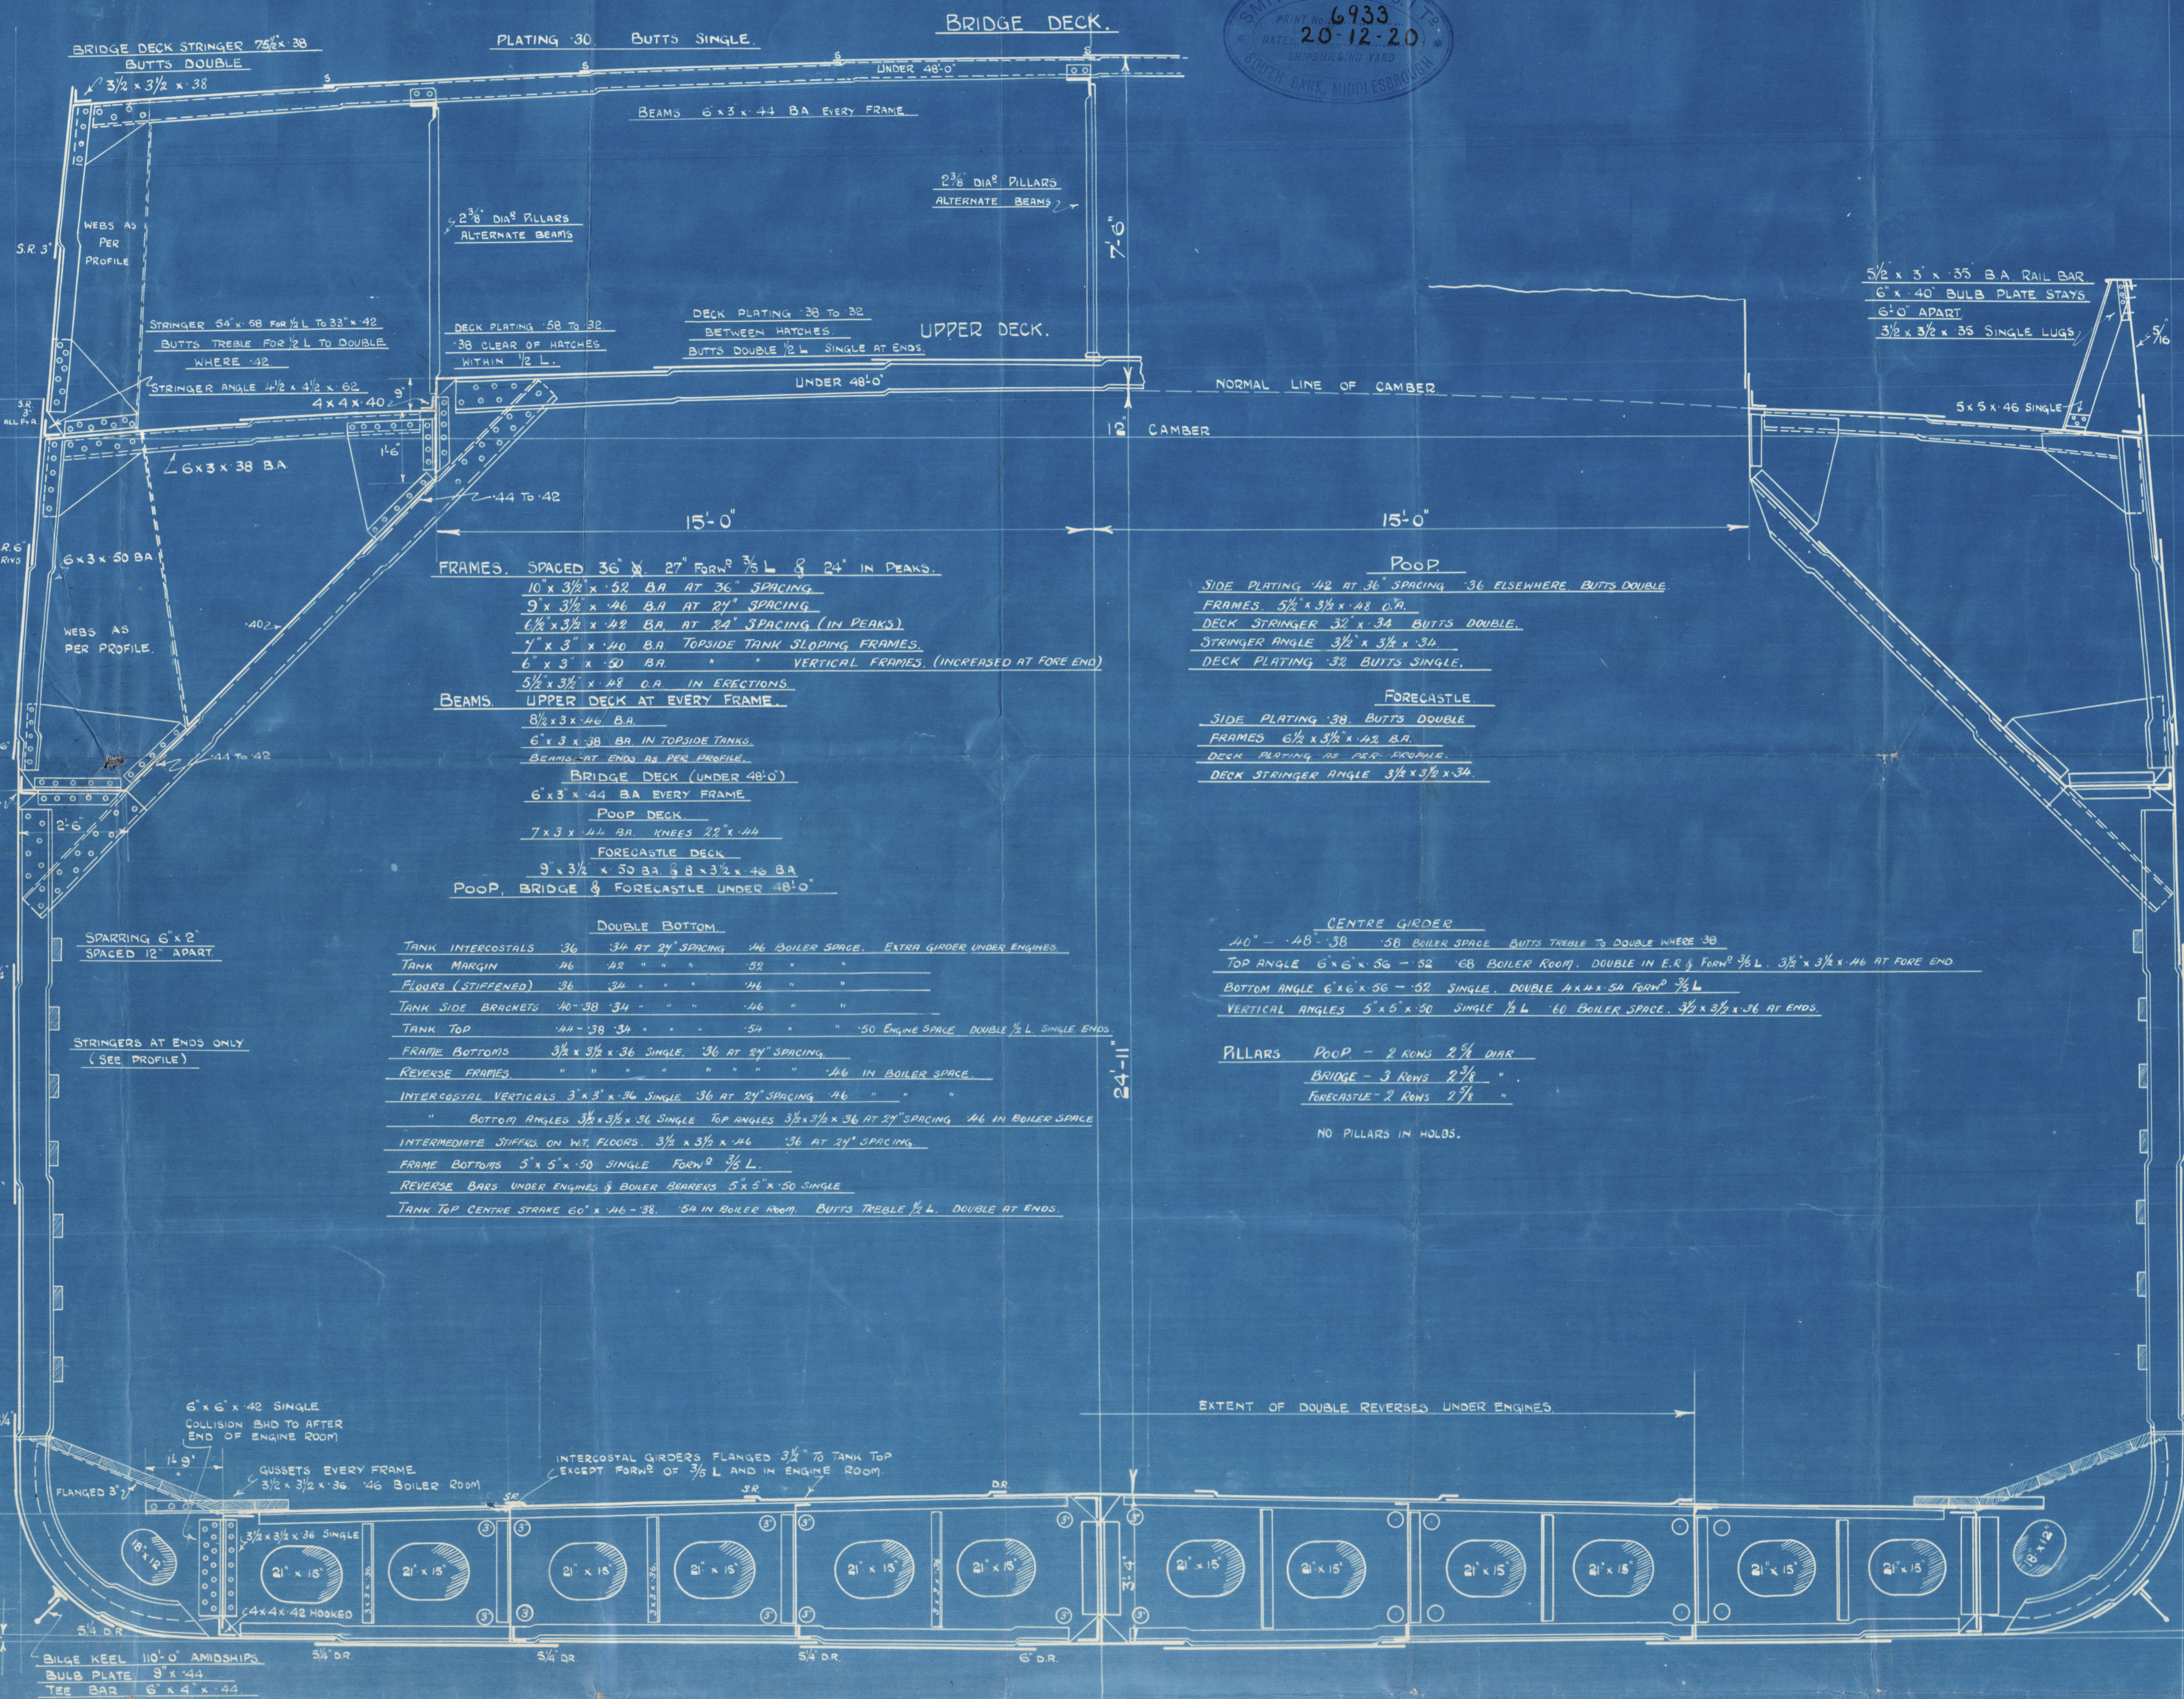

**D' STRAKE. IN.**

PLATING .68 - .50 .44 AT 24" SPACING  
BUTTS TREBLE

**C' STRAKE. OUT.**

PLATING .68 - .50 .44 AT 24" SPACING  
BUTTS TREBLE

**B' STRAKE. IN.**

PLATING .64 - .50 .44 AT 24" SPACING  
BUTTS QUADRUPLE FOR ½ L  
WHERE OVER RULE WIDTH

**A' STRAKE. OUT.**

PLATING .68 - .50 .44 AT 24" SPACING  
BUTTS TREBLE

**KEEL. IN.**

45' x 90 ½ L .64 AT ENDS  
BUTTS QUAD. FOR ½ L &  
TREBLE AT ENDS WHERE UNDER .76

SMITH'S DOCK COY. LTD.  
SHIPBUILDERS & ENGINEERS.  
SOUTH BANK ON TEES.  
ENGLAND.

"P.L.M. 12"

MIDSHIP SECTION

AS. BUILT.

