


"P.L.M. 12."

PROFILE & DECK PLANS.

DIMS:- 345'-0" B.P. x 49'-3" MLD x 27'-3" MLD.

CLASSED:- 100 A.I. LLOYDS.
SCALE:- 1" = 10'.

TRANSVERSE NO:- 76-50
LONGITUDINAL NO:- 26352

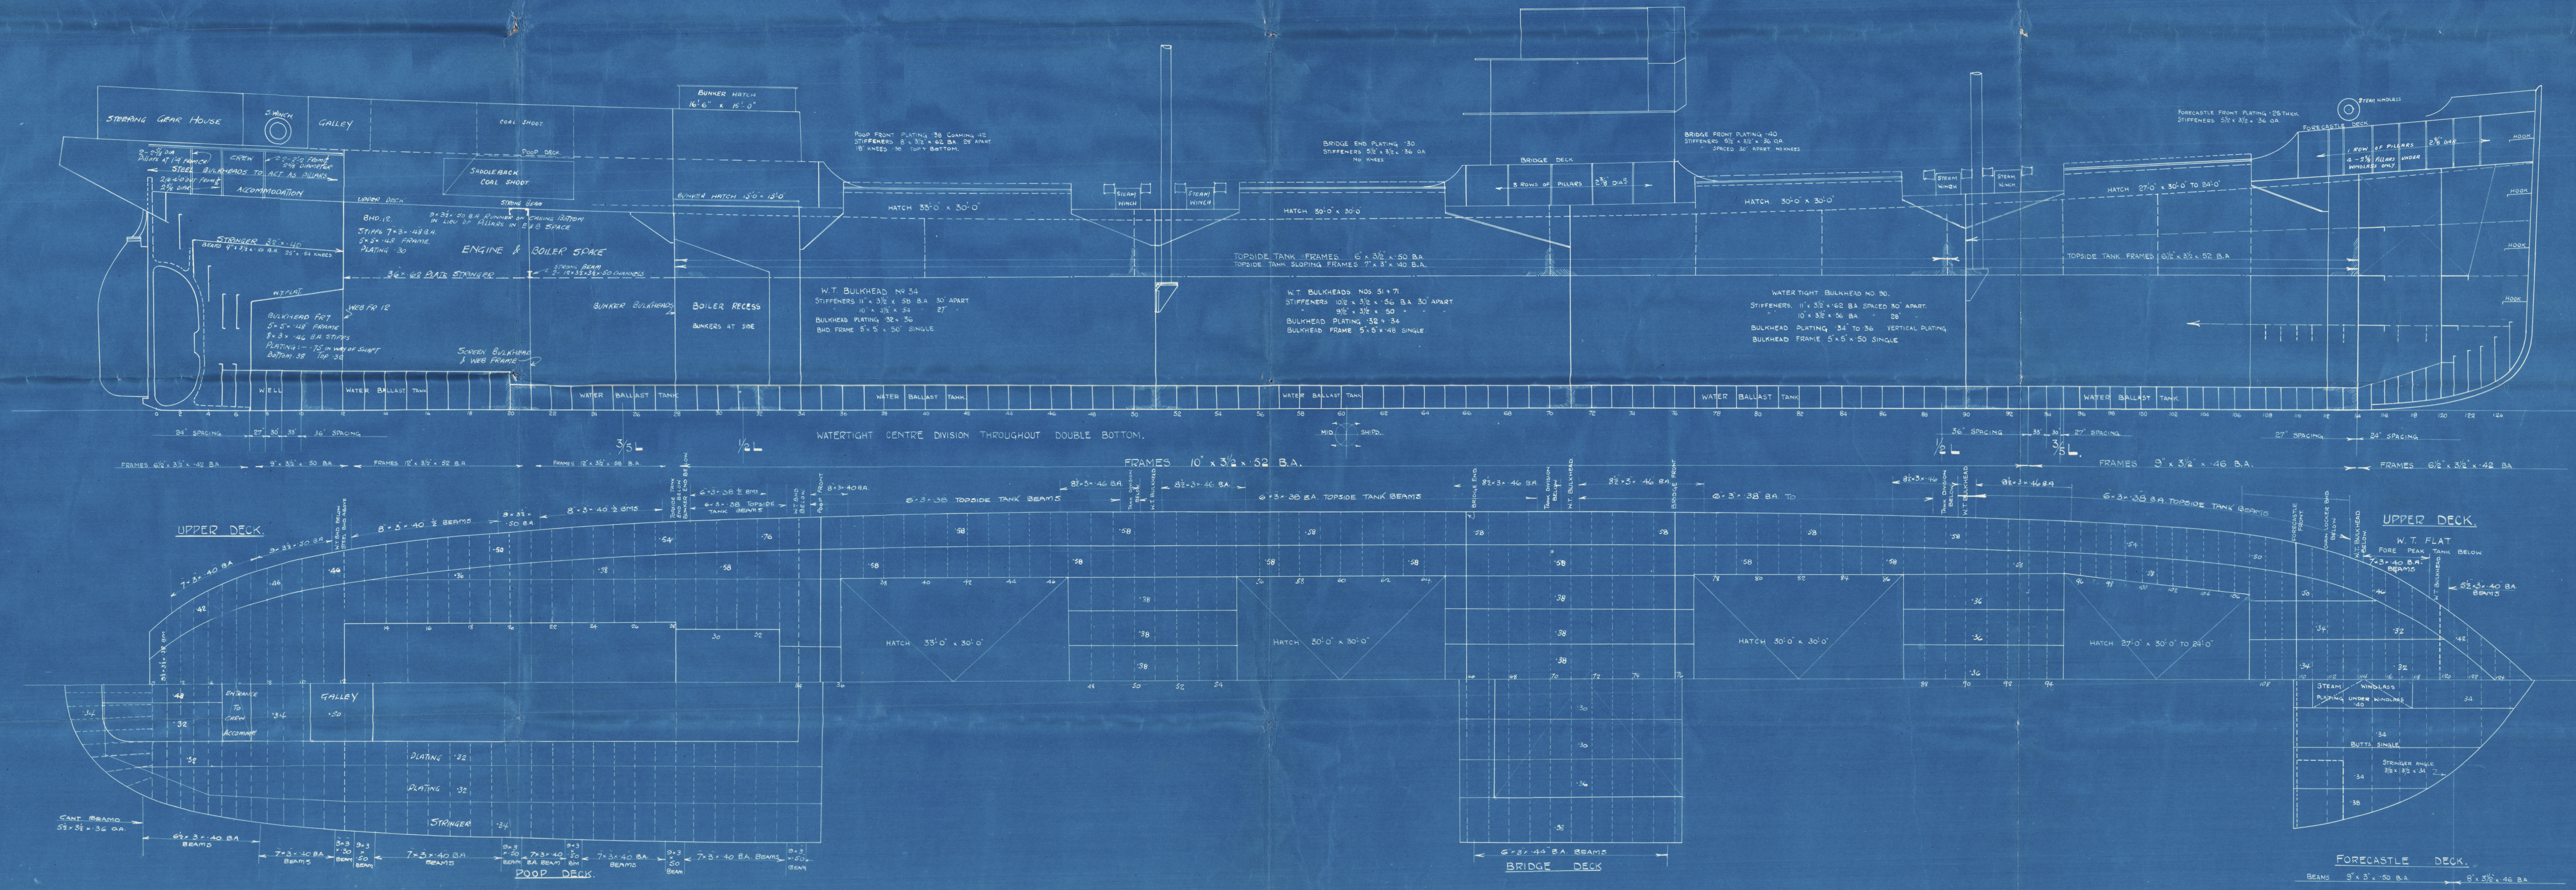

S. S. P. L. M. 12

MESSRS. SMITH'S DOCK Co's N^o 760.

PROFILE & DECK PLANS.
AS BUILT.



© 2020

Lloyd's Register
Foundation

008296-008304-0122