



KOMSOMOLSK 257


№ 251-7. TIMBER CARRYING VESSELS.


PROFILE, DECK PLANS ETC.

DIMENSIONS 97.99 M. LENGTH B.P. × 14.63 M. BREADTH M.W. × 6.93 M. DEPTH M.W. TO UPPER DECK.

SCALE 1:100.

TO CLASS JT * P 4/C TO U.S.S.R. REGISTRY.

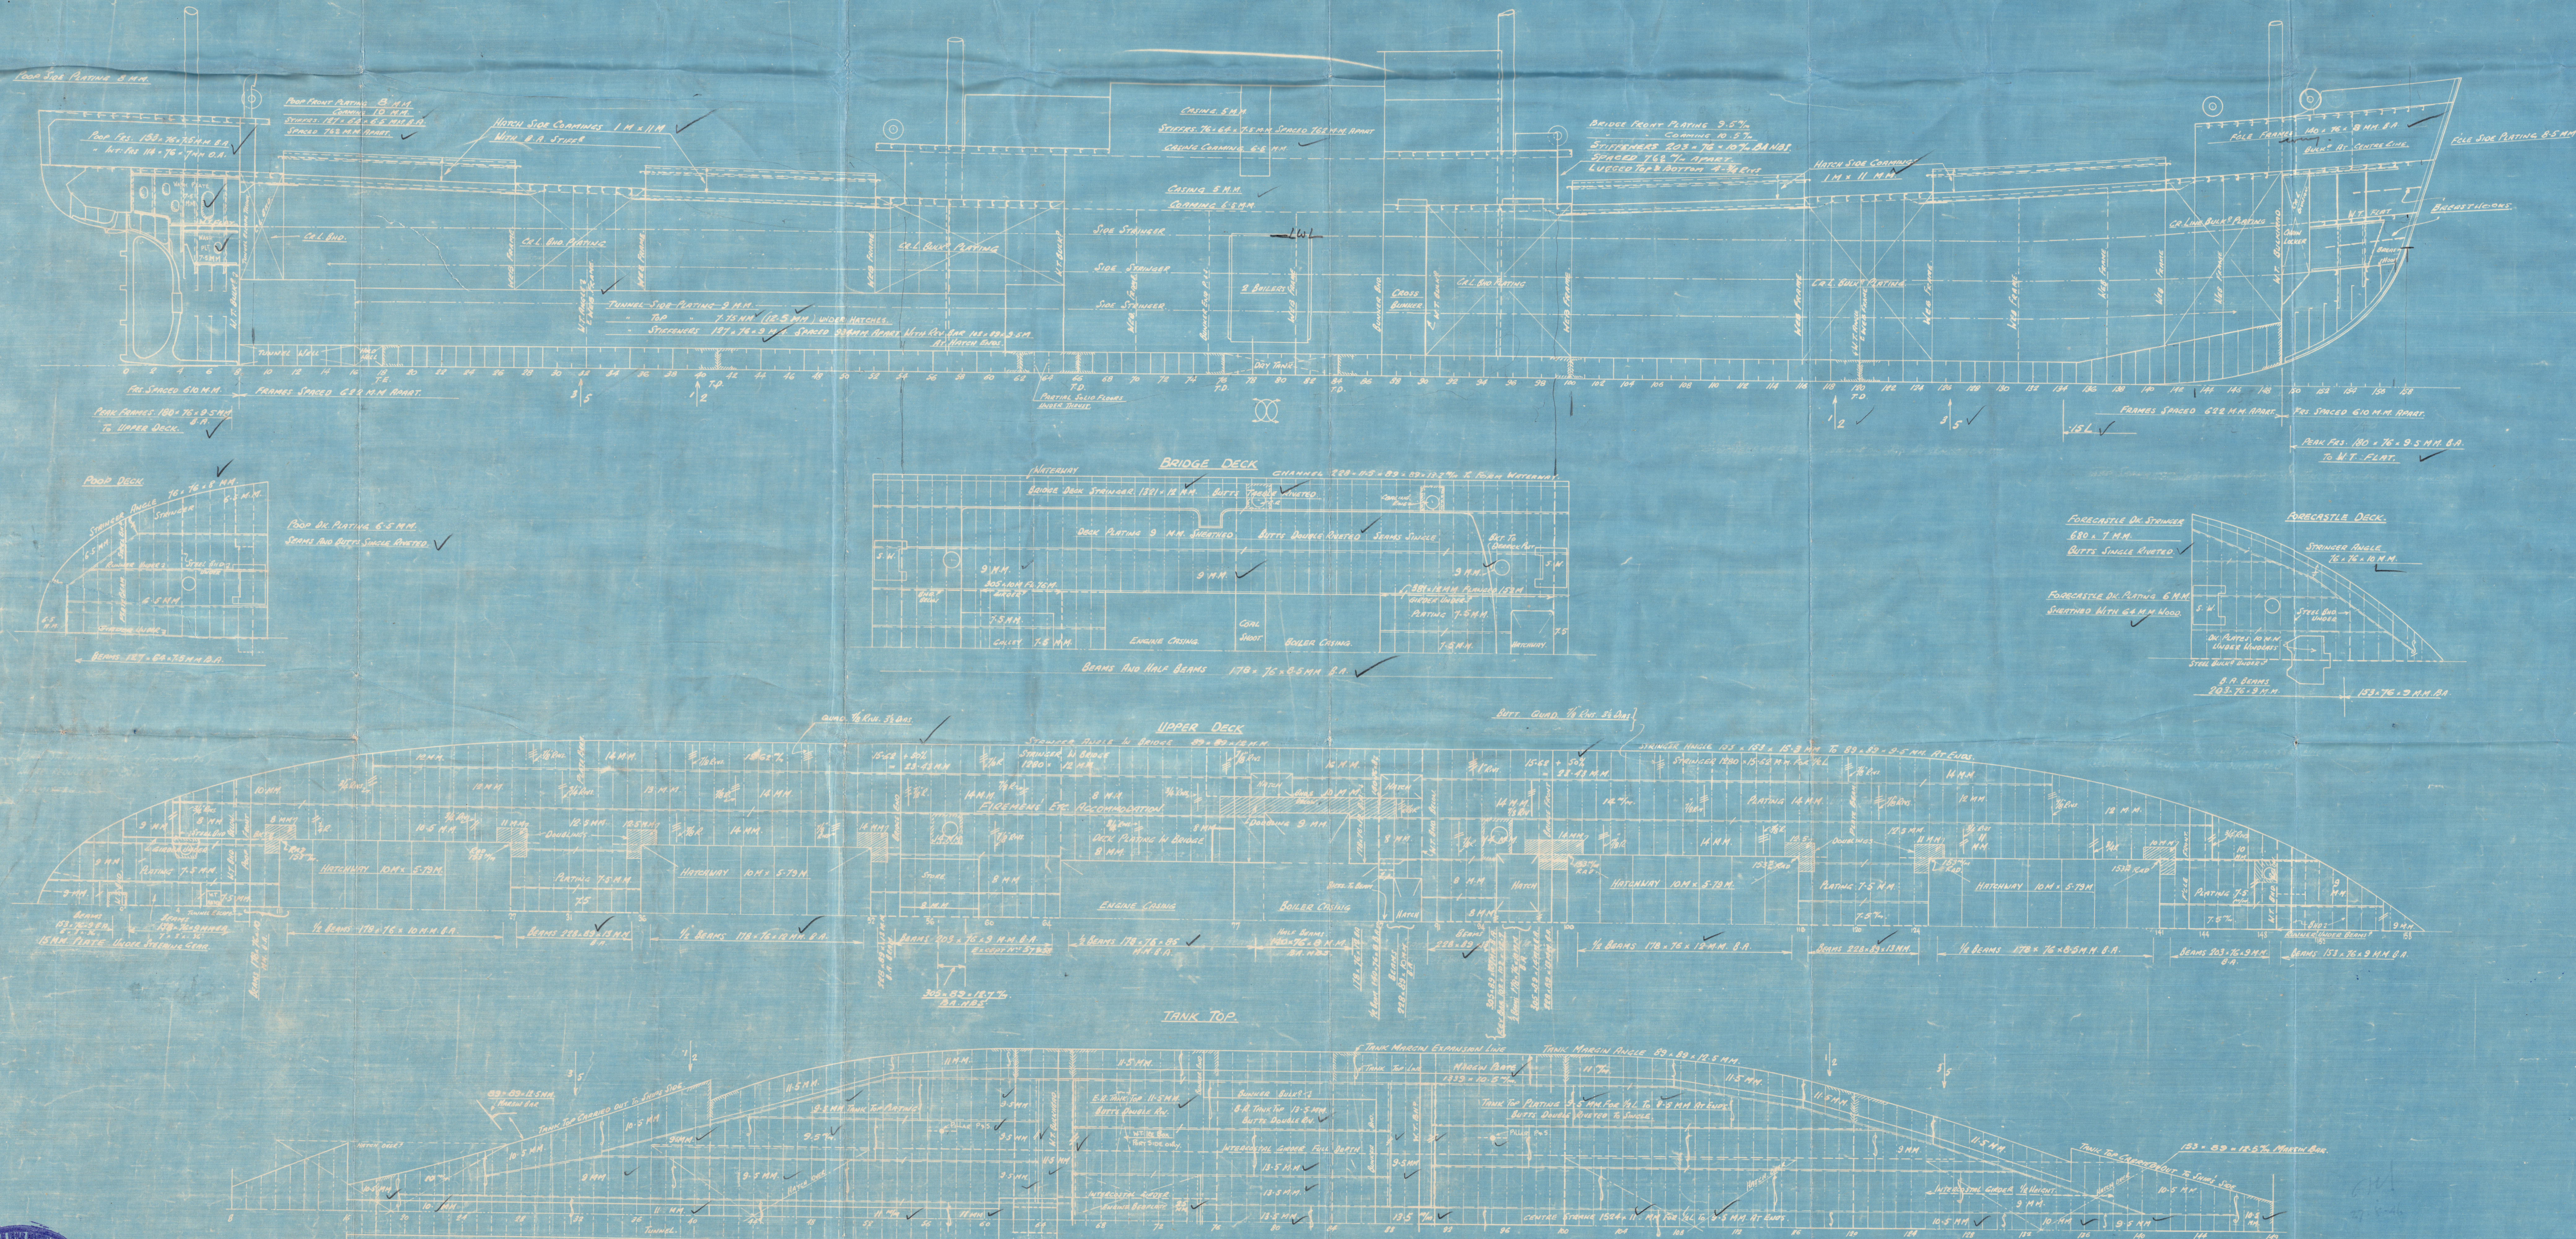

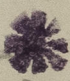S S KOMSO M O L S K 
Rot upl No. 30007.
PROFILE & DECKS

APPR. LON. 27. 8. 46

M. 27. 8. 46.

PLEASE RETURN PLAN TO LONDON.

2



© 2020

Lloyd's Register
Foundation

008296-008304-0156