


SCALE 1-25.

TO CLASS JT # ⁴ PTC. TO U.S.S.R. REGISTRY

NUMERALS

W. 97.99 M
B. 14.63 M
H. 6.93 M TOUPPER DK
H. 9.21 M. TO BRIDGE DK.
T. 5.91 M.

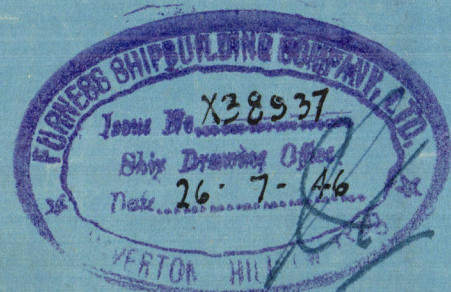

327
S.S. KOMSOMOLSK *

Rotnept No. 30007
MIDSHIP SECTION

ADDR. LON. 27-8-46

M. 27.8.46

PLEASE RETURN
PLAN TO LONDON.



© 2020

Lloyd's Register
Foundation