


26-7-02
7-8-02
13-8-02
22-12-02
16.1.03
2.4.03

PROFILE AND DECK PLAN.
No 170.

SCALE 1/8 INCH TO 1 FOOT

Alter No 172
app. 22/12/02

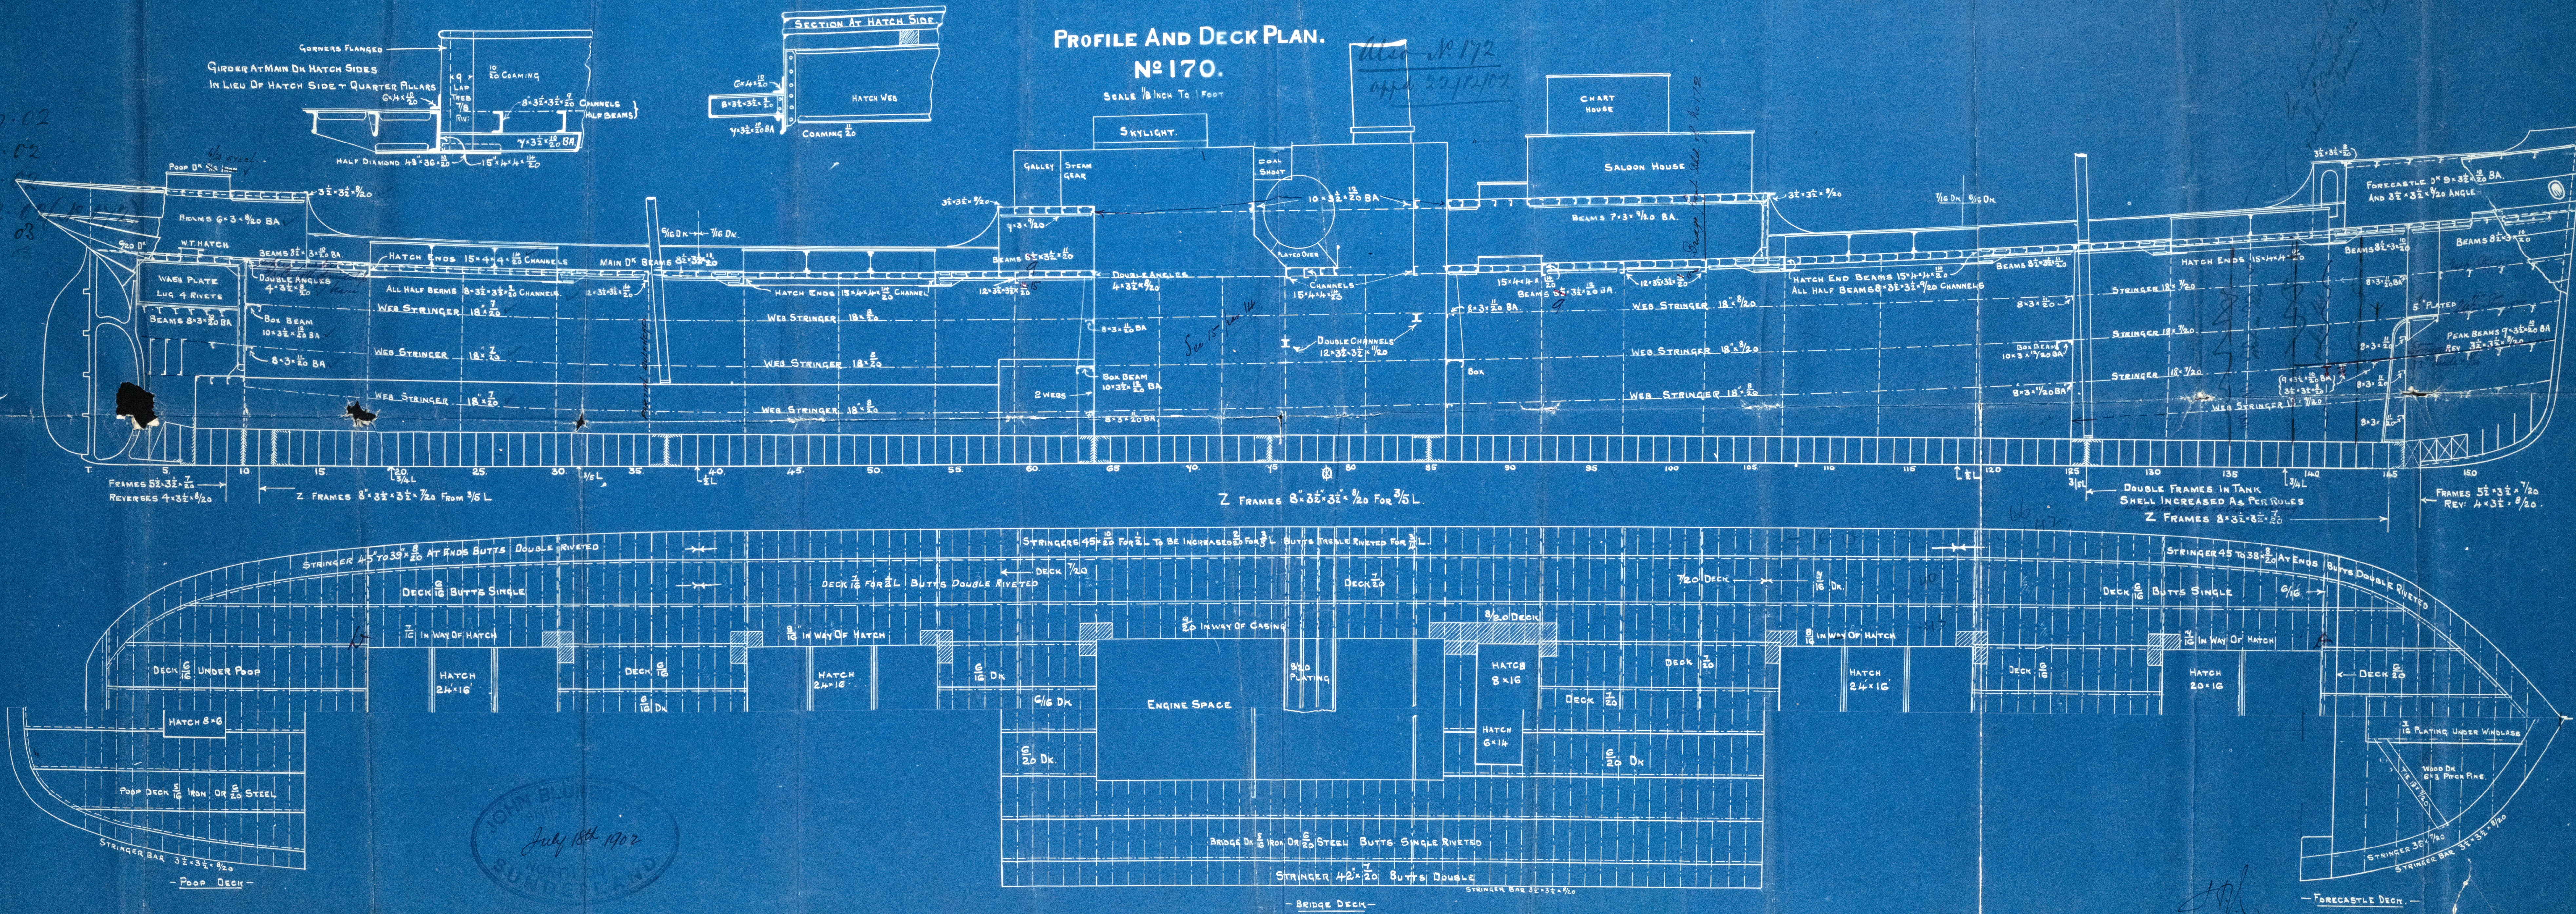

JOHN BLUNDELL
SHIP
July 18th 1902
NORTH DO
BUNDELAND


26/1/02

12


Margarita
Profile

J Blumer & Co

+ N° 170 472

TILDA
S. S. "Margarita" 
Sunderland. No. 21224.

No 172 "Whitby Abbey"
Sunderland. No 21388.

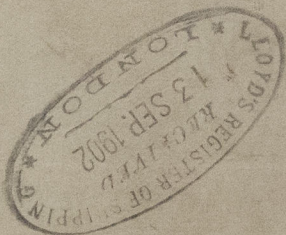

© 2021

Lloyd's Register
Foundation

002365-003313-0110