


S. S. N<sup>o</sup> 172  
MIDSHIP SECTION

LENGTH B.P.	314.0
BREADTH EXT.	46.6
DEPTH. MLD.	23.0%

SINGLE D<sup>K</sup>. CLASS 100 A.1

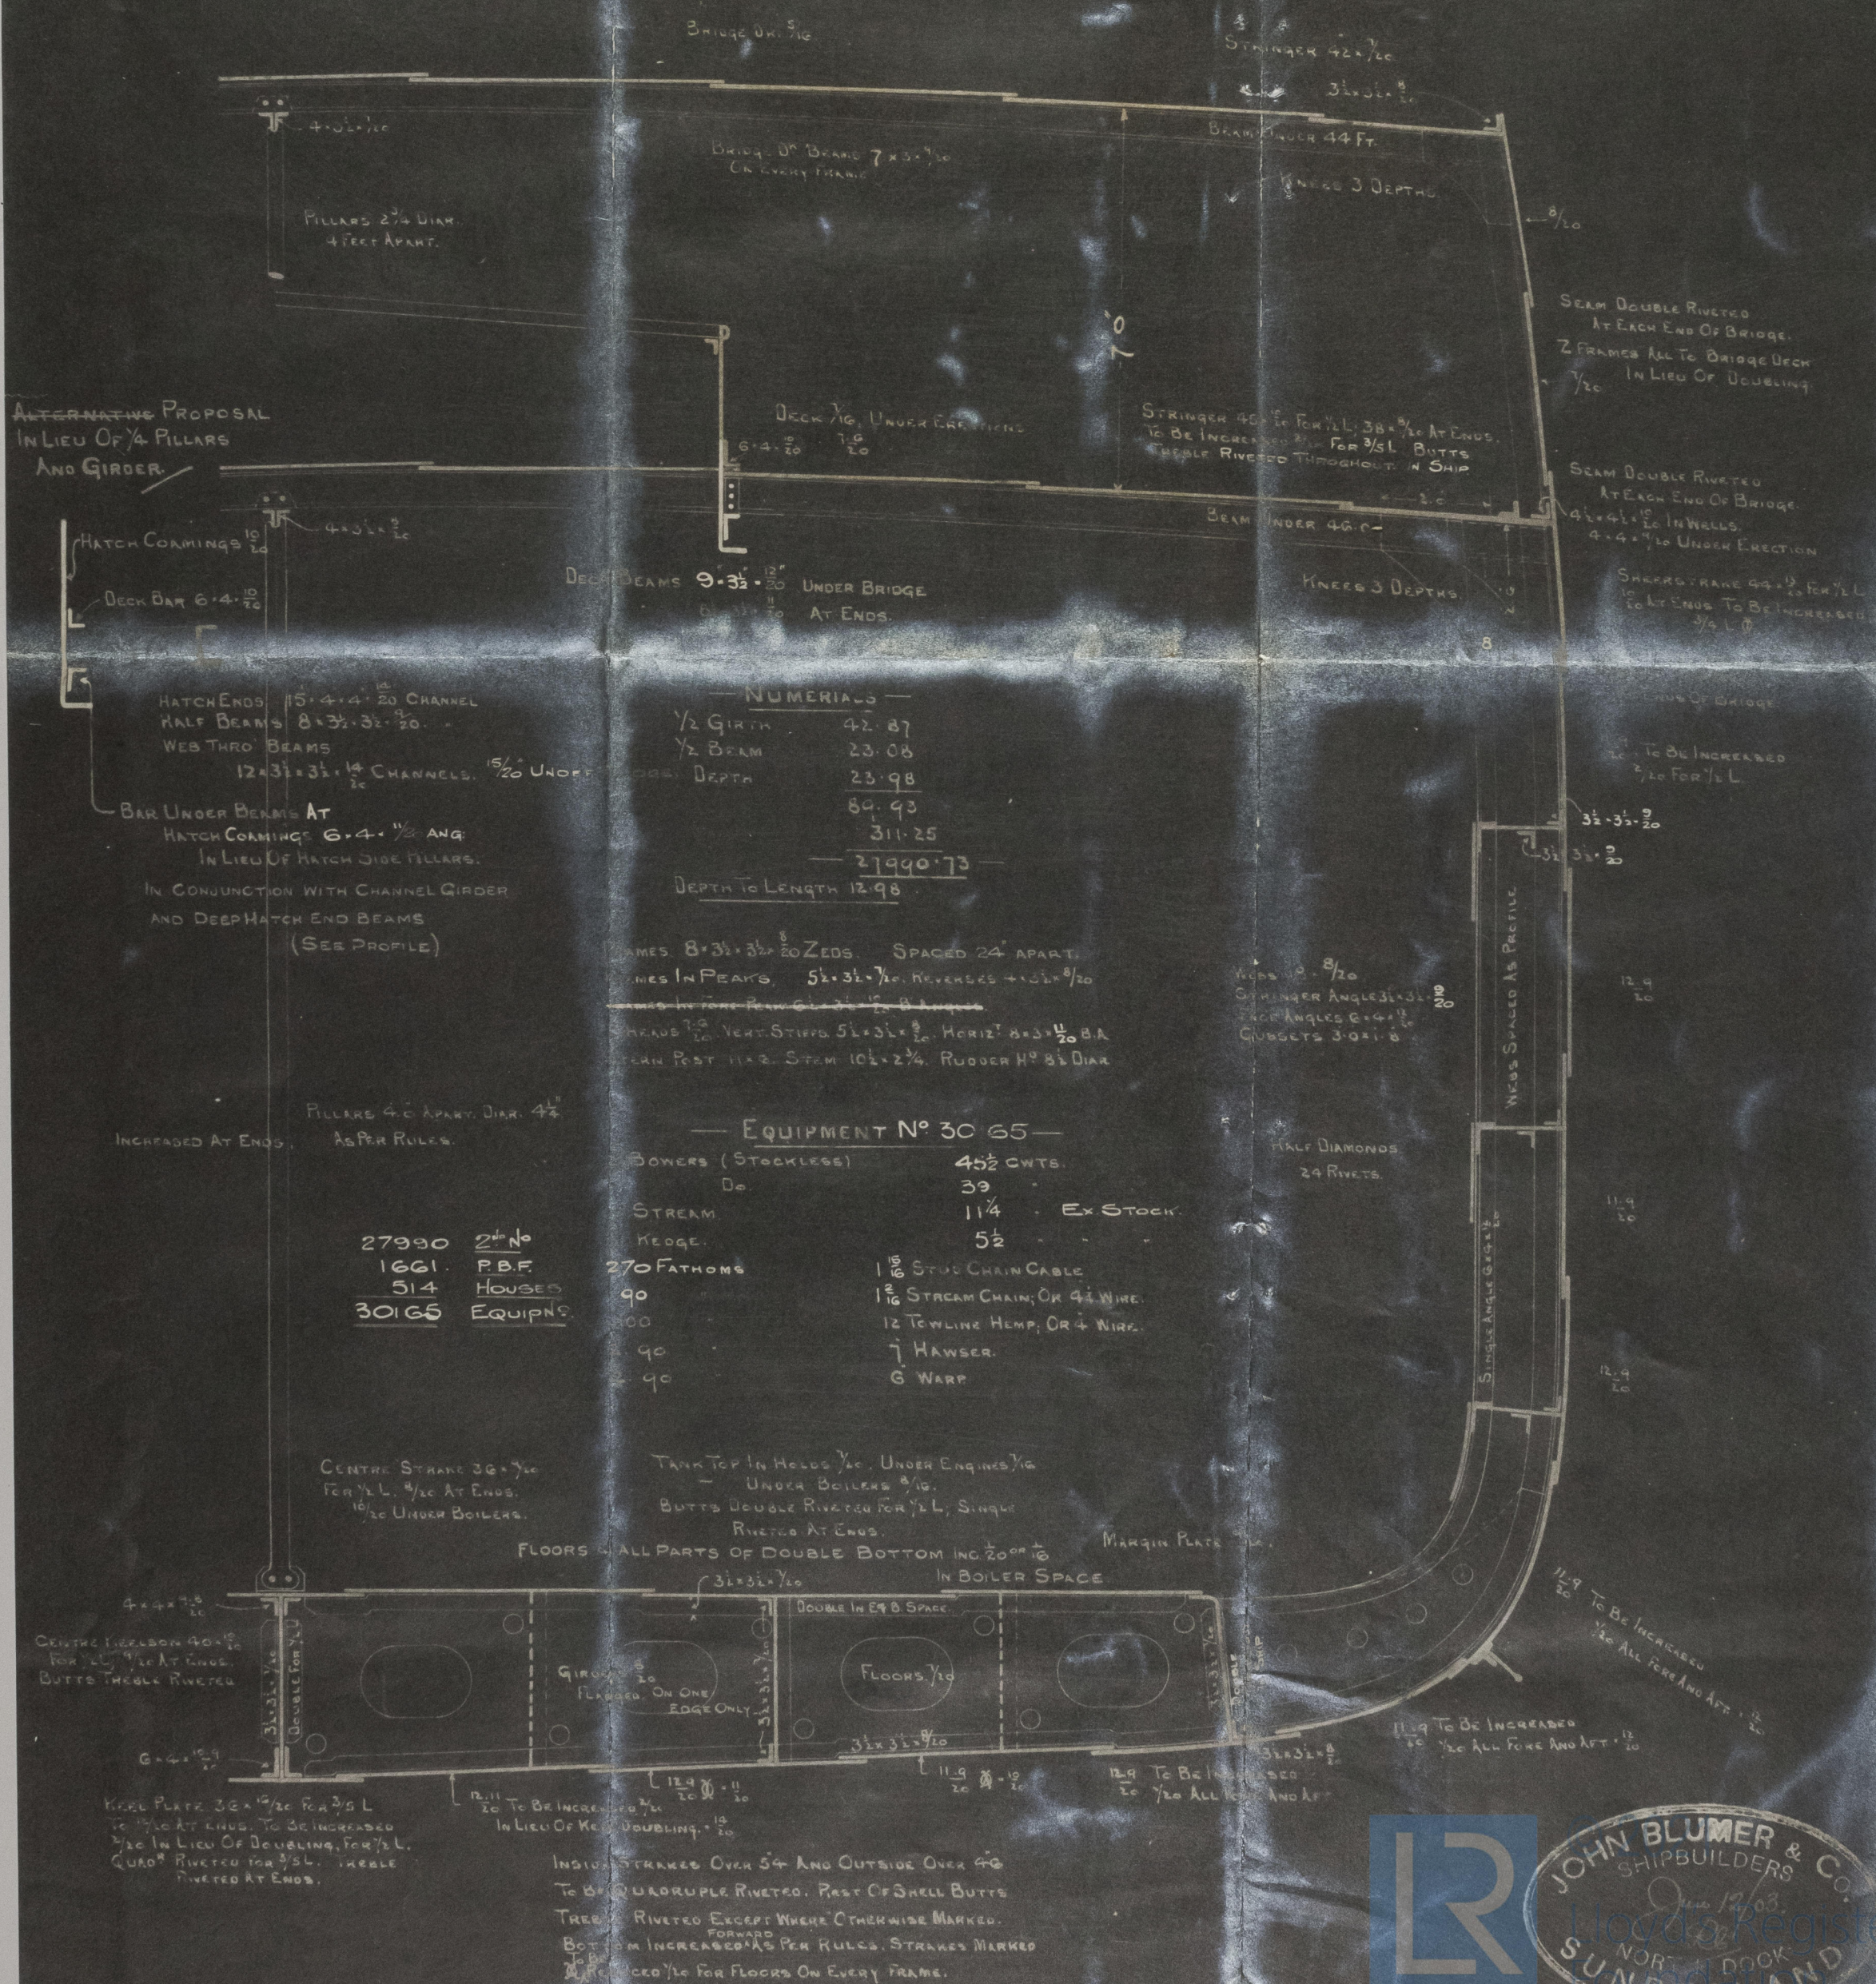



TILDA -  
Friendship Section

Adv. - Bot.

H 40

(COPY)

~~Report~~

12307



© 2021

Lloyd's Register  
Foundation

008305-008313-0111