

WEBSFRAMES BETWEEN
SALTERDECK AND UPPERDECK
ABOVE W- BULKHEAD
NOS 49-68-99-142.

Hand-drawn diagram of a ship's hull section, showing various structural components and dimensions:


- 4" 3/4 x .38" ANGLE**: Dimension for the top longitudinal member.
- WEB PLATE**: Label for the vertical plate between the top angle and the long knee.
- 18" x .38"**: Dimension for the web plate.
- LONG. KNEE**: Label for the vertical structural member.
- DOUBLE LUGS**: Label for the connection point between the long knee and the upper deck.
- UPPER DECK**: Label for the horizontal deck structure.
- 4" BULKHEAD**: Label for the transverse bulkhead at the bottom.

SCALE $\frac{1}{8}'' = 1 \text{ FOOT}$

TO CLASS: LLOYDS 100 A.I. \dagger . (WITH SHELTER DECK).

DOUBLE BOTTOM ARRANGED TO CARRY OIL FUEL.


PROPORTIONS.
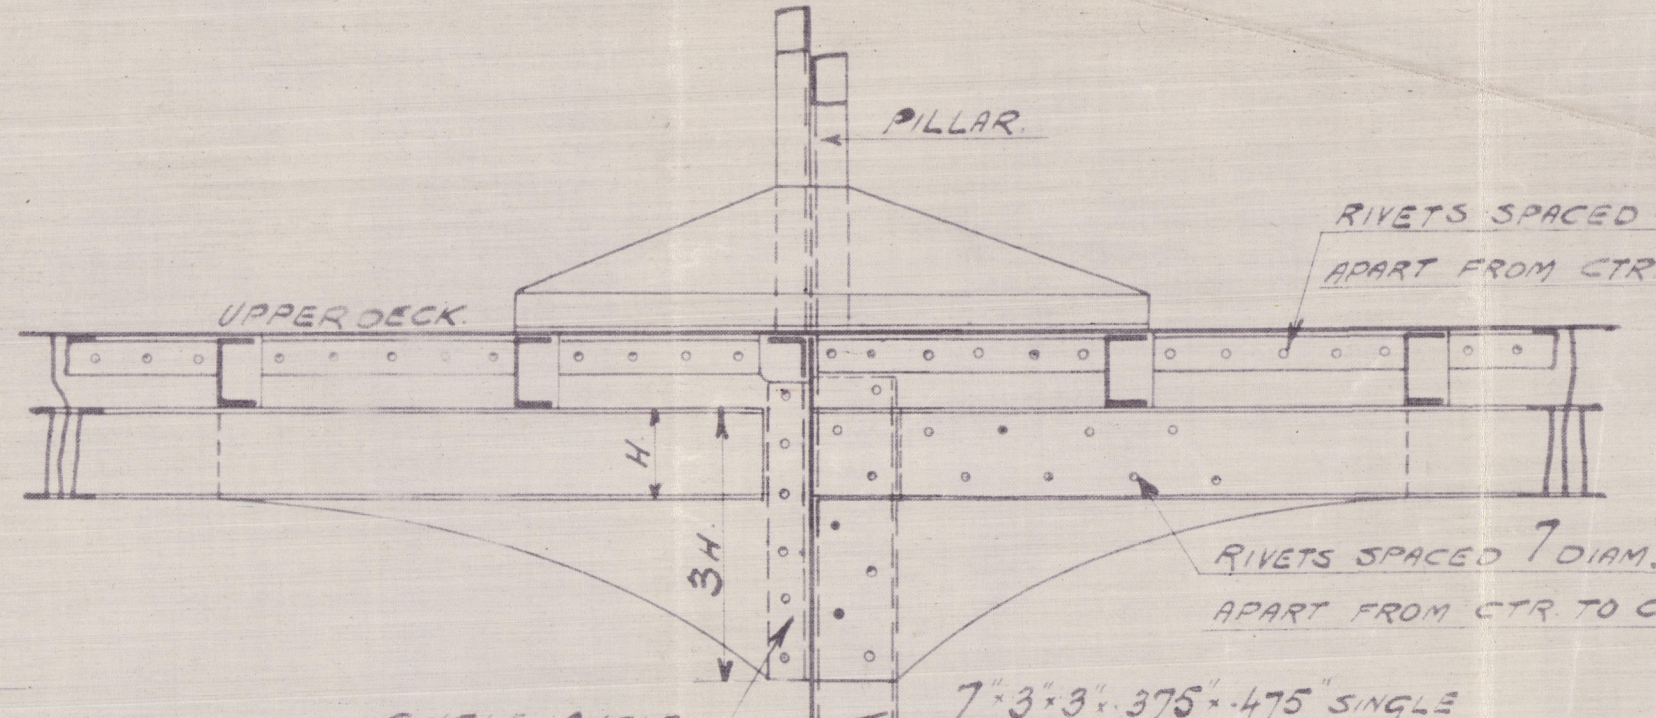
$$\frac{L}{B} = \frac{367}{5125} = 7\frac{1}{6}.$$
$$\frac{L}{D_{50}} = \frac{367}{34} = 10.79.$$


ANGLE
SPACED 30 IN.
FROM CTR TO CTR.

IN WAY OF GIRDER ONLY
KNEE AT LOWER DECK.

SKETCH SHOWING STIFFENING
OF TWEEN DECK BULKHEADS
UNDER PILLARS.

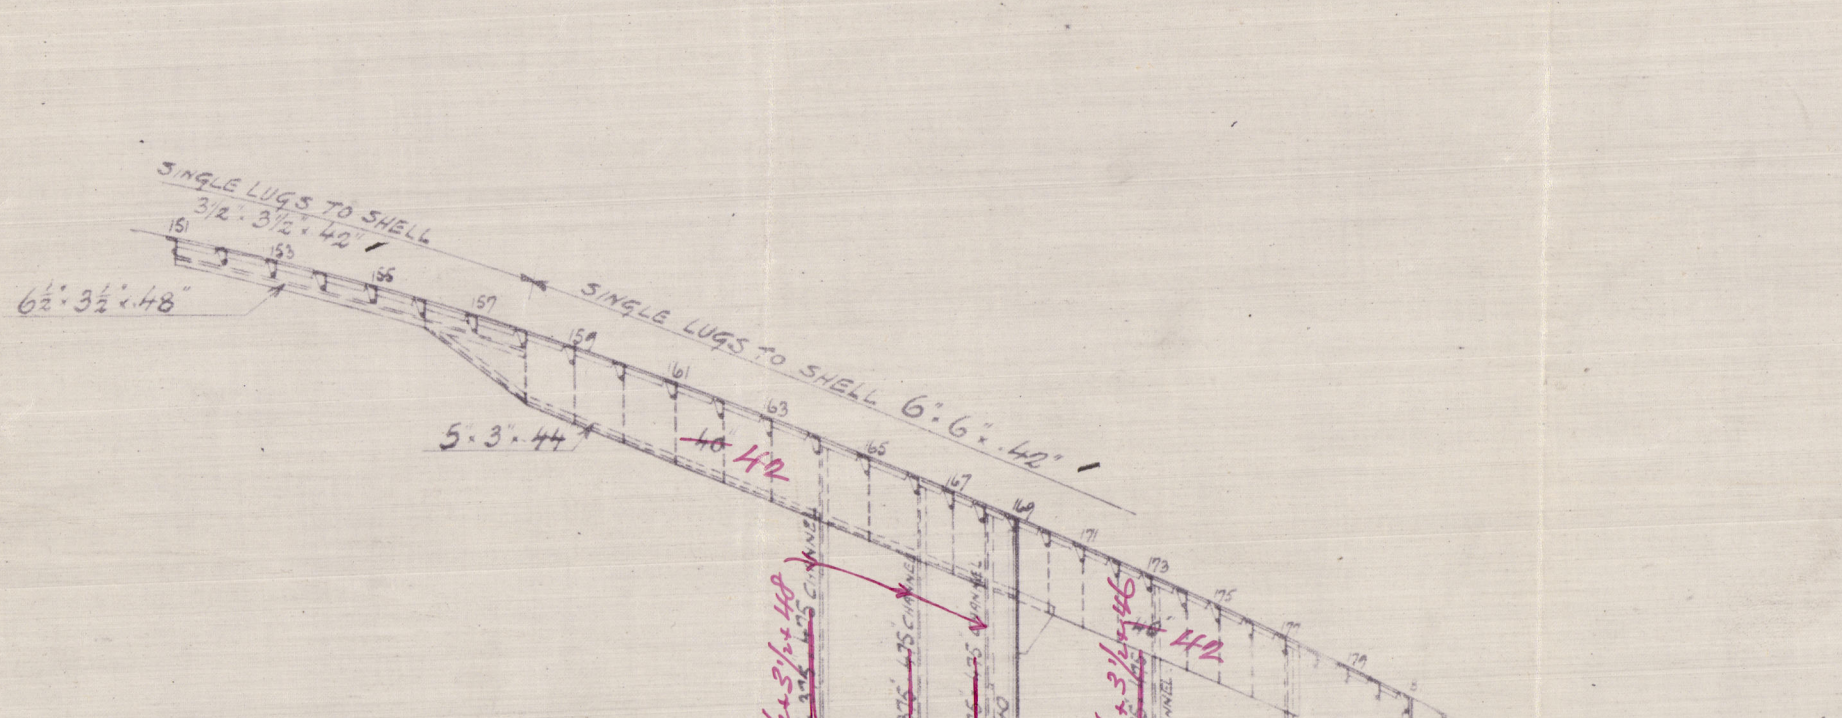[illegible][illegible]

311 "Valparaiso" Cpn. 5365
312 "Lima" Cpn. 5345
313 "Cometa" Cpn. 6213
317 "Kedoe" ^{N/N} Cpn. 6242.

London Week

HAVANA

M/M 6318


589

(B.) 008314-008321-0203
Burmester & Wain
Copenhagen


Newbuildings Nos 311 & 312
for 313 & 317
328, 332
Pedri A. B. Nordström

Stockholm.

Longitudinal section
& Deck plans.

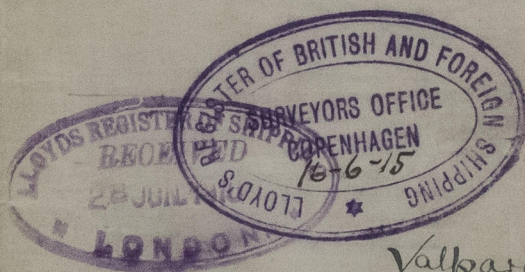

Valparaiso

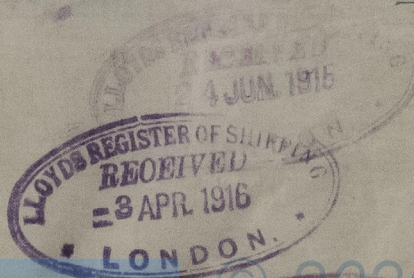

008314-008321-0203

No. 317 m/s Kedoe, Cpn. 6242.