


FOR INFORMATION IN
GOPINSAI & OXNA


DEVONPORT
19 SEP 1946
MOD A 23793

2 SHEETS SHEET 2

589
M 14

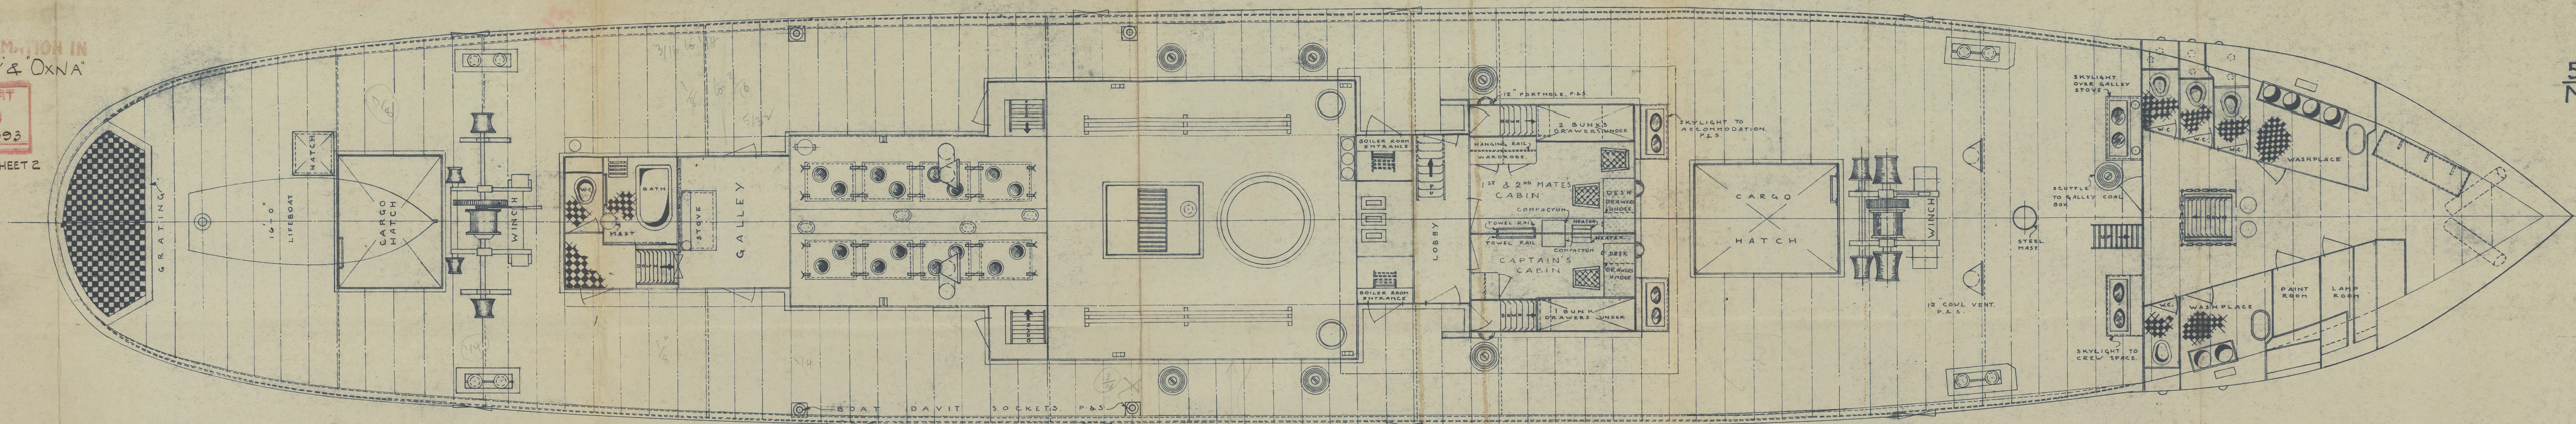


DECK PLAN

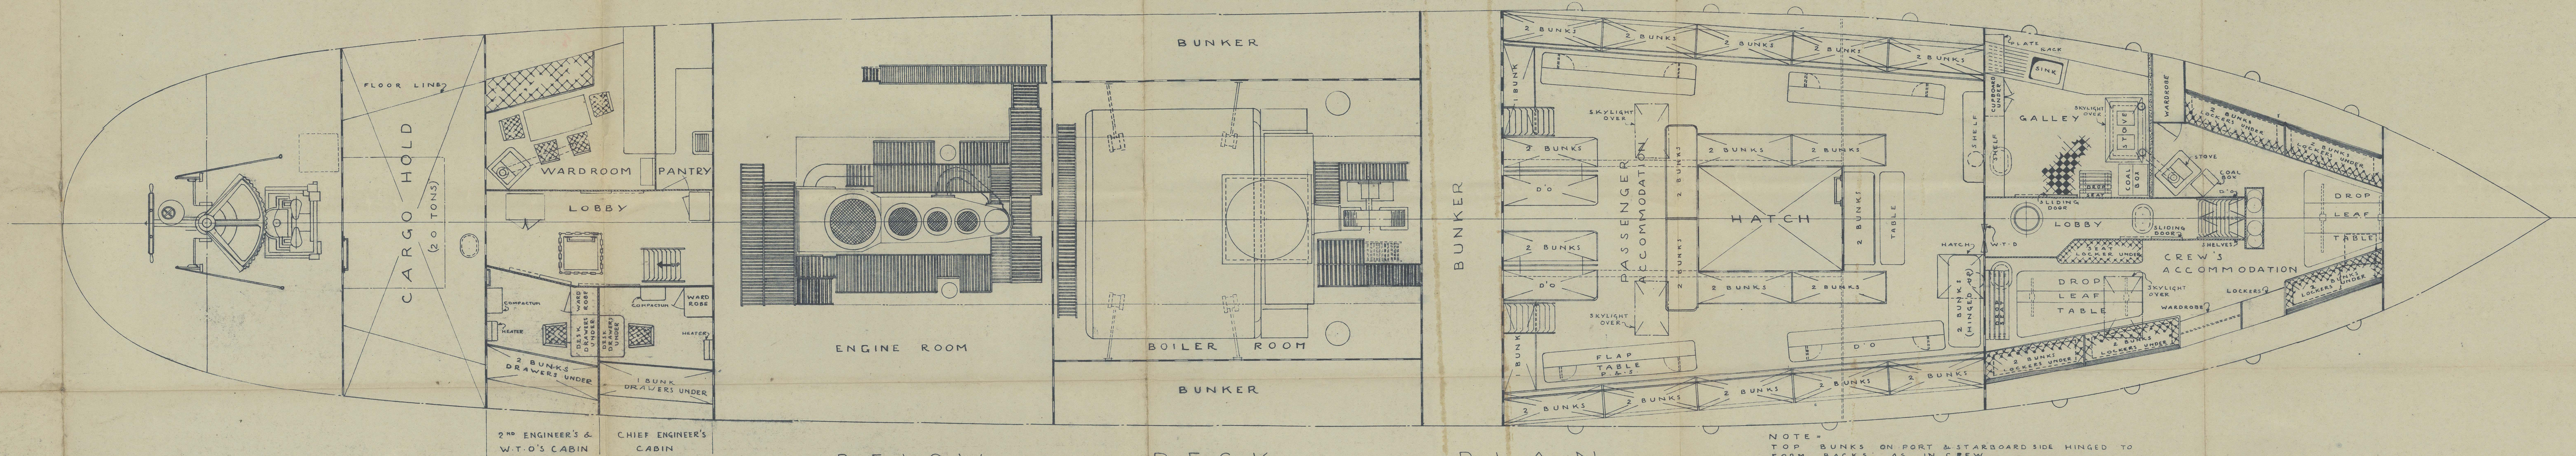

BELOW DECK PLAN

NOTE -
TOP BUNKS ON PORT & STARBOARD SIDE HINGED TO
FORM BACKS AS IN CREW
ACCOMMODATION; LOCKERS UNDER
BOTTOM BUNKS
BUNKS ON FORWARD BULKHEAD HINGED
UP TO LEAVE ACCESS TO HATCH.

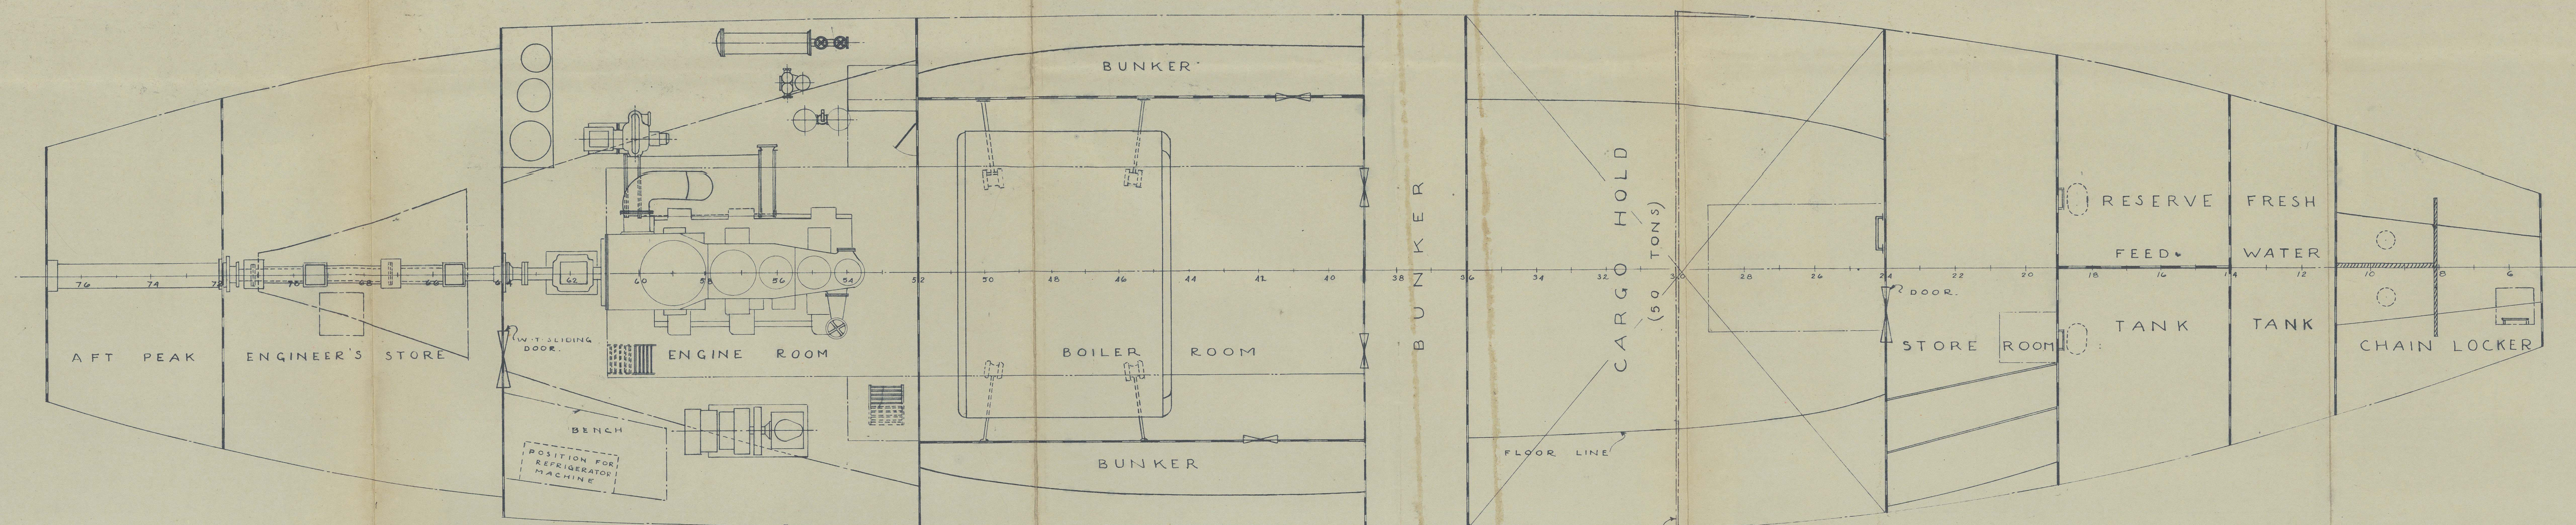

HOLD PLAN

THIS BULKHEAD
MOVED TO FR 36

GENERAL ARRANGEMENT. SHEET No 2
PASSENGER AND CARGO STEAMER FOR R.A.S.C. SERVICE.
[EX 160 FOOT ADMIRALTY AS/MS STEAM TRAWLER]

SCALE, 1/4 INCH = FOOT.

B.H. Keeling 7/5/46
B.H. 21/5/46
David Wilson 21/5/46

R. A. S. C. "Copinsay"

Longway Rept N^o 7884 (7.48)



© 2020

Lloyd's Register
Foundation