


Spaced for drawing, and not to be under that required by the Rules

SCALE 1" = 3'-0"

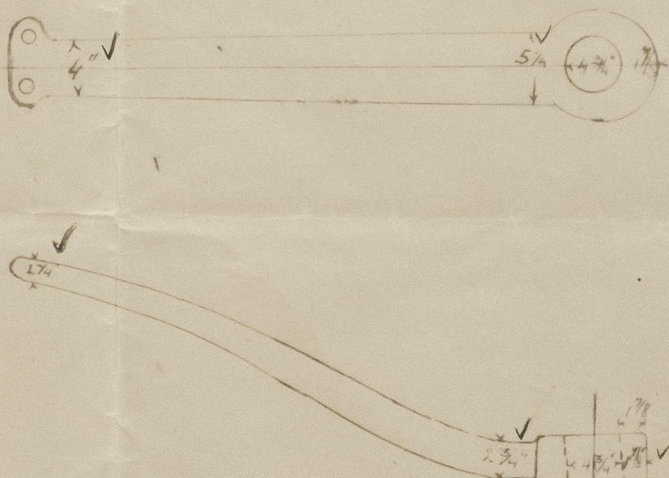

S.S. No 110

RUDDER GEAR.

TO CLASS 1500 A LLOYDS.


SPEED UNDER 10 KNOTS.

Scale 1/2" = 1 foot.


N.Y. SCHEEPBOUWERS, DE MEYERDE  
J.H. VAN LIET & CO.  
HARDINXVELD. (HOLLAND.)

DETAIL SCALE 1" = 3'-0"


DETAIL OF STOPPER.

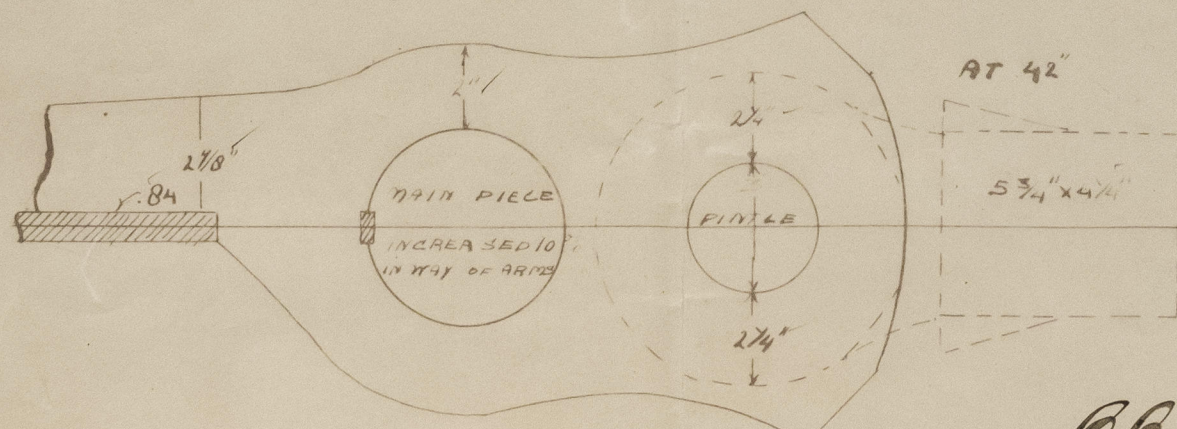

DETAIL OF SUDGEON

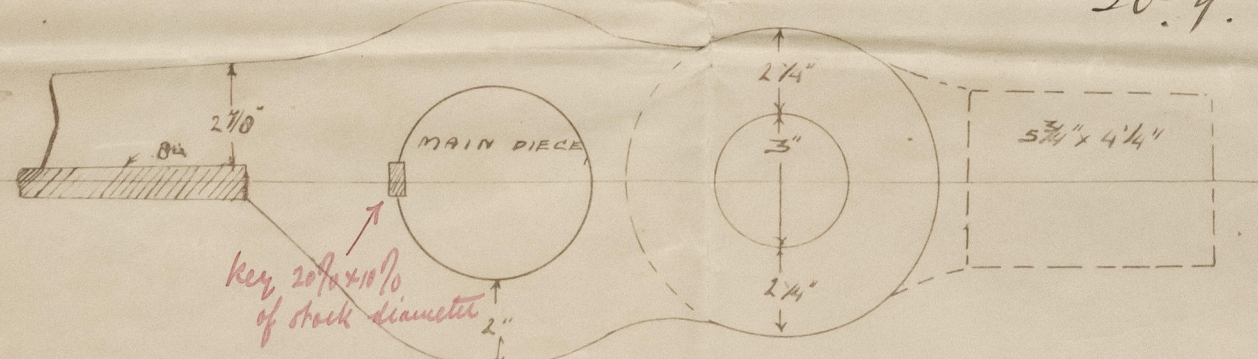

ccf  
30.9.13.

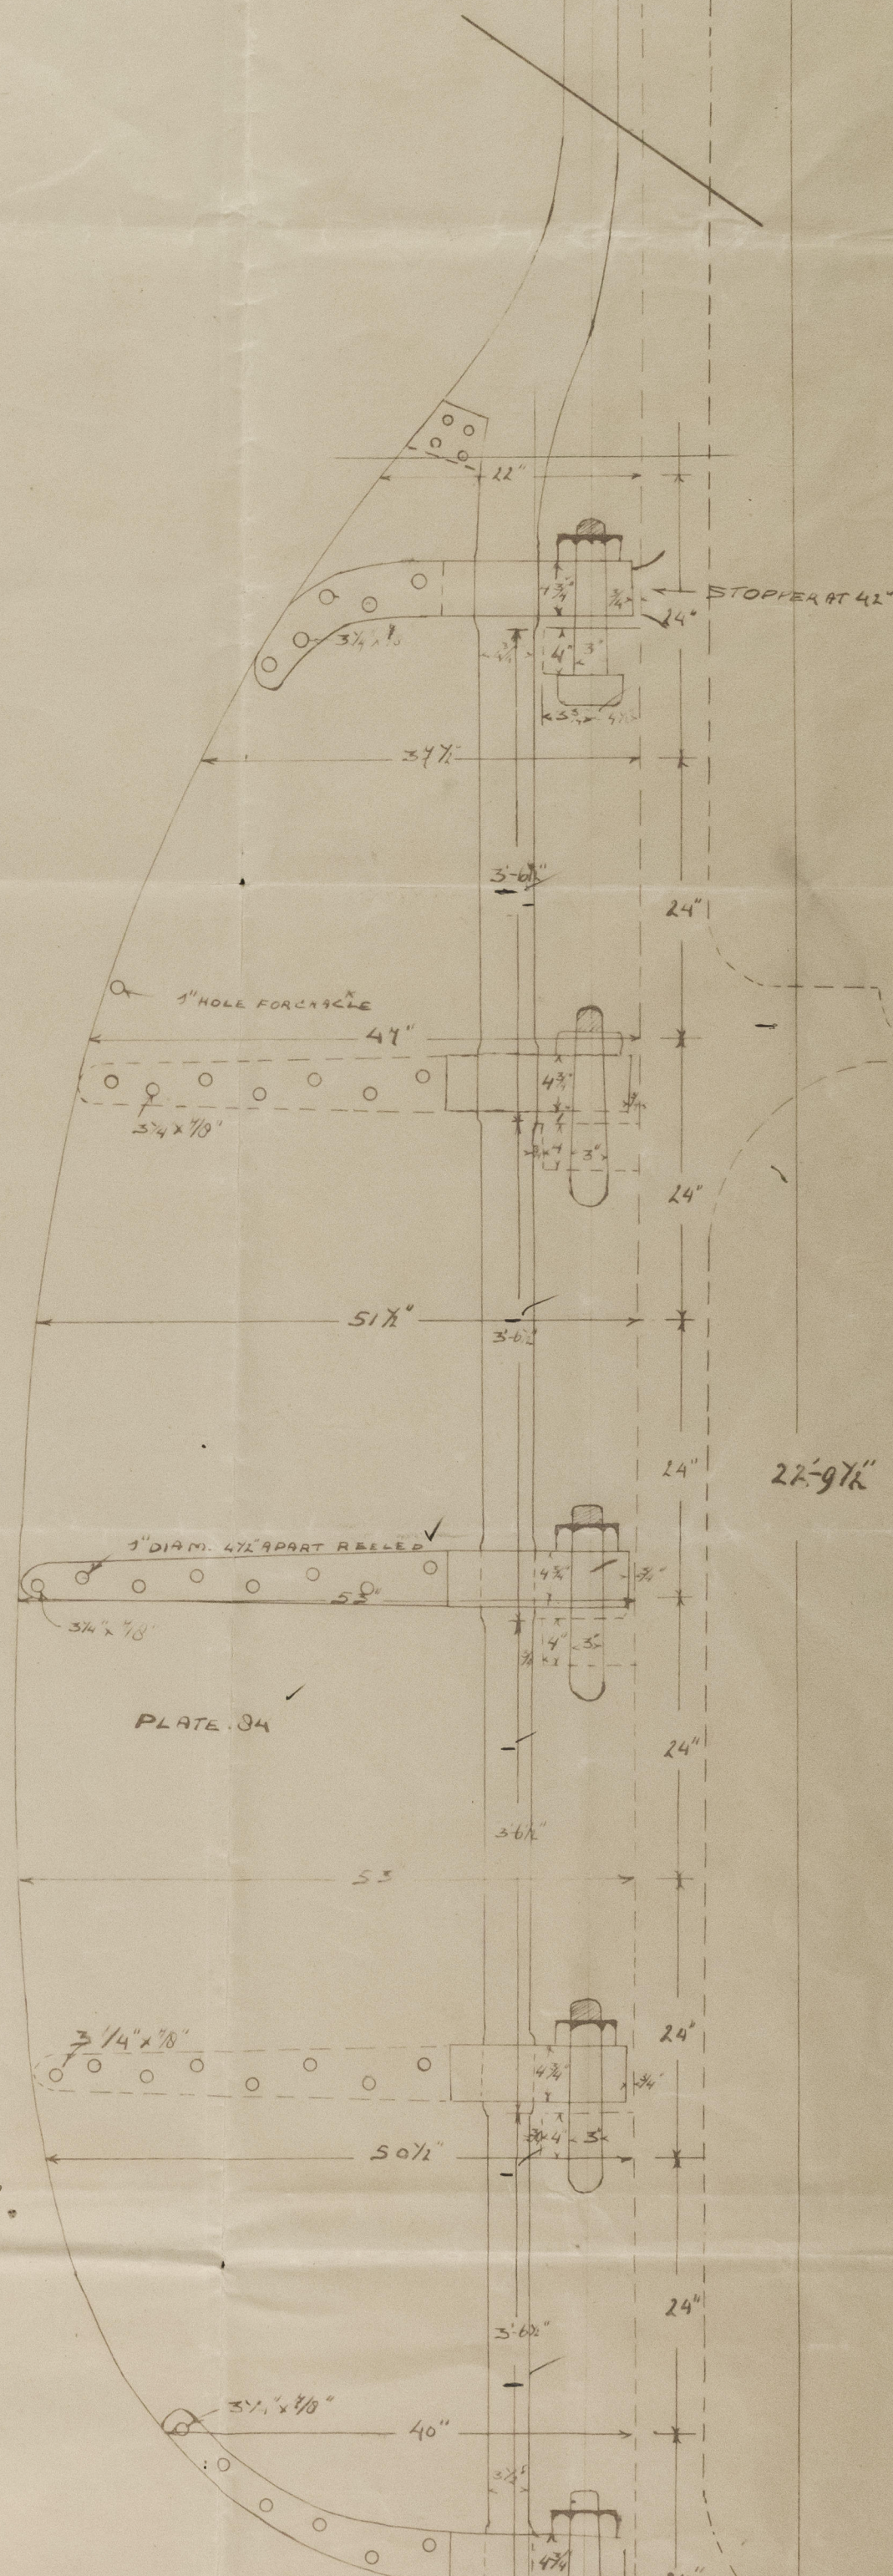

In accordance with  
Lloyd's approved plans.





110

---

*Rotterdam Report N<sup>o</sup> 9097*

*S.S. "Island Queen"*

*Rudder & Quadrant*

---

008344-008353-0185



© 2020

Lloyd's Register  
Foundation