

180'-0" x 28'-0" x 34'-6"

TO CLASS 100 A1, LLOYDS


23.9.13.

N.V. SCHEEPSBOUWWERF

" DE MERVEDE "

Y. H. VAN VLIET & C^o

HARDINXVELD - HOLLAND.

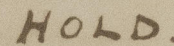


Framing increased .04" in thickness
in way of 29' 4" notch.

Intercostals to be fitted in way of wide $\frac{1}{2}$ in. \rightarrow
Spaced pillars No manholes to be removed out of pane

CCF
30-9-13.

BOTTOM BEFORE $\frac{1}{2}$ h. STRENGTHENED AS PER RULES.
See Sec. 4 par. 6.

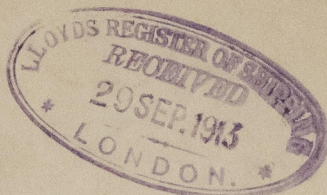

110

Rotterdam Report No 9097.

S.S. "Island Queen"

Profile and Deckplan

Tasman

D.S. 604



© 2020

Lloyd's Register
Foundation

008344-008353-0188