

20-10-13

# GENERAL ARRANGEMENT OF SEAGOING LIGHTER

NO 271

DIMENSIONS

LENGTH 102'-6"


BREADTH 18'-5"

DEPTH 10'-3"

SHEER FORE & AFT 2'-3"

SCALE 1/4" = 1 FOOT


SCARR & SON, HOWDEN

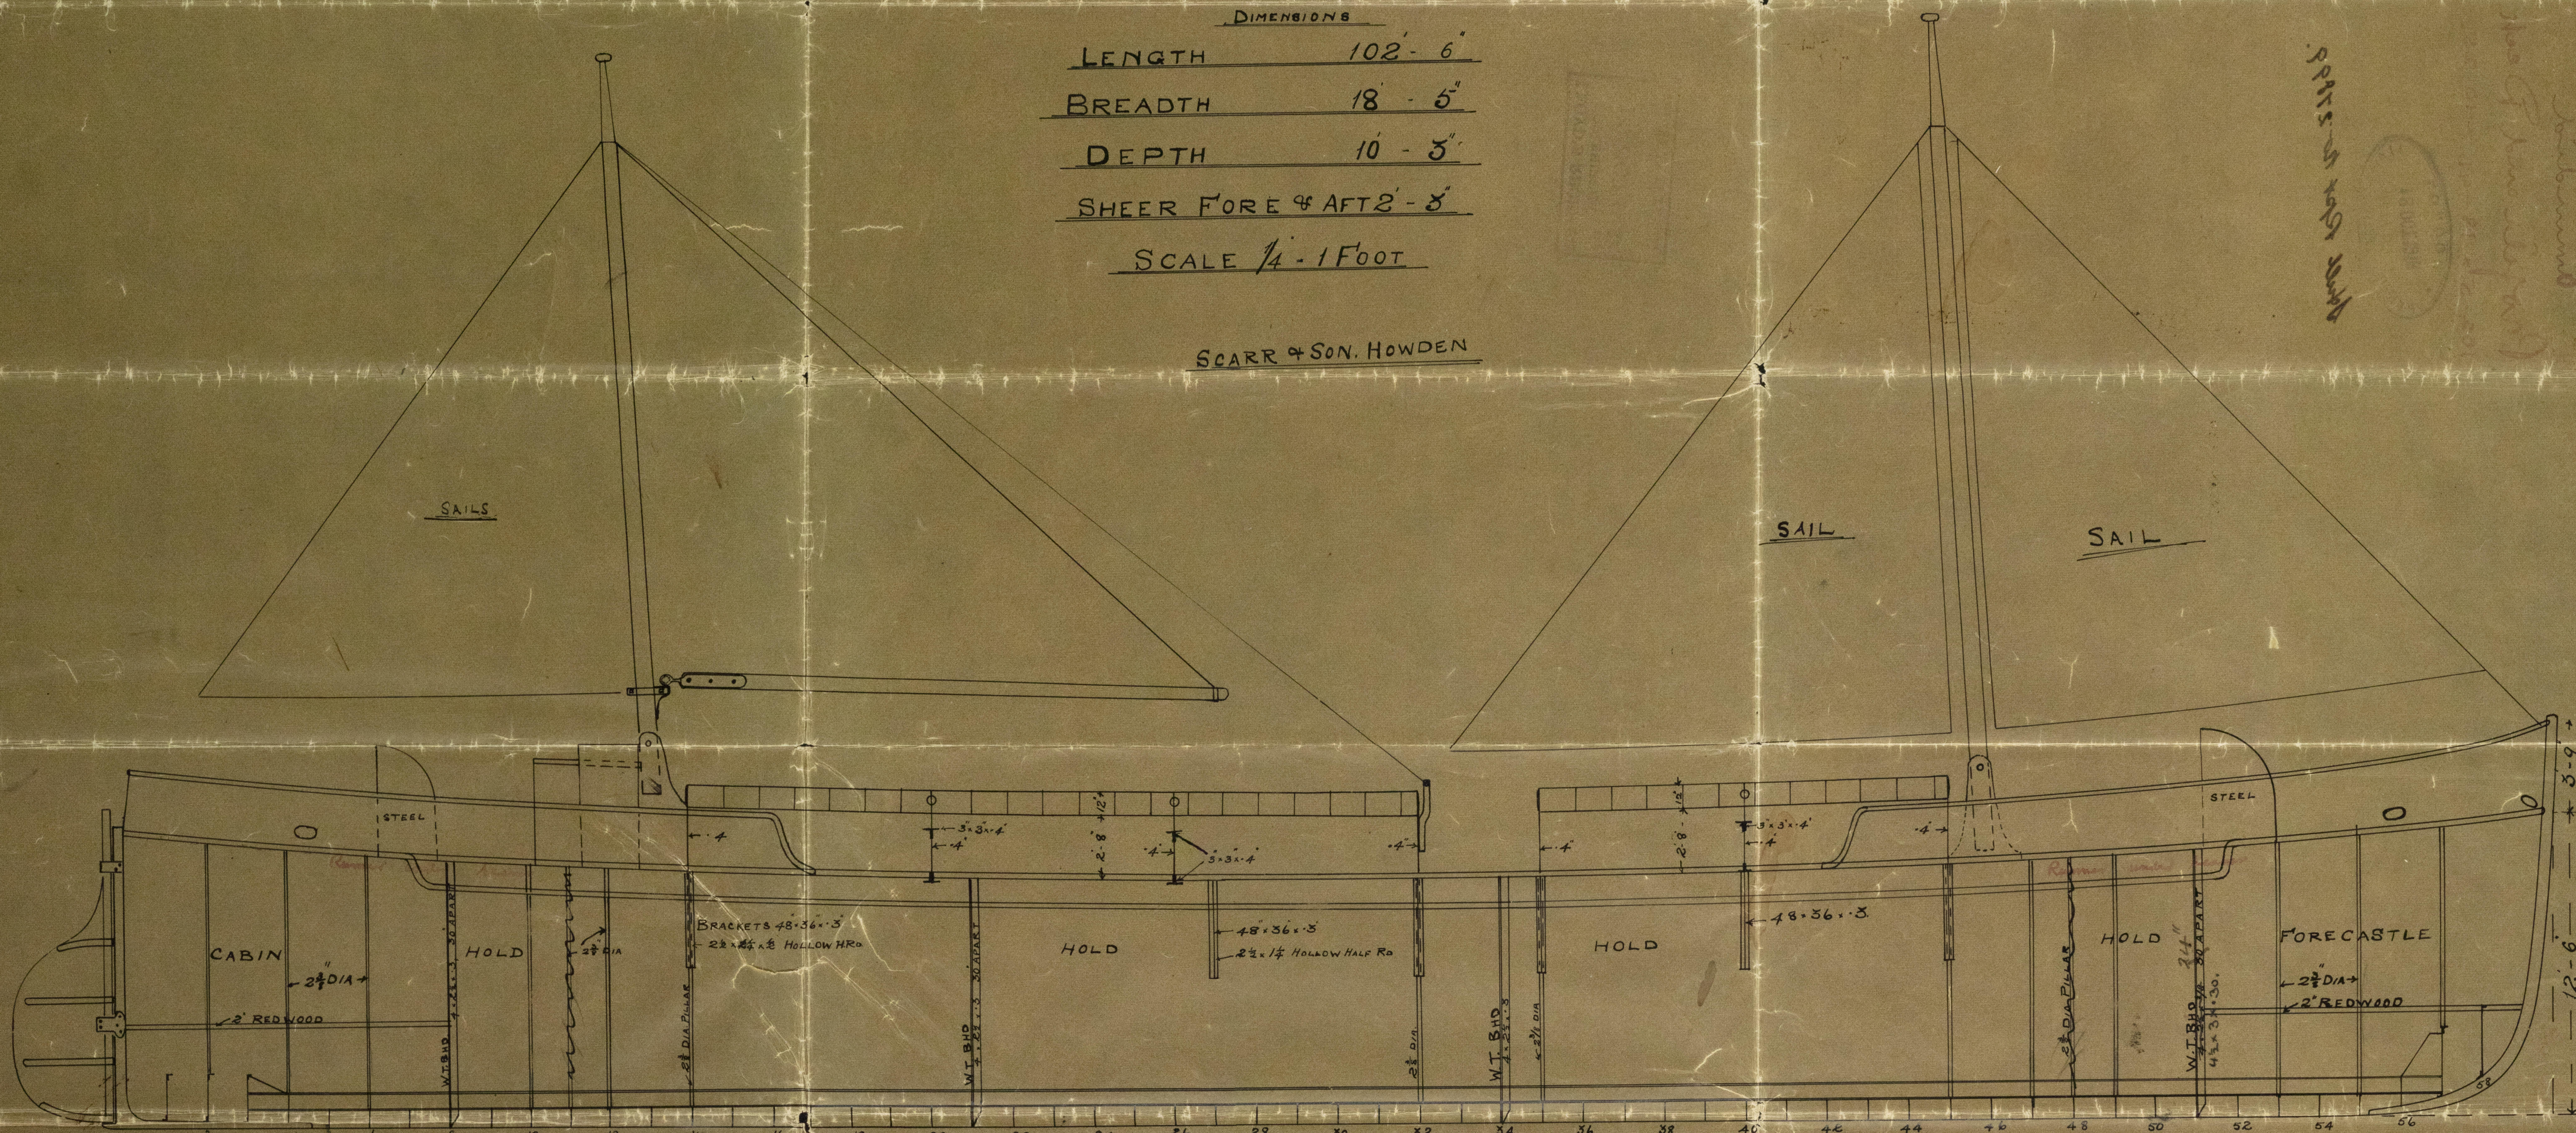

102'-6"

Masts supported to Surveyor's satisfaction.

Plans throughout to Surveyor's satisfaction.

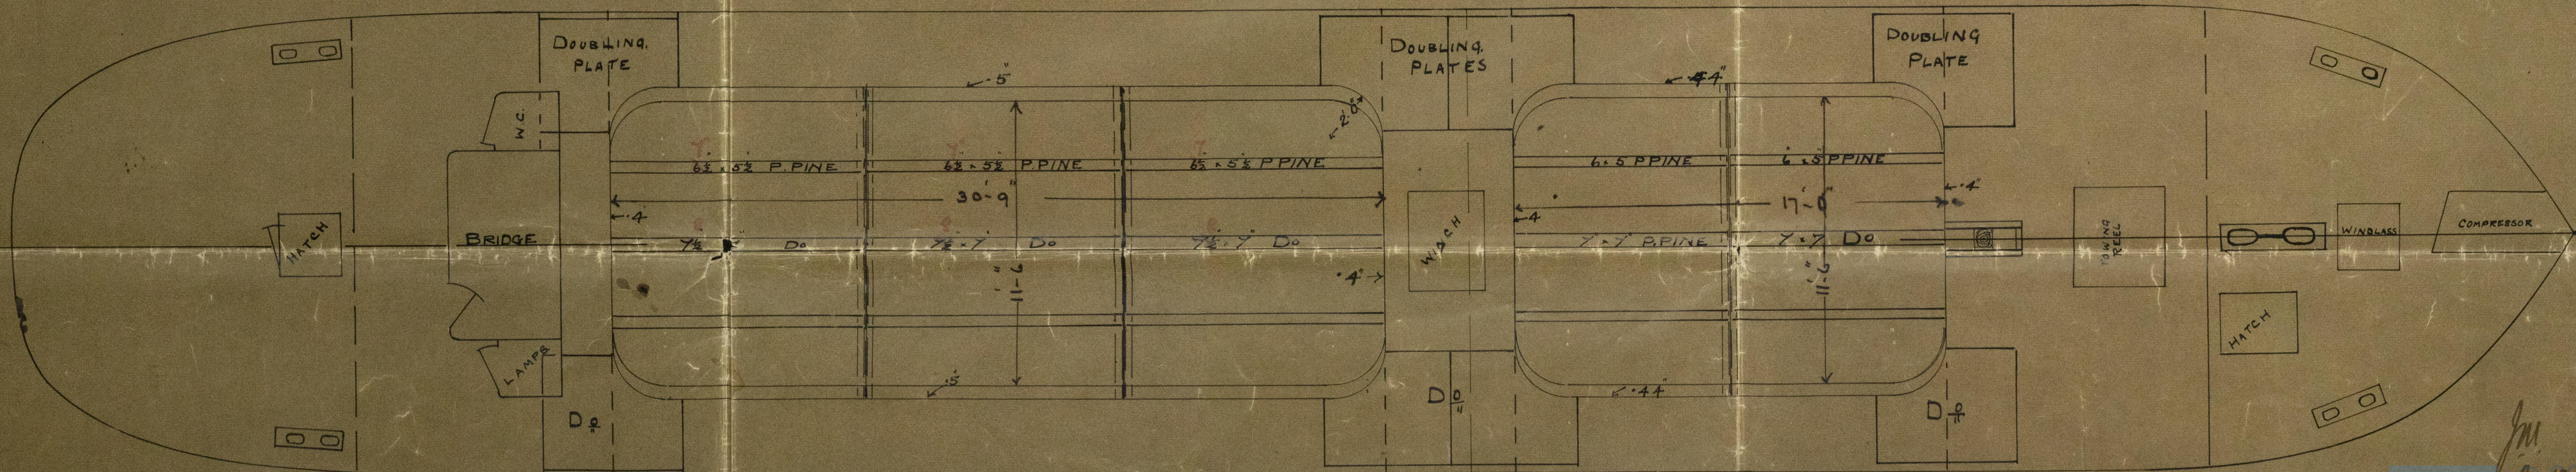

20-10-13

Lloyd's Register Foundation




Dean & Son.

No 241

amended

Profile and Deck

102.5 x 18.41 x 10.25.

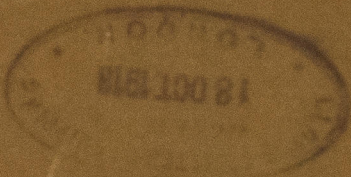

Stull Rpt No 27899.



© 2021

Lloyd's Register  
Foundation