


AMENDED
PROFILE TO CLASS 100A1 AT LLOYDS.
LENGTH B.P. 240'0" BREADTH M^{LD} 36'4" DEPTH M^{LD} 16'6"

Nº 134 SHIP.

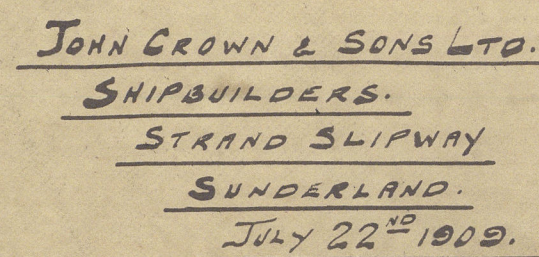

Collision Bulkhead moved onto #18 frame
Fore Hatch Extended 2 spaces forward, and
Cummings of Fore & Main Hatches made $\frac{1}{3}$ " high.

LAMP	FORE DECK
WORKER	
	STRINGER S.B.

After & After main Hatch Cummings made $\frac{2}{6}$ " high.
Extra Strong Keam to be fitted on Side Stringer on #16 frame.
" " " " " " " " Painting Slinger " " "
Wash plate in Peak Extended to #23 frame.

Oct 14th / 09.
add. 2021
C.F.
18/10/09.
Lloyd's
Founda
008386-00839

J. Crown & Sons

N^o 134

Further amended
Profile & Deck

J.S. "B. indicar".
Sld Y.C. no. 241332.



© 2021

Lloyd's Register
Foundation

008386-008342-0022

"HELLENIC CHRYSSOULA"

SLD.24332.

008386-008392-0072



© 2021

Lloyd's Register
Foundation