
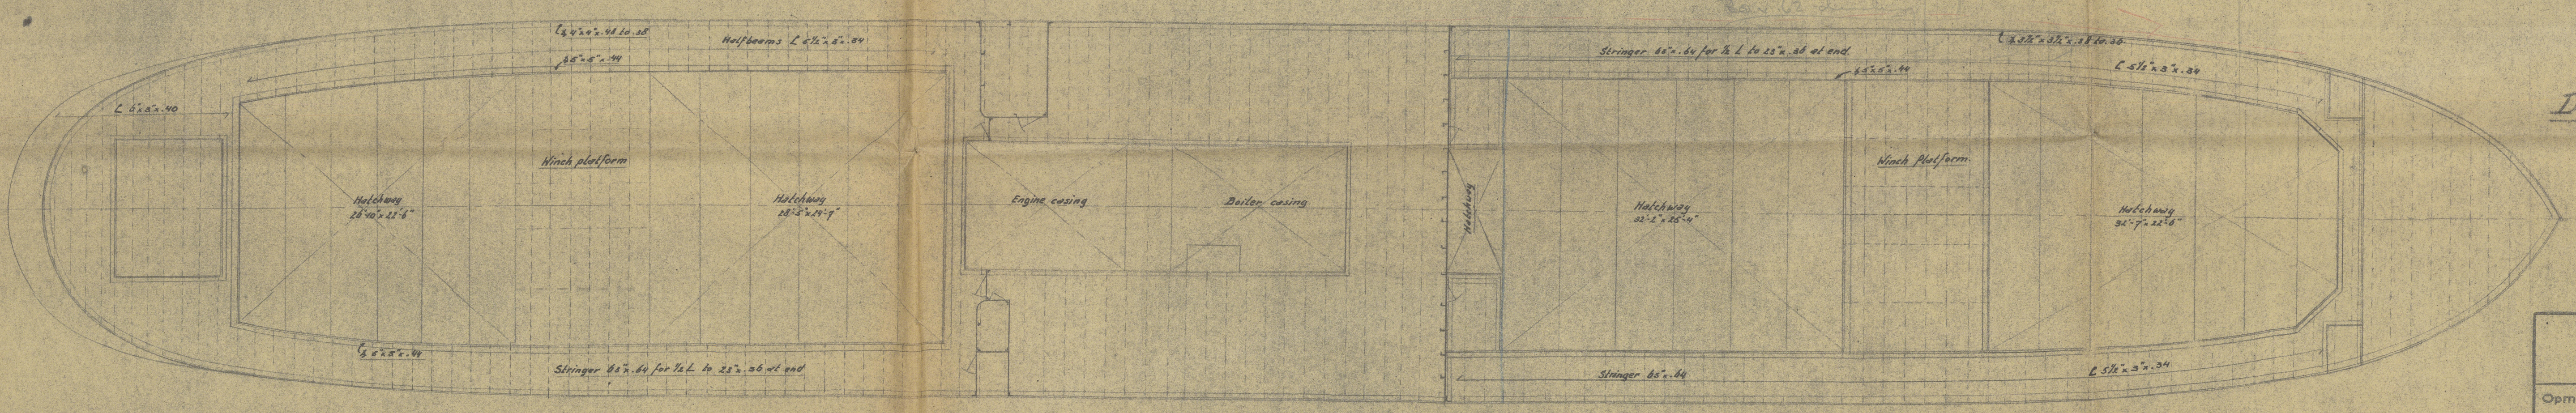


12 SEP 1947

Approved
25 9 47
W. J. J. J. J.

240' 00"
8' 00"
248' 00"

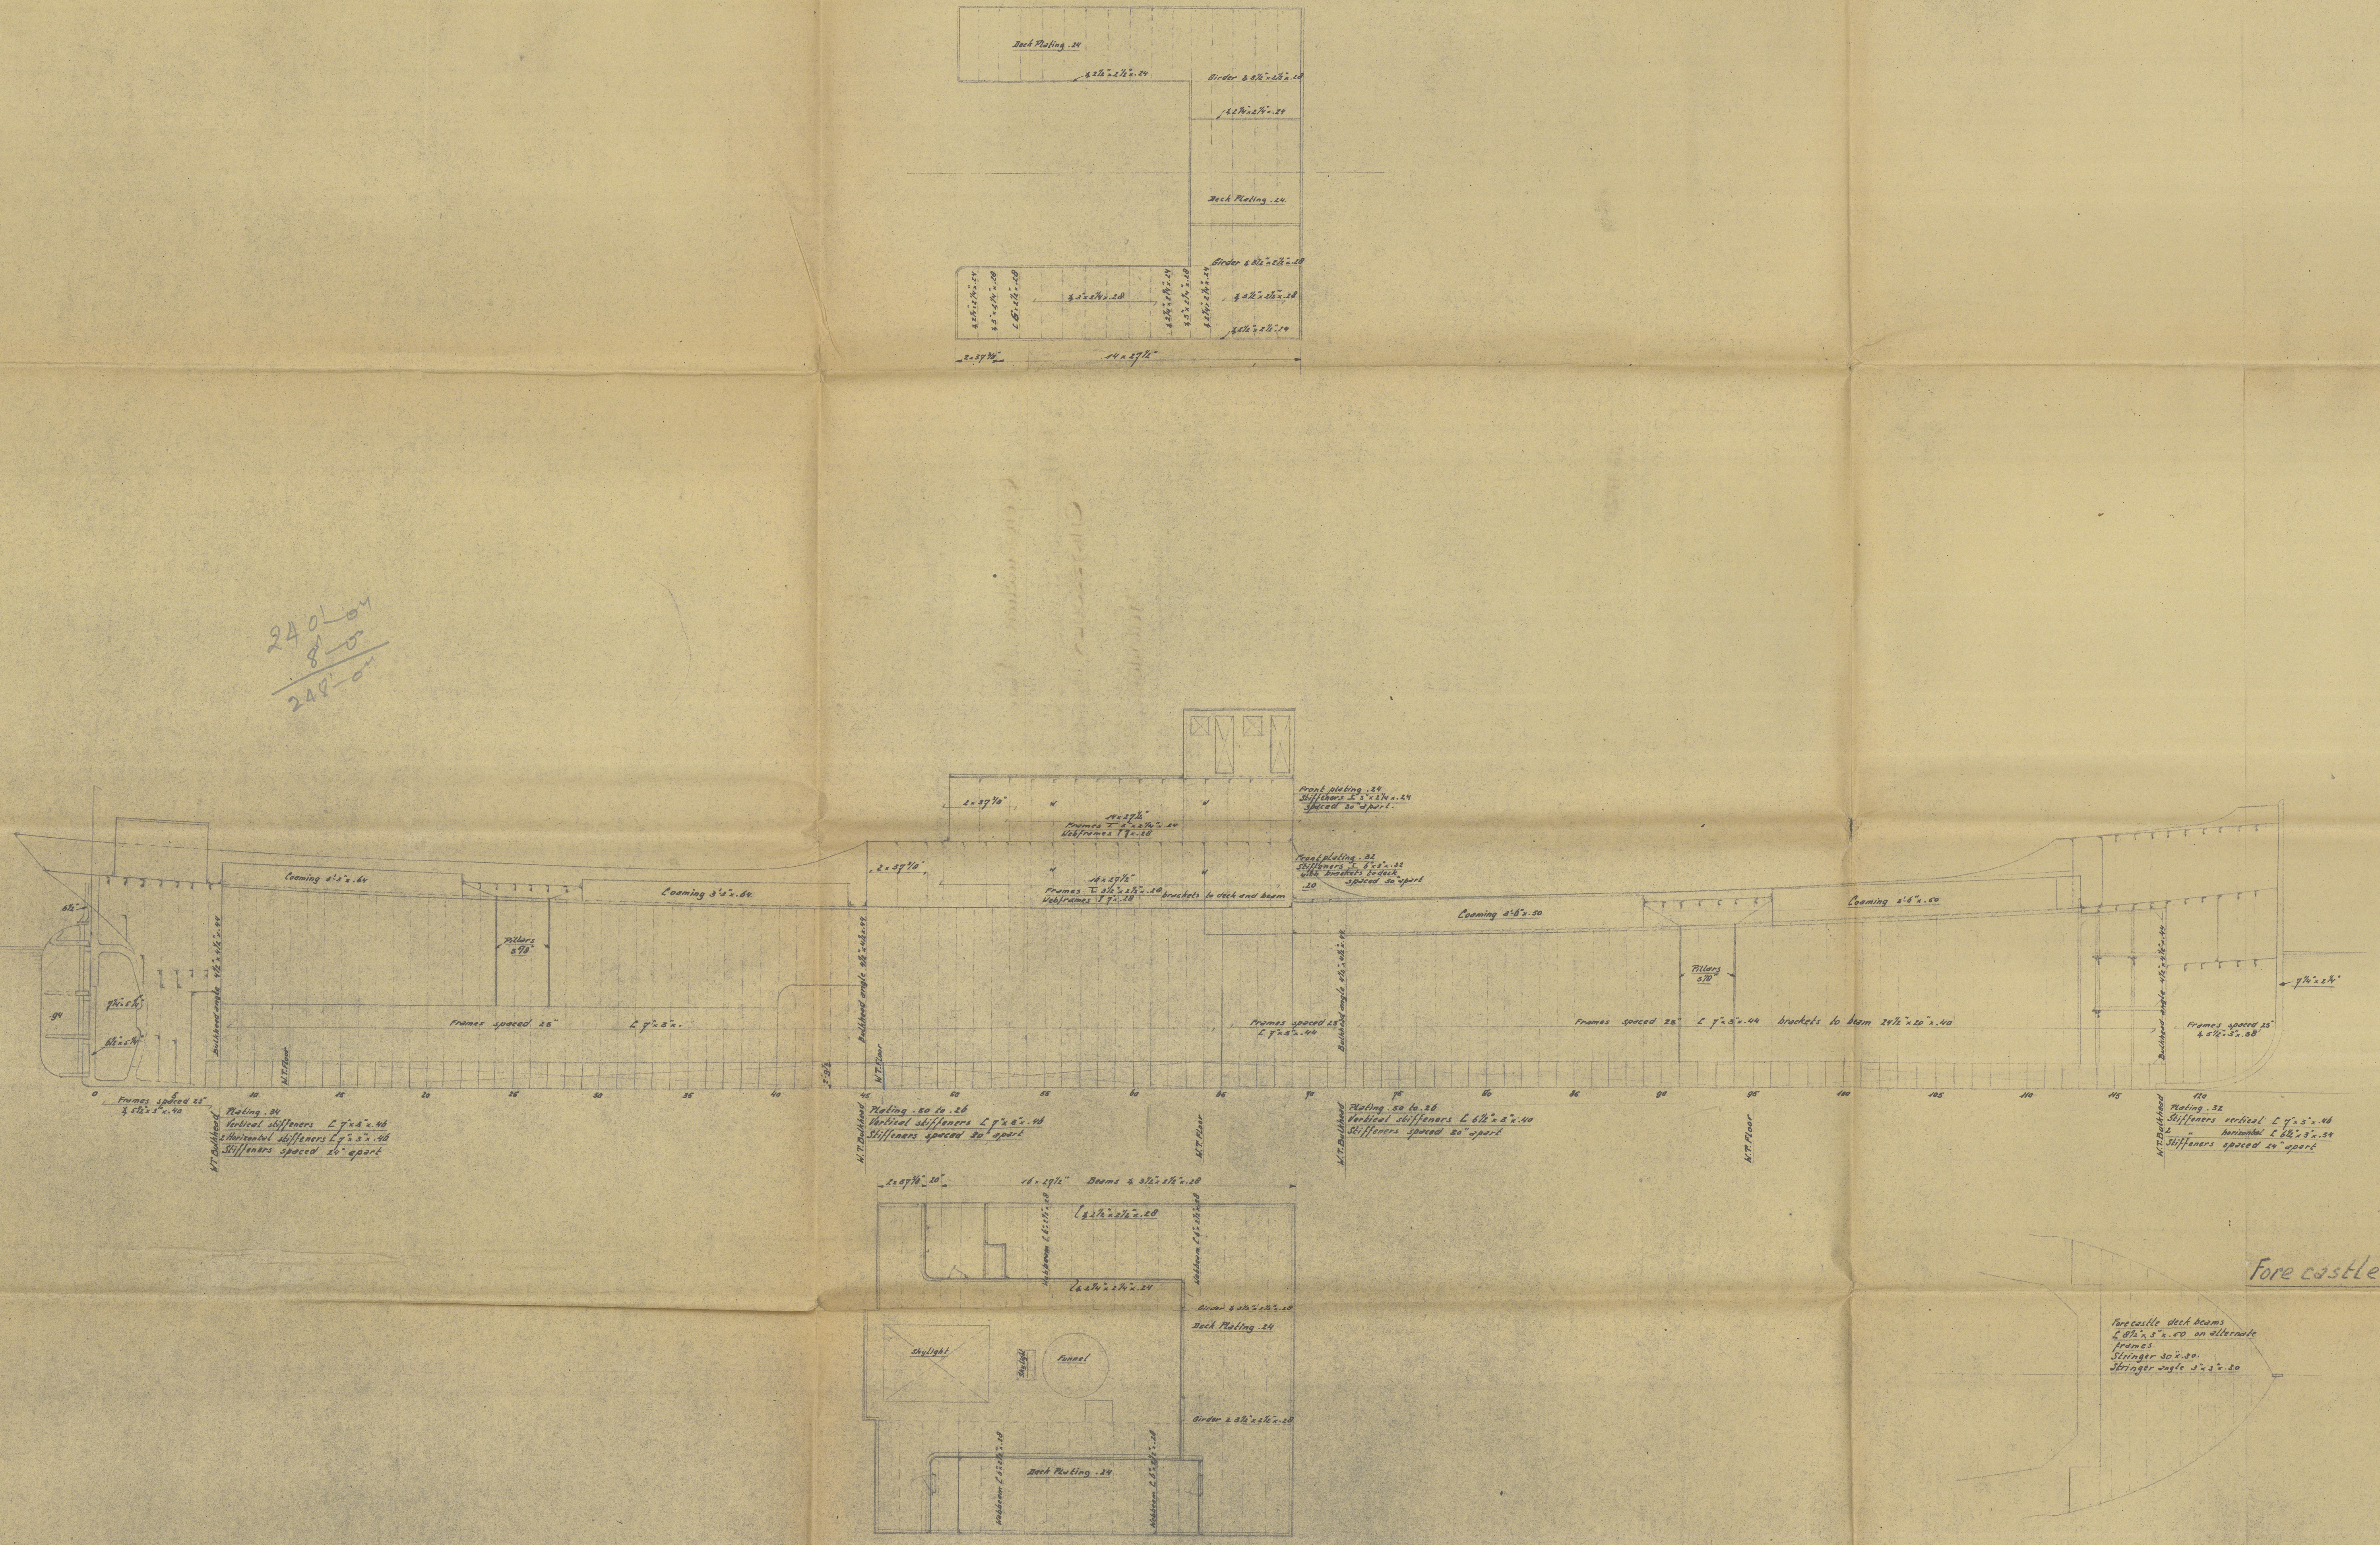

Fore castle

Deck plan

Construction plan			
Opmerkingen		Object: S.S. Chrysoula	
Get.		Formaat: 021	
Gealg.		Tek. No. 4625	
Gez.		Looij: Register	
Schaal	1:100	Aanv. No. 008386-008342-0028	

2

TRANSFERRED TO:
L. R. SYSTEM

Construction Plan

$\frac{5}{2}$ HELLENIC CHRYSSOULA

EX $\frac{5}{2}$ CHRYSSOULA HELLENIC

Rotterdam 25.9.19.

Boag

008386-008392-0028

192 SEP 1947

$\frac{5}{2}$ Chryssoula ex Rotterdam

1947 x 36.14" x 16.16"



© 2021

Lloyd's Register
Foundation