


For the information of Surveyors and the Committee only.

Received at _____ Office, _____

Lloyd's Register of Shipping.

(Report on Vessel No. 31342 Port Hull
S/S Limeslade)

SHIP FORGINGS OR CASTINGS

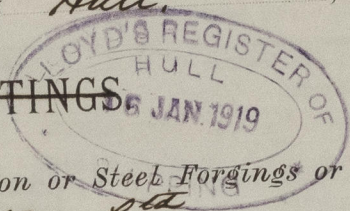

I have to report that the undermentioned Iron or Steel Forgings or Castings, manufactured by Messrs J. S. Forster & Son Ltd of Sunderland for the Vessel No. 414, being built by Cook, Helton & Hemmell Ltd of Beverley have been inspected by me as set forth below and found to be, so far as can be seen, Sound

These forgings made in 409 M.B.


D's
837

D.D. Williamson

Sunderland 14-1-19

	STERN FRAME.	RUDDER FRAME.	STEM.
...	<u>Scrap Iron</u>	<u>Scrap Iron</u>	
...	<u>Forged</u>	<u>Forged</u>	
...	<u>6" x 3"</u>	<u>4 1/2" dia 4 1/2" x 4" to 3 1/2" x 3"</u>	
Inspection ...	<u>Forged & Finished</u>	<u>Forged & Finished</u>	
Inspected	<u>10-8-18 to 28-8-18</u>	<u>14-10-18 to 14-1-19</u>	
INGS.			
Standard Test			
es.			
are inch			
er cent.			
Test—			
fracture			
ground ...			
Test—			
ording to Rules /			
satisfactory ...			

SKETCHES OF FRAMES SHOWING POSITION AND DESCRIPTION OF WELDS OF FORGINGS.

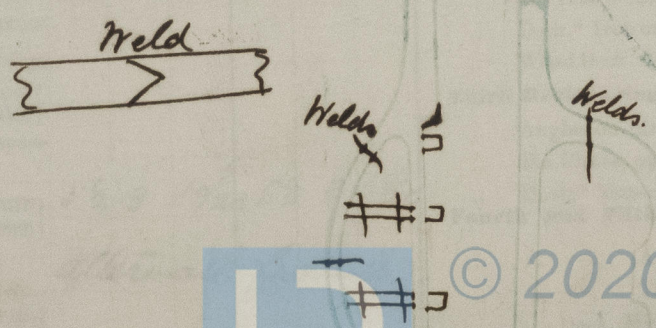

f any chargeable) £
be paid at

on, state whether scrap or puddled Iron. If of Steel, state whether made on the Open Hearth process.