

S.S. N^{os} 13 to 24

PROFILE AND DECK PLAN

DIMENSIONS 240'-0" BP x 35'-6" MLD. x 17'-3" MLD.

SCALE 1/8" = 1 FOOT.

CLASS * 100A1 AT LLOYDS

APPROXIMATE PARTICULARS FOR FREEBOARD

REGISTERED DIMENSIONS 235-9 x 35-70 x 14-50 (LENGTH ON L.W.L. = 239'-3")

UNDER DECK TONNAGE (APPROXIMATE) 1009 TONS

SHEER AT STEM 6'-0" AT 1/8 LENGTH FROM STEM 3'-3 1/2"


" " STERN 3'-0" " " " STERN 1'-8"

BRIDGE FRONT: OPENINGS CLOSED WITH LOOSE PLATES AND WEATHER BOARDS

AFT END OF BRIDGE: OPENINGS CLOSED UP WITH WEATHER BOARDS

POOP: OPENINGS CLOSED UP WITH WEATHER BOARDS

FORECASTLE: BHD. CLOSED UP WITH STEEL DOOR.

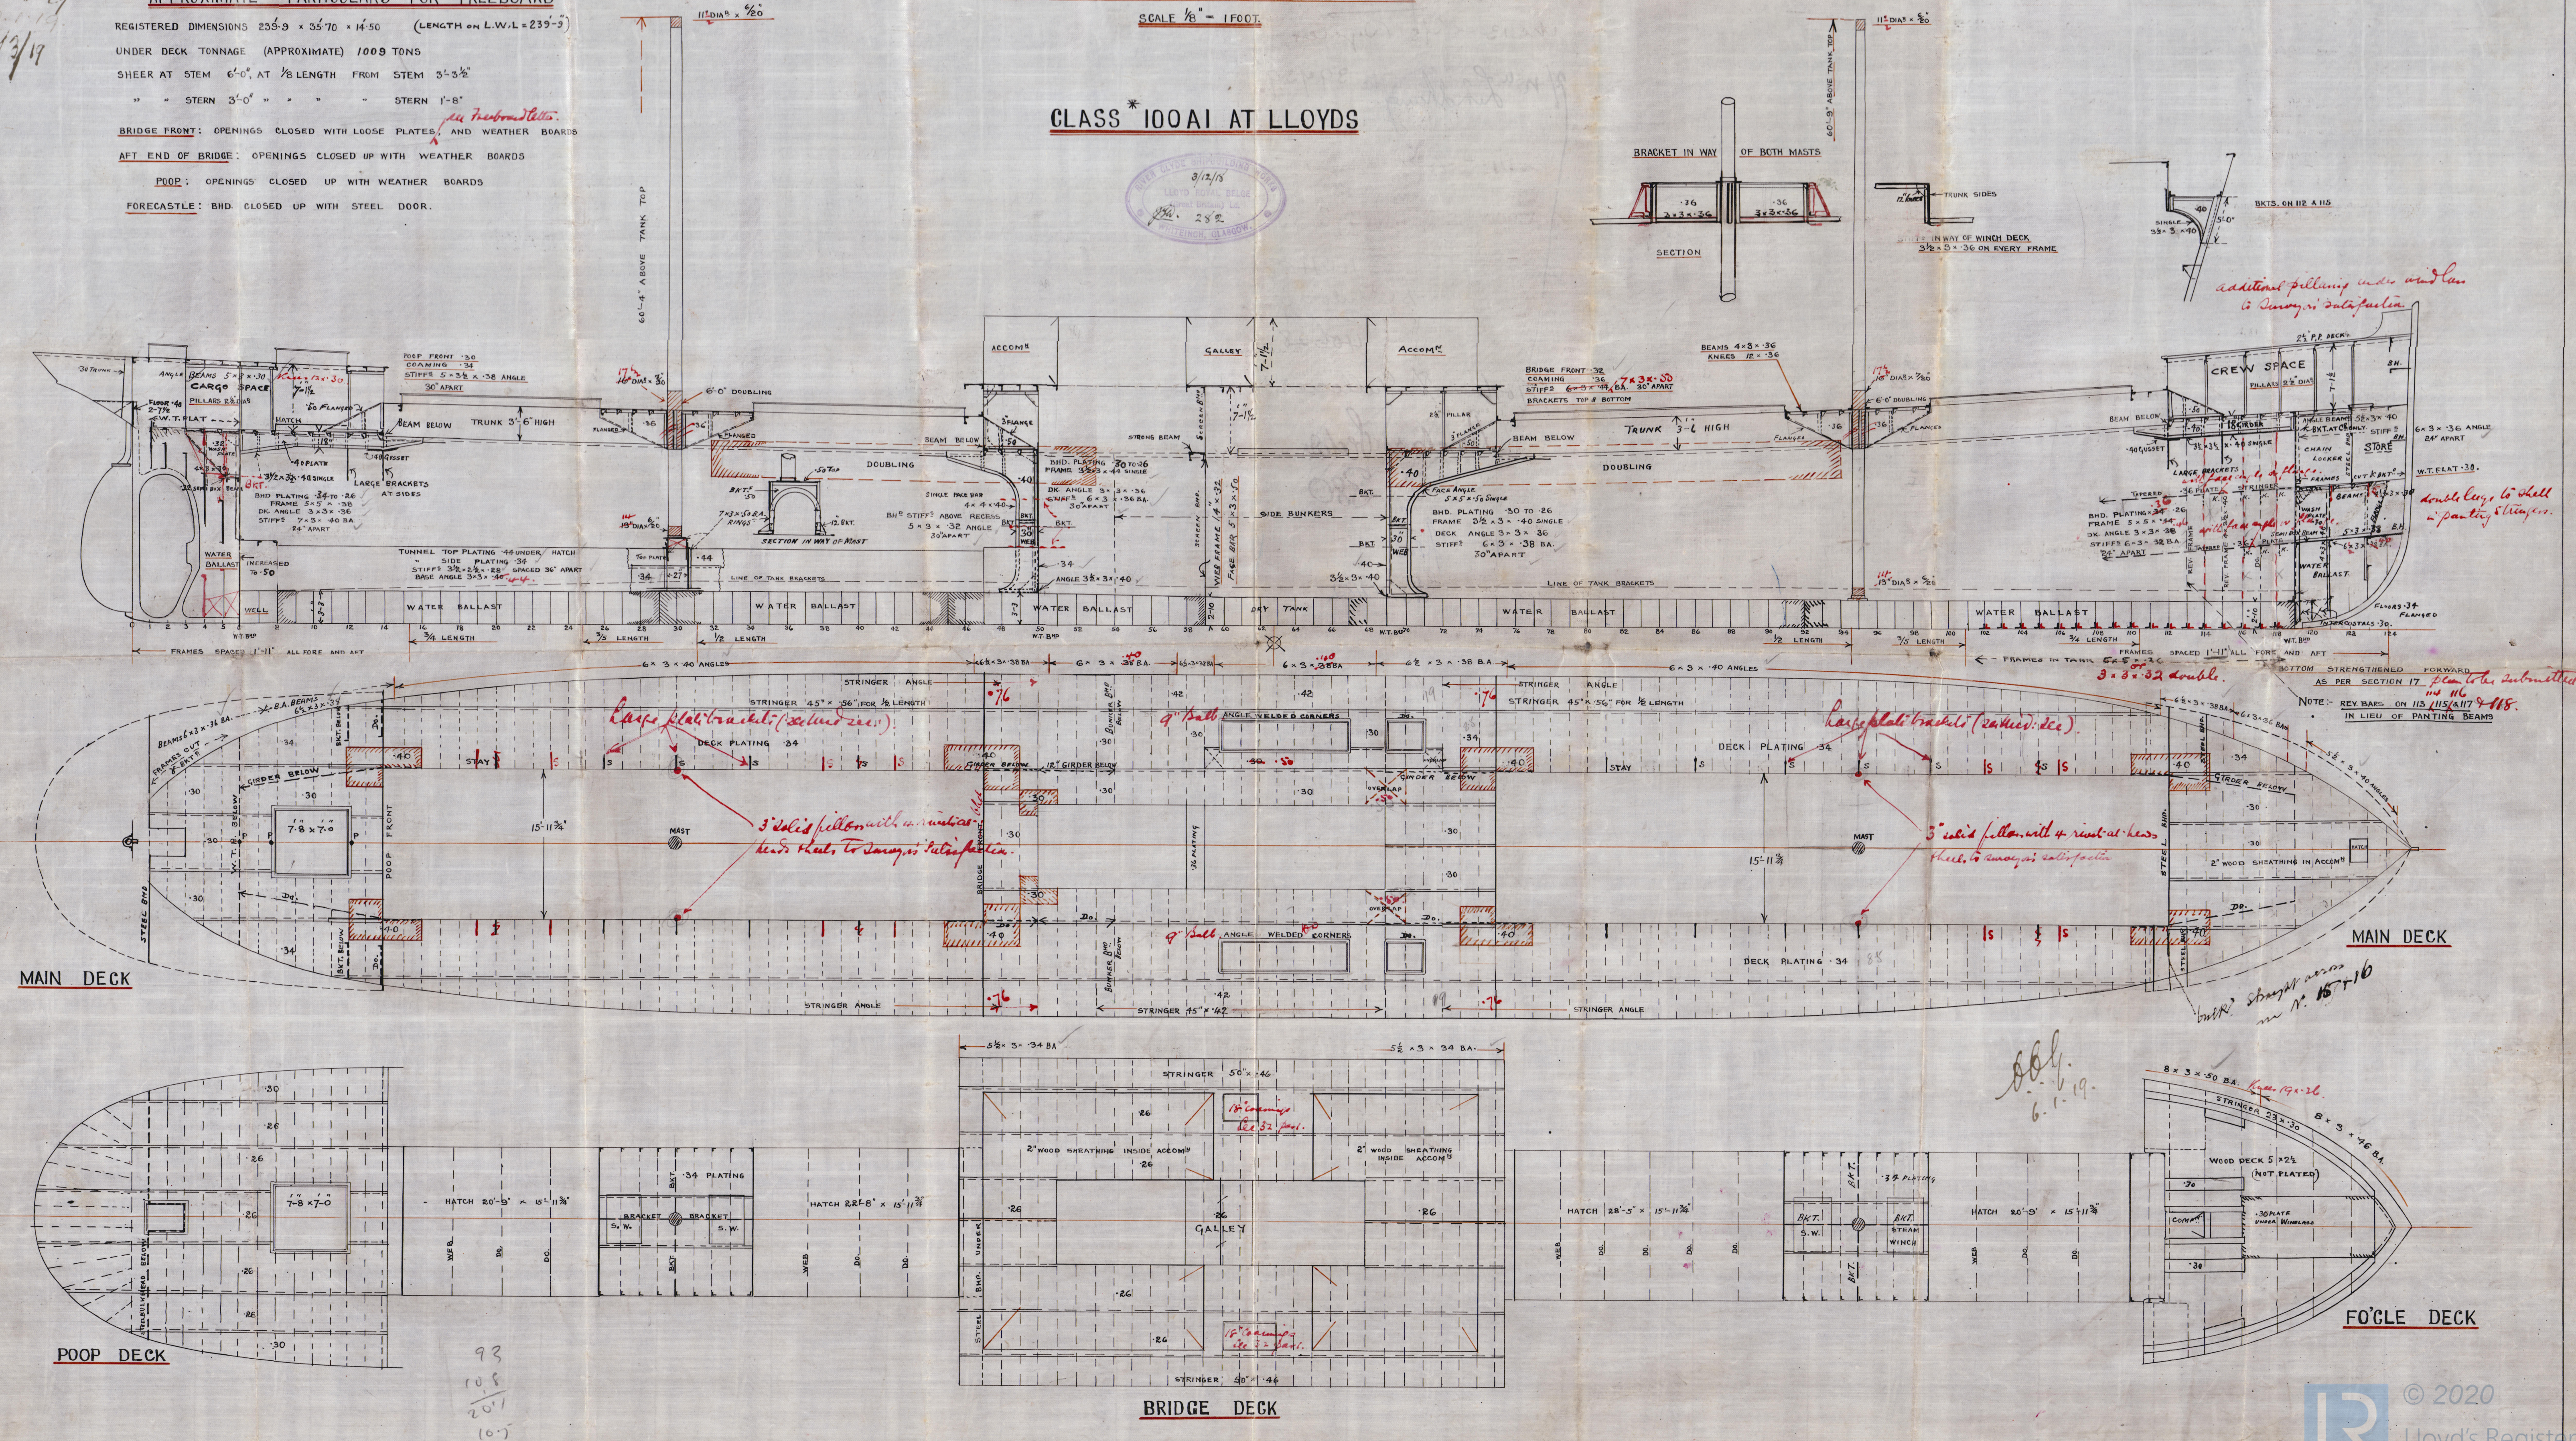

Mess. Lloyd Royal Belu

Nº 13 to 16

Profile and

Deck Plans

no. 13 - S/S. Dyrer.

nº Lindhang 39429.

no. 14 - - - - - Dalmatian

GLASGOW REPORT NO. 39335


1104482

S/S Citulovier
NN. KATJA DAN

40628

No 16 S/S Gallicier

Disclass Belu
380

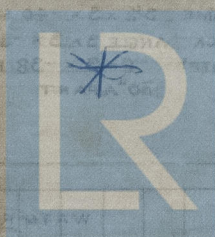

© 2020
Jan

Lloyd's Register
Foundation