


Scale:  $\frac{1}{8}'' = 1 \text{ Foot.}$

10<sup>th</sup> Feb/17

PLANS TRANSFERRED  
TO SISTER VESSEL

Profile.

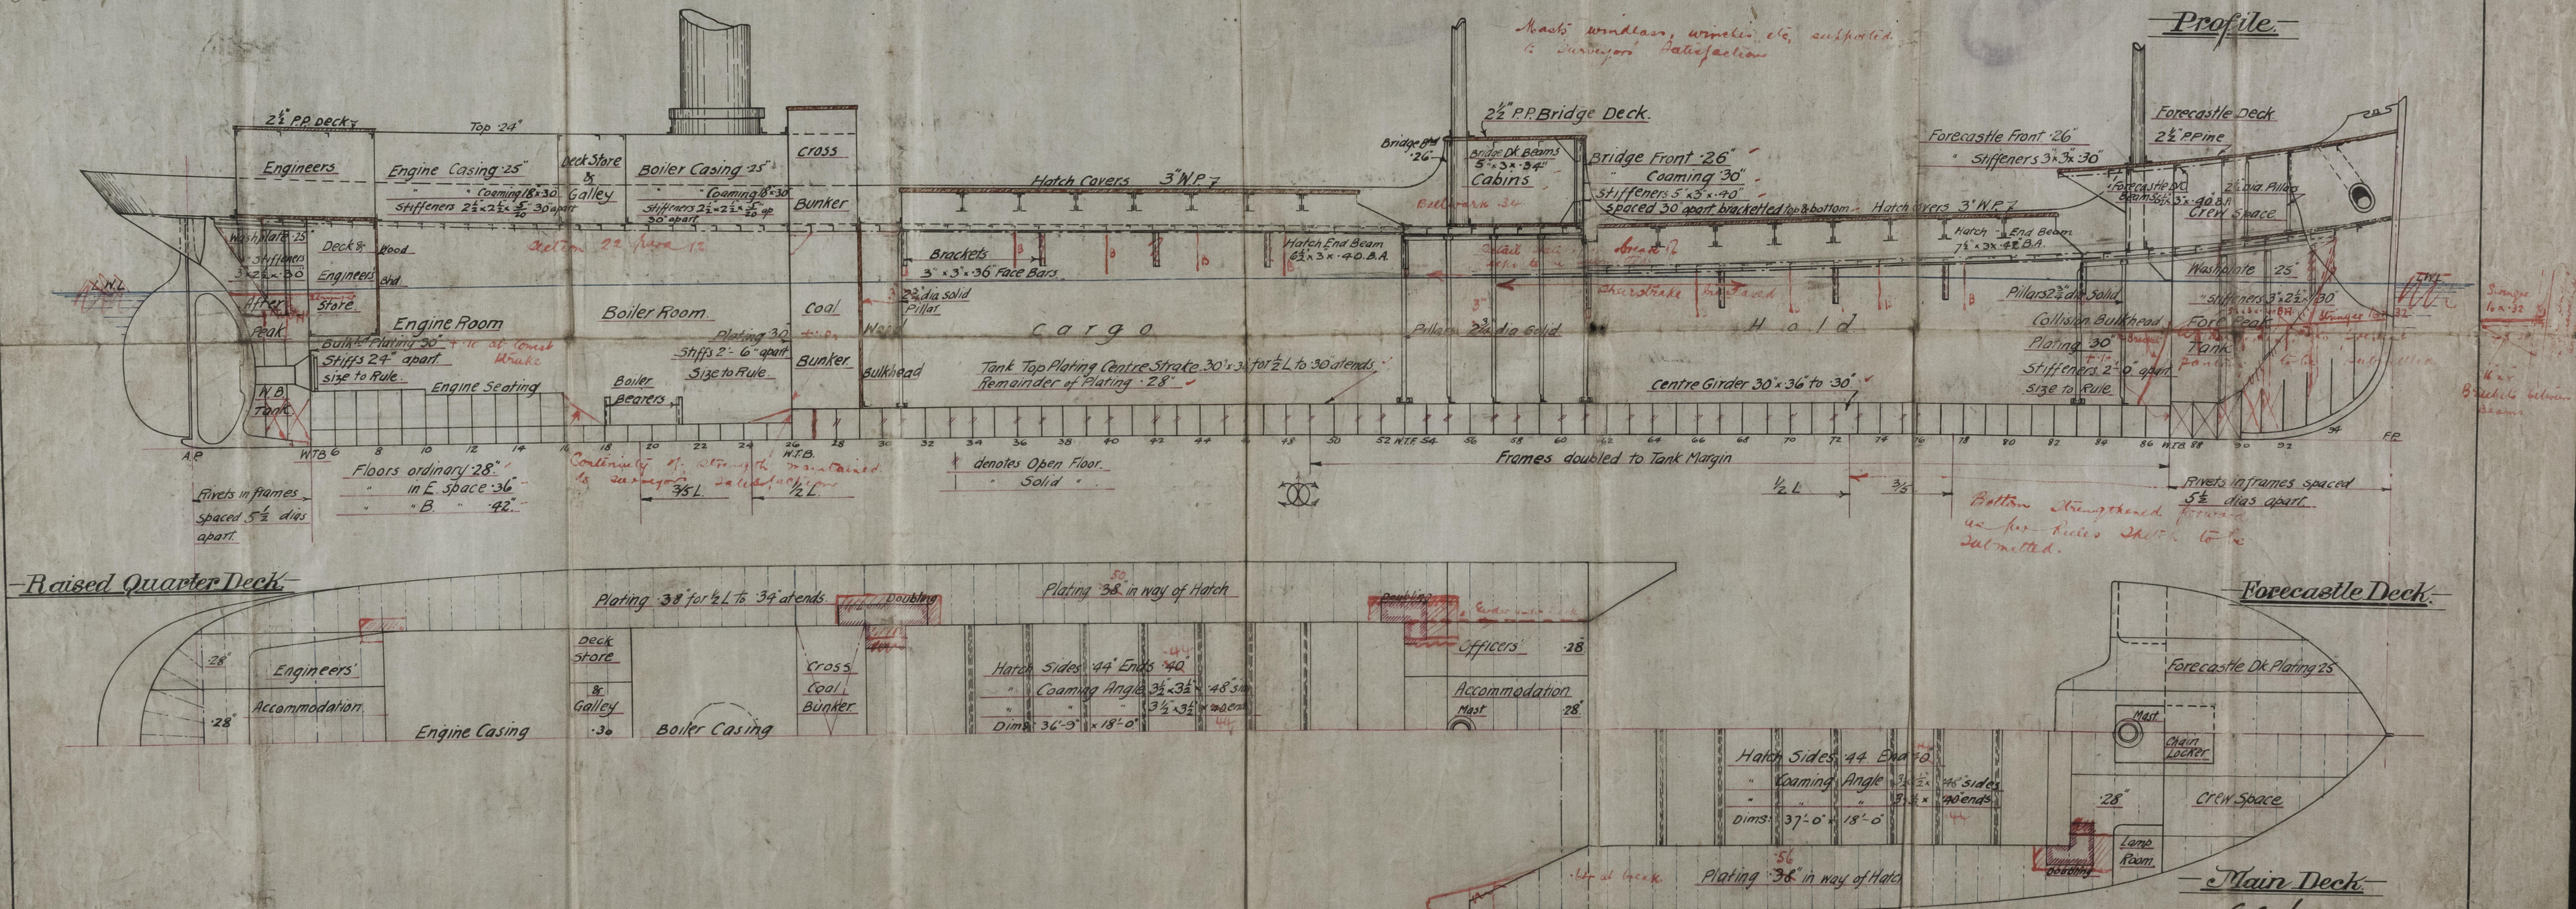

© 2009  
Lloyd's Foundation



*Southampton*  
*Messrs Dicks Ltd*

*No 109*

*PROFILE & DECK PLANS.*

*Son: Left No 10240*


*Mons*

PLANS TRANSFERRED  
TO SISTER VESSEL

*Sao Silverio*

*in 6 October*

*582*

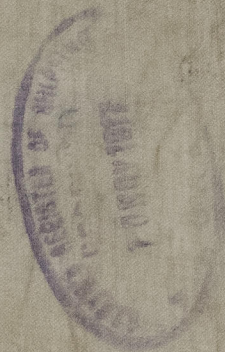

© 2020

Lloyd's Register  
Foundation

008409-00846-0082