



10 JUL 27.

PROPOSED CRUISER STERN TRAWLER

Approved *[Signature]*
See Letter 10.6.27

ARRANGEMENT OF MODIFIED DIAPHRAGM. No 0 FRAME.

SCALE: $\frac{1}{2}" = 1'-0"$

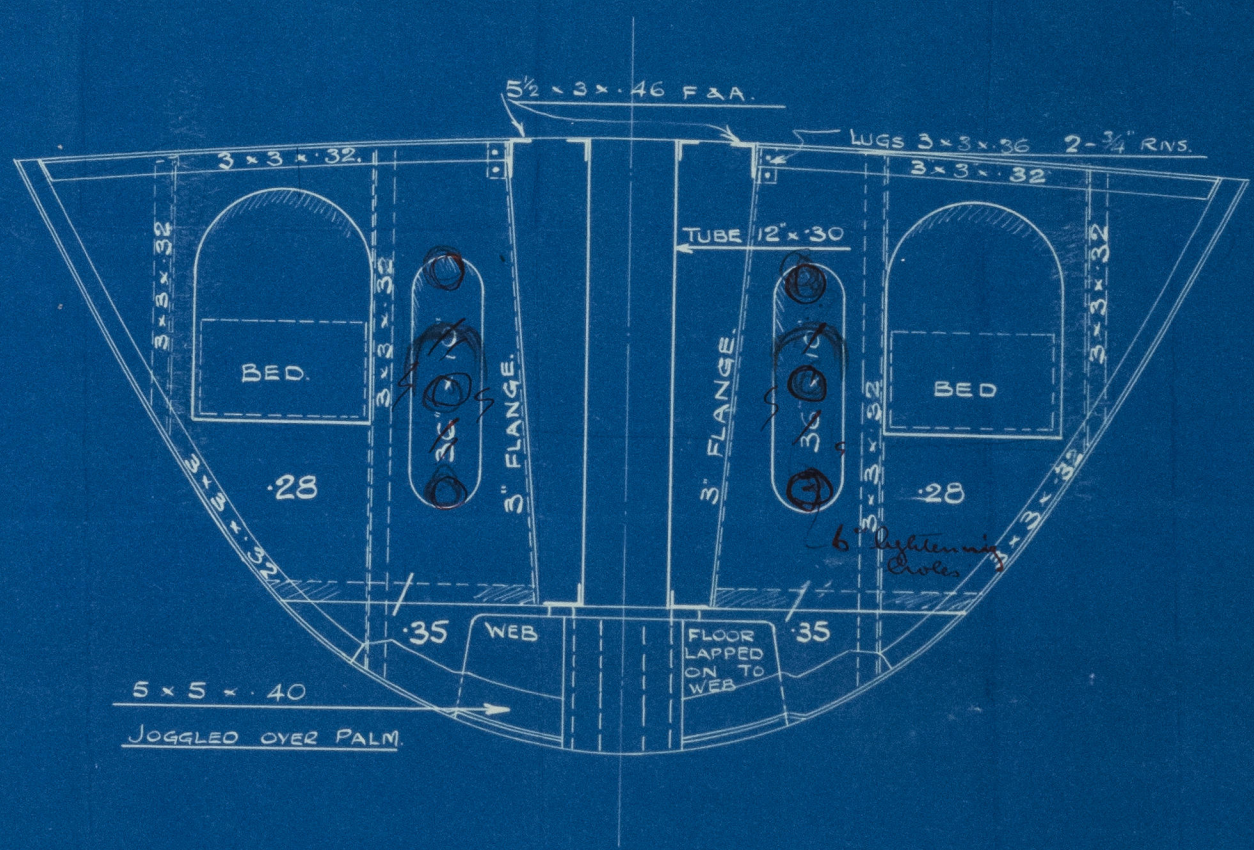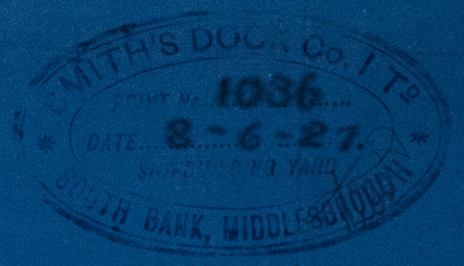

Lloyd's Register
Foundation

008417-008427-0026

3

Mod. to Cruiser Stern.

Smiths Dock Co.

83H.

10 " 6 " 27.

1/2 "Hatsuse"



© 2021

Lloyd's Register
Foundation

008417-008427-0026