


ARRANGEMENT OF CRUISER STERN & SPADE RUDDER.

SCALE 1/2" = 1 FOOT.

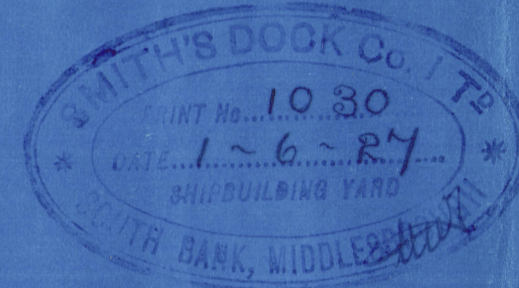


2 APR 1921
RECEIVED

Approved *[Signature]*
S. E. 27.

2

Spade Rudder & Cruiser Stern.

Smiths Ok. Co.

834

3. 6. 27.

s/s. "Hatsuse"