

TRANSVERSE SECTIONS FOR SELF-PROPELLED SINGLE SCREW STEAMER

TO CARRY FRESH WATER IN BULK

SCALE: 3/4" = 1 FOOT

DIMENSIONS

LENGTH O.A. 100'-9"

LENGTH B.P. 92'-0"

BREADTH MLD 23'-0"

DEPTH MLD 10'-4"

MEAN DRAFT 9'-3"

BOILER ROOM FLOORS 13 1/2 x 3

REVERSE BARS 2 1/2 x 2 1/2 x 3/8 SINGLE

DOUBLE UNDER BOILER CRADLES

SIDE KEELSON IN BOILER ROOM

6 x 3 x 3/8 O.A.

3/16 WASHPLATE WELDED TO SHELL (INTERMITTENT WELDS)

BULWARK KEEL

6 x 3/8 BULB PLATE WELDED TO SHELL

PLATING 3/16 x 4'-0"

INCREASED TO 1/8" FORWARD

PLATING 3/16 x 4'-0"

INCREASED TO 1/8" FORWARD

CONTINUOUS ANGLE 3 x 3 x 30

KEEL 40 x 3'-0"

FOR 3/8 L 30 AT ENDS

W. J. YARWOOD & SONS LTD

THE DOCK

NEORHICH

DATE: 25.4.42

SHIP N° 713


DRG. N° 5704

DESIGN BY: W. J. Y.

CHECKED BY: W. J. Y.

TRACED BY: W. J. Y.

INDEXED BY: W. J. Y.

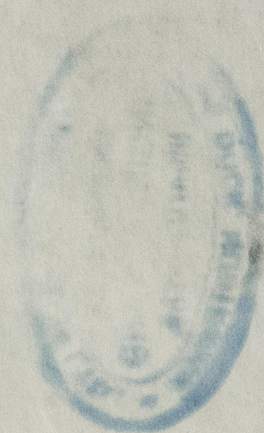

718

Section (approved)

S.S. Empire Beller

LIVERPOOL

Report No. 119669

①

