
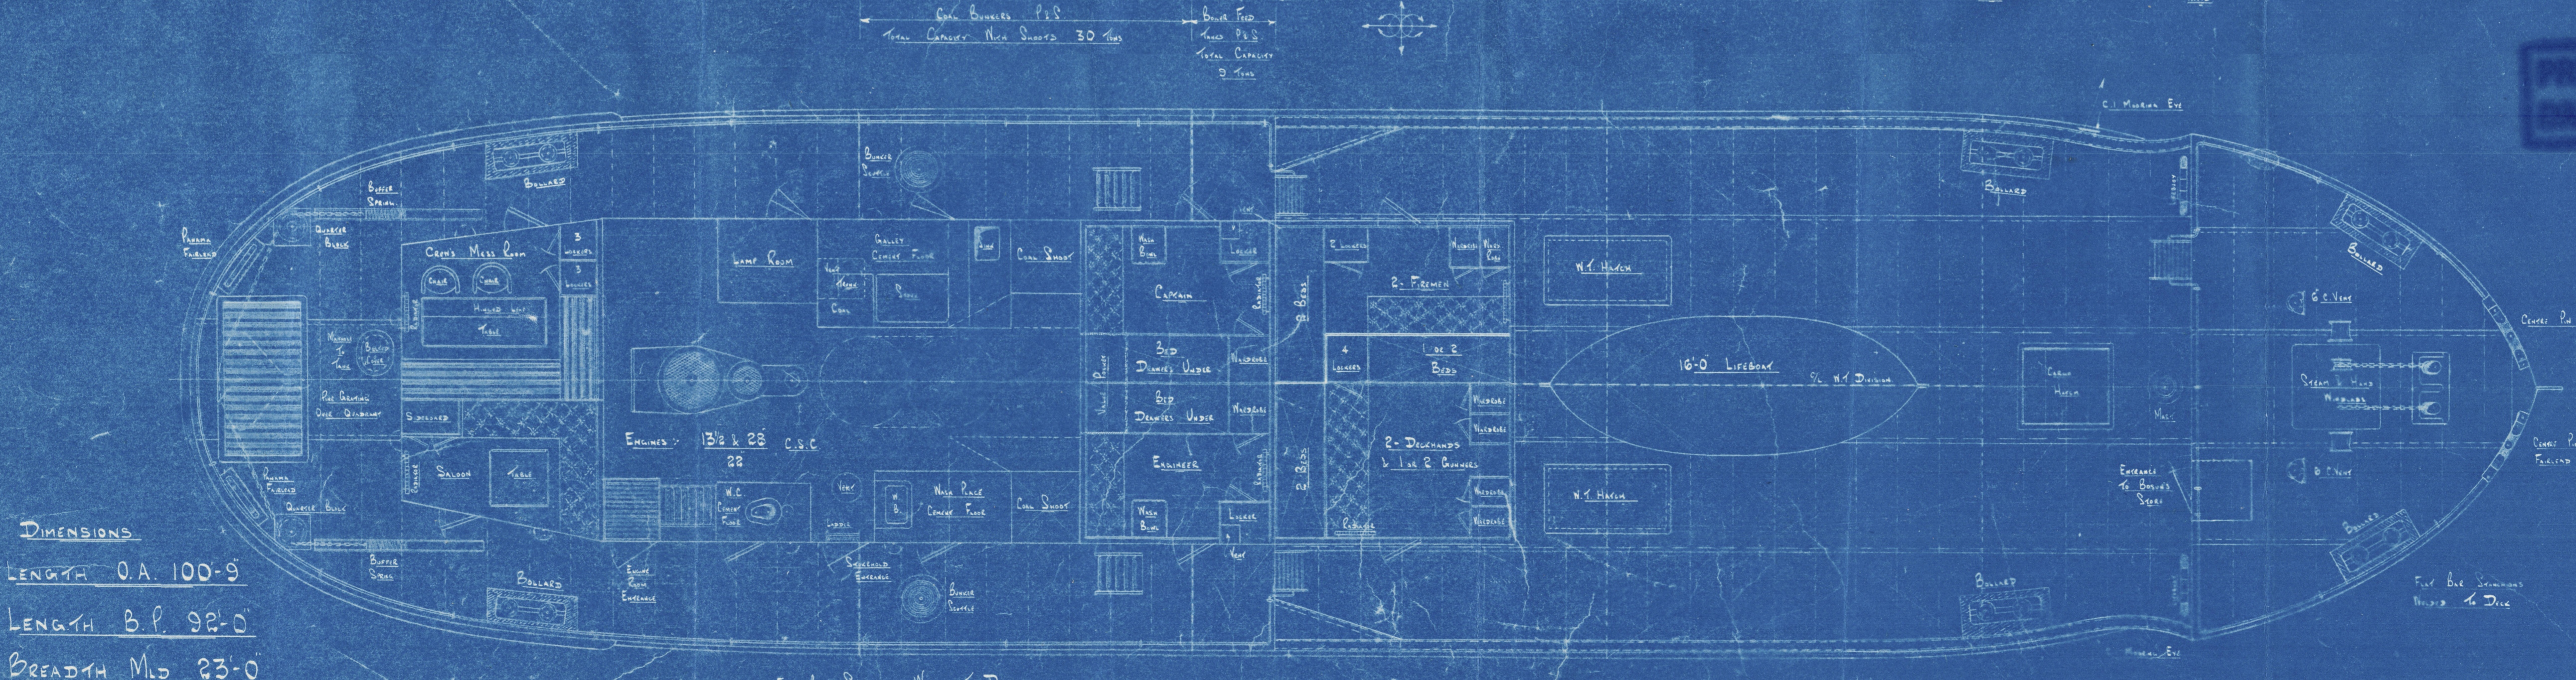


GENERAL ARRANGEMENT OF SELF-PROPELLED SINGLE SCREW STEAMER

TO CARRY 180 TONS OF FRESH WATER IN BULK
30 TONS BUNKERS & SHOOTS
9 TONS FEED WATER

SCALE: 1/4" = 1 FOOT

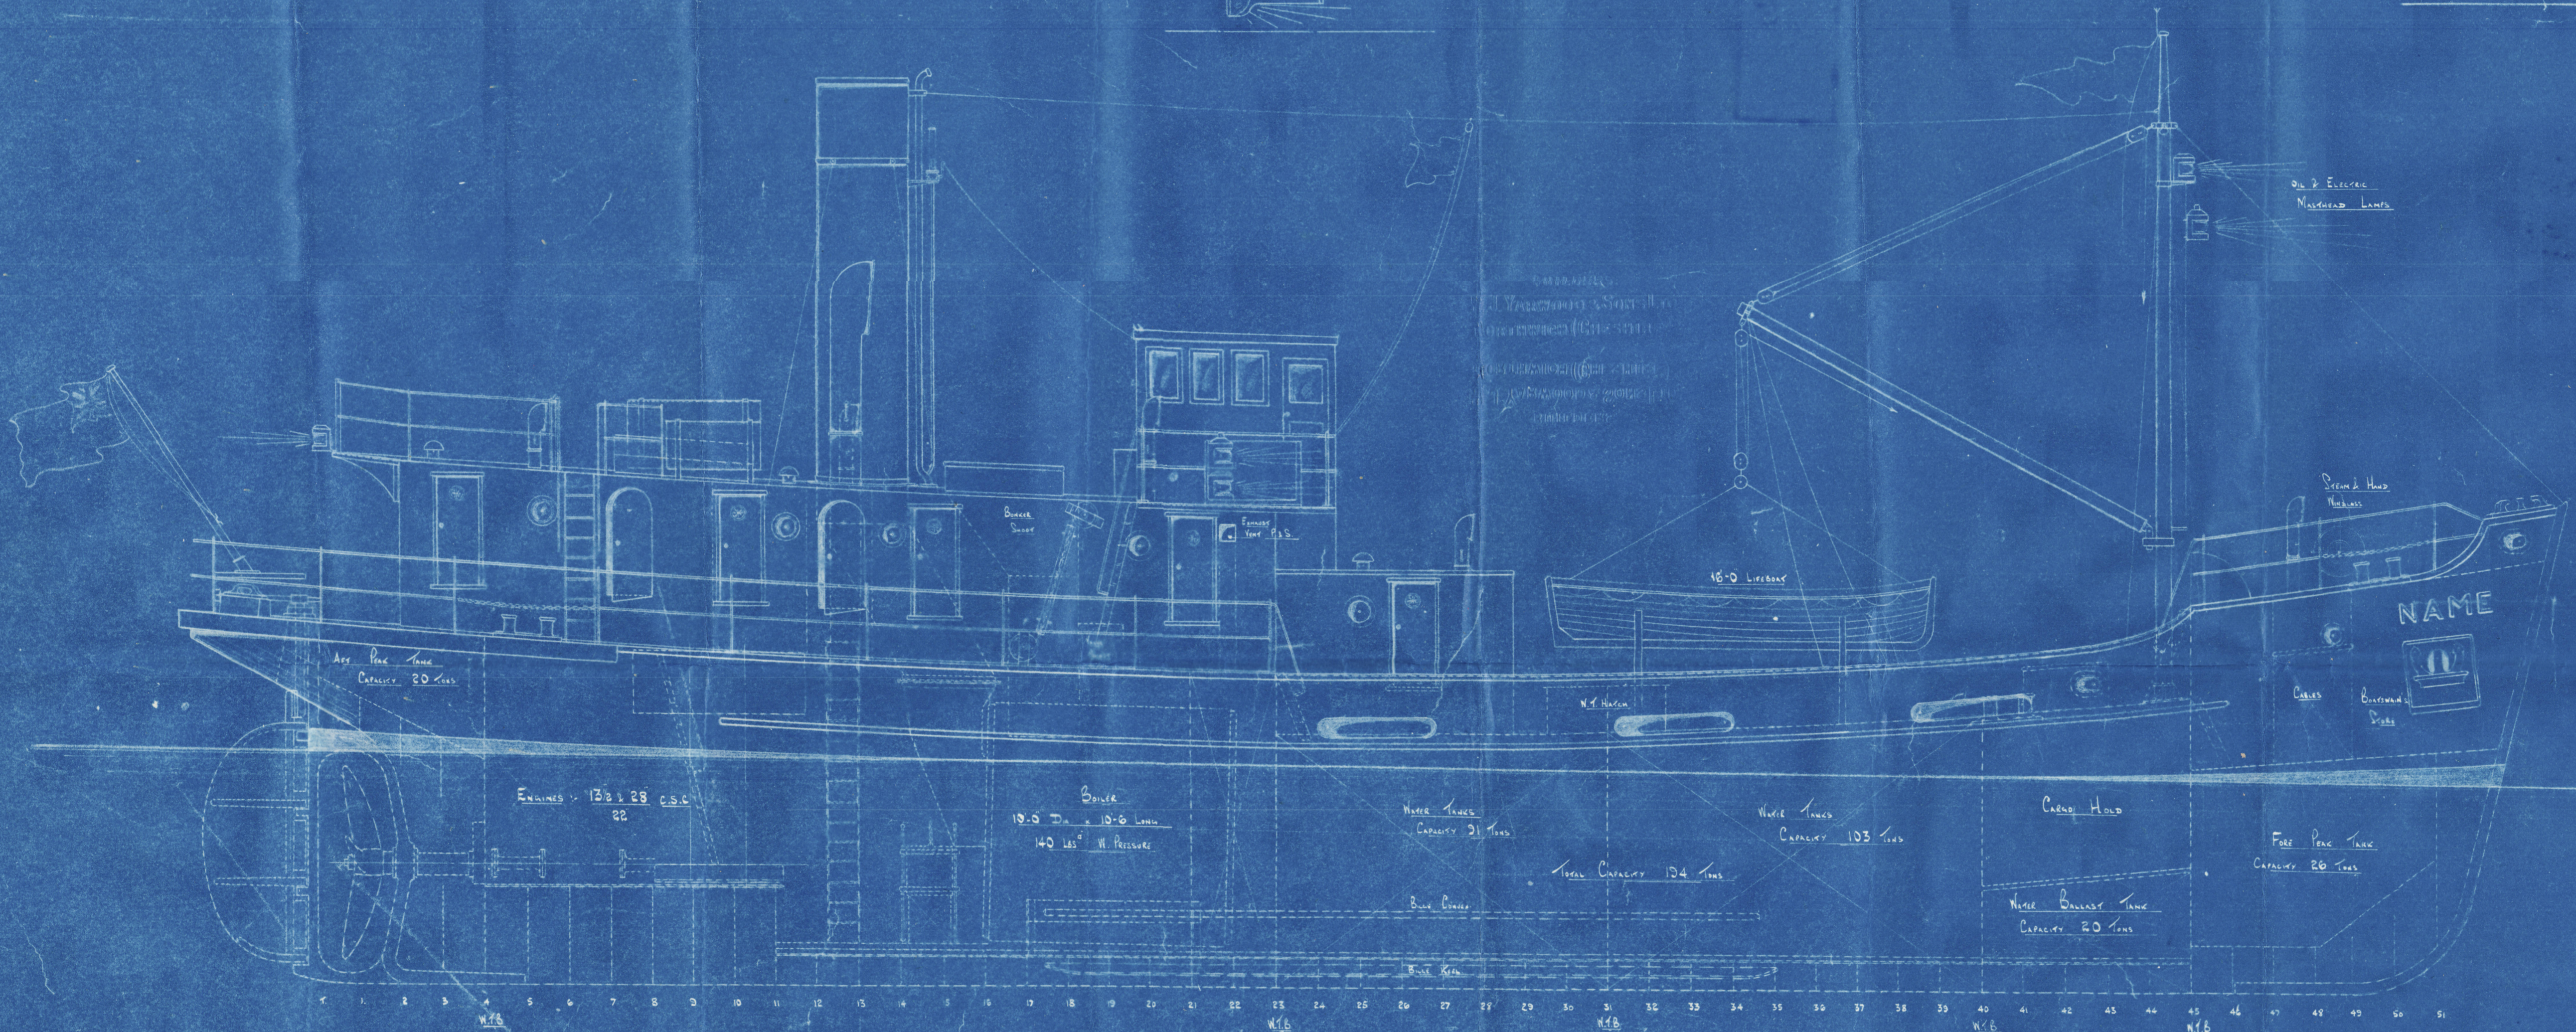

DIMENSIONS
LENGTH O.A. 100'-9"
LENGTH B.P. 92'-0"
BREADTH MLD 23'-0"
DEPTH MLD 10'-4"
MEAN DRAFT 9'-3"

PRINT NO. 6616
DATE 20-10-42

N. J. YARWOOD & SONS LTD
THE DOCK
DATE: 31-3-42
SHIP NO 718
DRG NO 5701
DRAWN BY N.J.Y. CHECKED BY N.J.Y.
TRACED BY N.J.Y. INDEXED BY N.J.Y.

3/11/62

718

Amended Gen. Arrangement

S.S. Empire Billow

LIVERPOOL

Report No. 119669

(3)

PRINT No.
DATE

BUILDERS.
J. YARWOOD & SONS LTD
NORTHWICH (CHESHIRE)
J. YARWOOD & SONS LTD
NORTHWICH (CHESHIRE)
J. YARWOOD & SONS LTD
NORTHWICH (CHESHIRE)

0004



© 2020

Lloyd's Register
Foundation

008428-008433-0004