

LLOYDS DIMENSIONS 392' x 51' x 30'-2"

INBOARD PROFILE.
REVISED SUBDIVISION.

SCALE $\frac{1}{16}$ " = 1 FOOT. MADE BY *WEL* DATE 25 O. 11
NEW YORK SHIPBUILDING COMPANY.
CAMDEN, NEW JERSEY, U.S.A.


DR-125-202-C

E. H. Rigg. NAVAL ARCHITECT.

1 LITB
2 FEGG
3 LXSRLM
4 RYONG
5 PIERCE
6 LOYKIN
7-8 JYONG
25011
9 H.O.G
10 BLAKE
11 KENNEDY
12 FEGG
26011
13-14 J 2
49fa12
15-17 LLOYD
18-22 LLOYD
21-25

15-17 LLOYD
15-22 LLOYD
21-5-1+

Propit
New York & Star
N-172
"DESCUBRIDOR"
EX
s. full maid
Pha Rpn N° 2533 (70d)

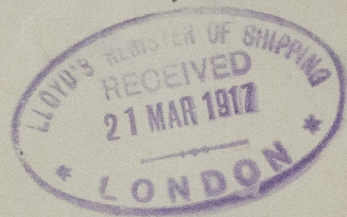

172 Propit

008428-008433-0026

NEW YORK SHIPBUILDING CO.
CAMDEN, N. J., U. S. A.
BLUE PRINT ROOM
Print No. 24
Made AUG 26 1915
For Dep't 13

172 Isaac Propit



© 2020

Lloyd's Register
Foundation