


## 1

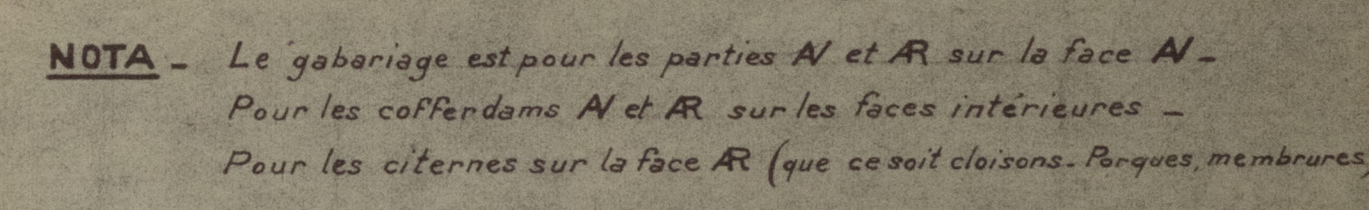


3

## Structure générale

70307 L500 © 2021 D<sup>2</sup> Lloyd's Register Foundation



Chantier de Penhoët N° K15

 "ISANDA"

PROFILE & DECKS (AS BUILT)

Nantes Jld. Rpt. N° 461

" F.E. RPT. 480

RECORDS DEPT.  
LONDON

(L)



© 2021

Lloyd's Register  
Foundation

008434, 008438 - 0002