

PLAN No. 5477
 FOR ENCLOSURE TO
 Messrs LLOYD'S
 HULL FROM
 COCHRANE & SONS, LTD.
 SHIPBUILDERS, SELBY.
 DATE 8/4/15

MIDSHIP SECTION NOS 64718.


STEEL SCREW TRAWLERS

DIMENSIONS: 138'4" x 23'9" L x 13'6" Moulded.

SCALE 1/2" = 100'

DECK PLATED OVER IN WAY OF MACHINERY SPACE.
 ENGINE & BOILER CASING AS PREVIOUSLY APPROVED.

12.4.15

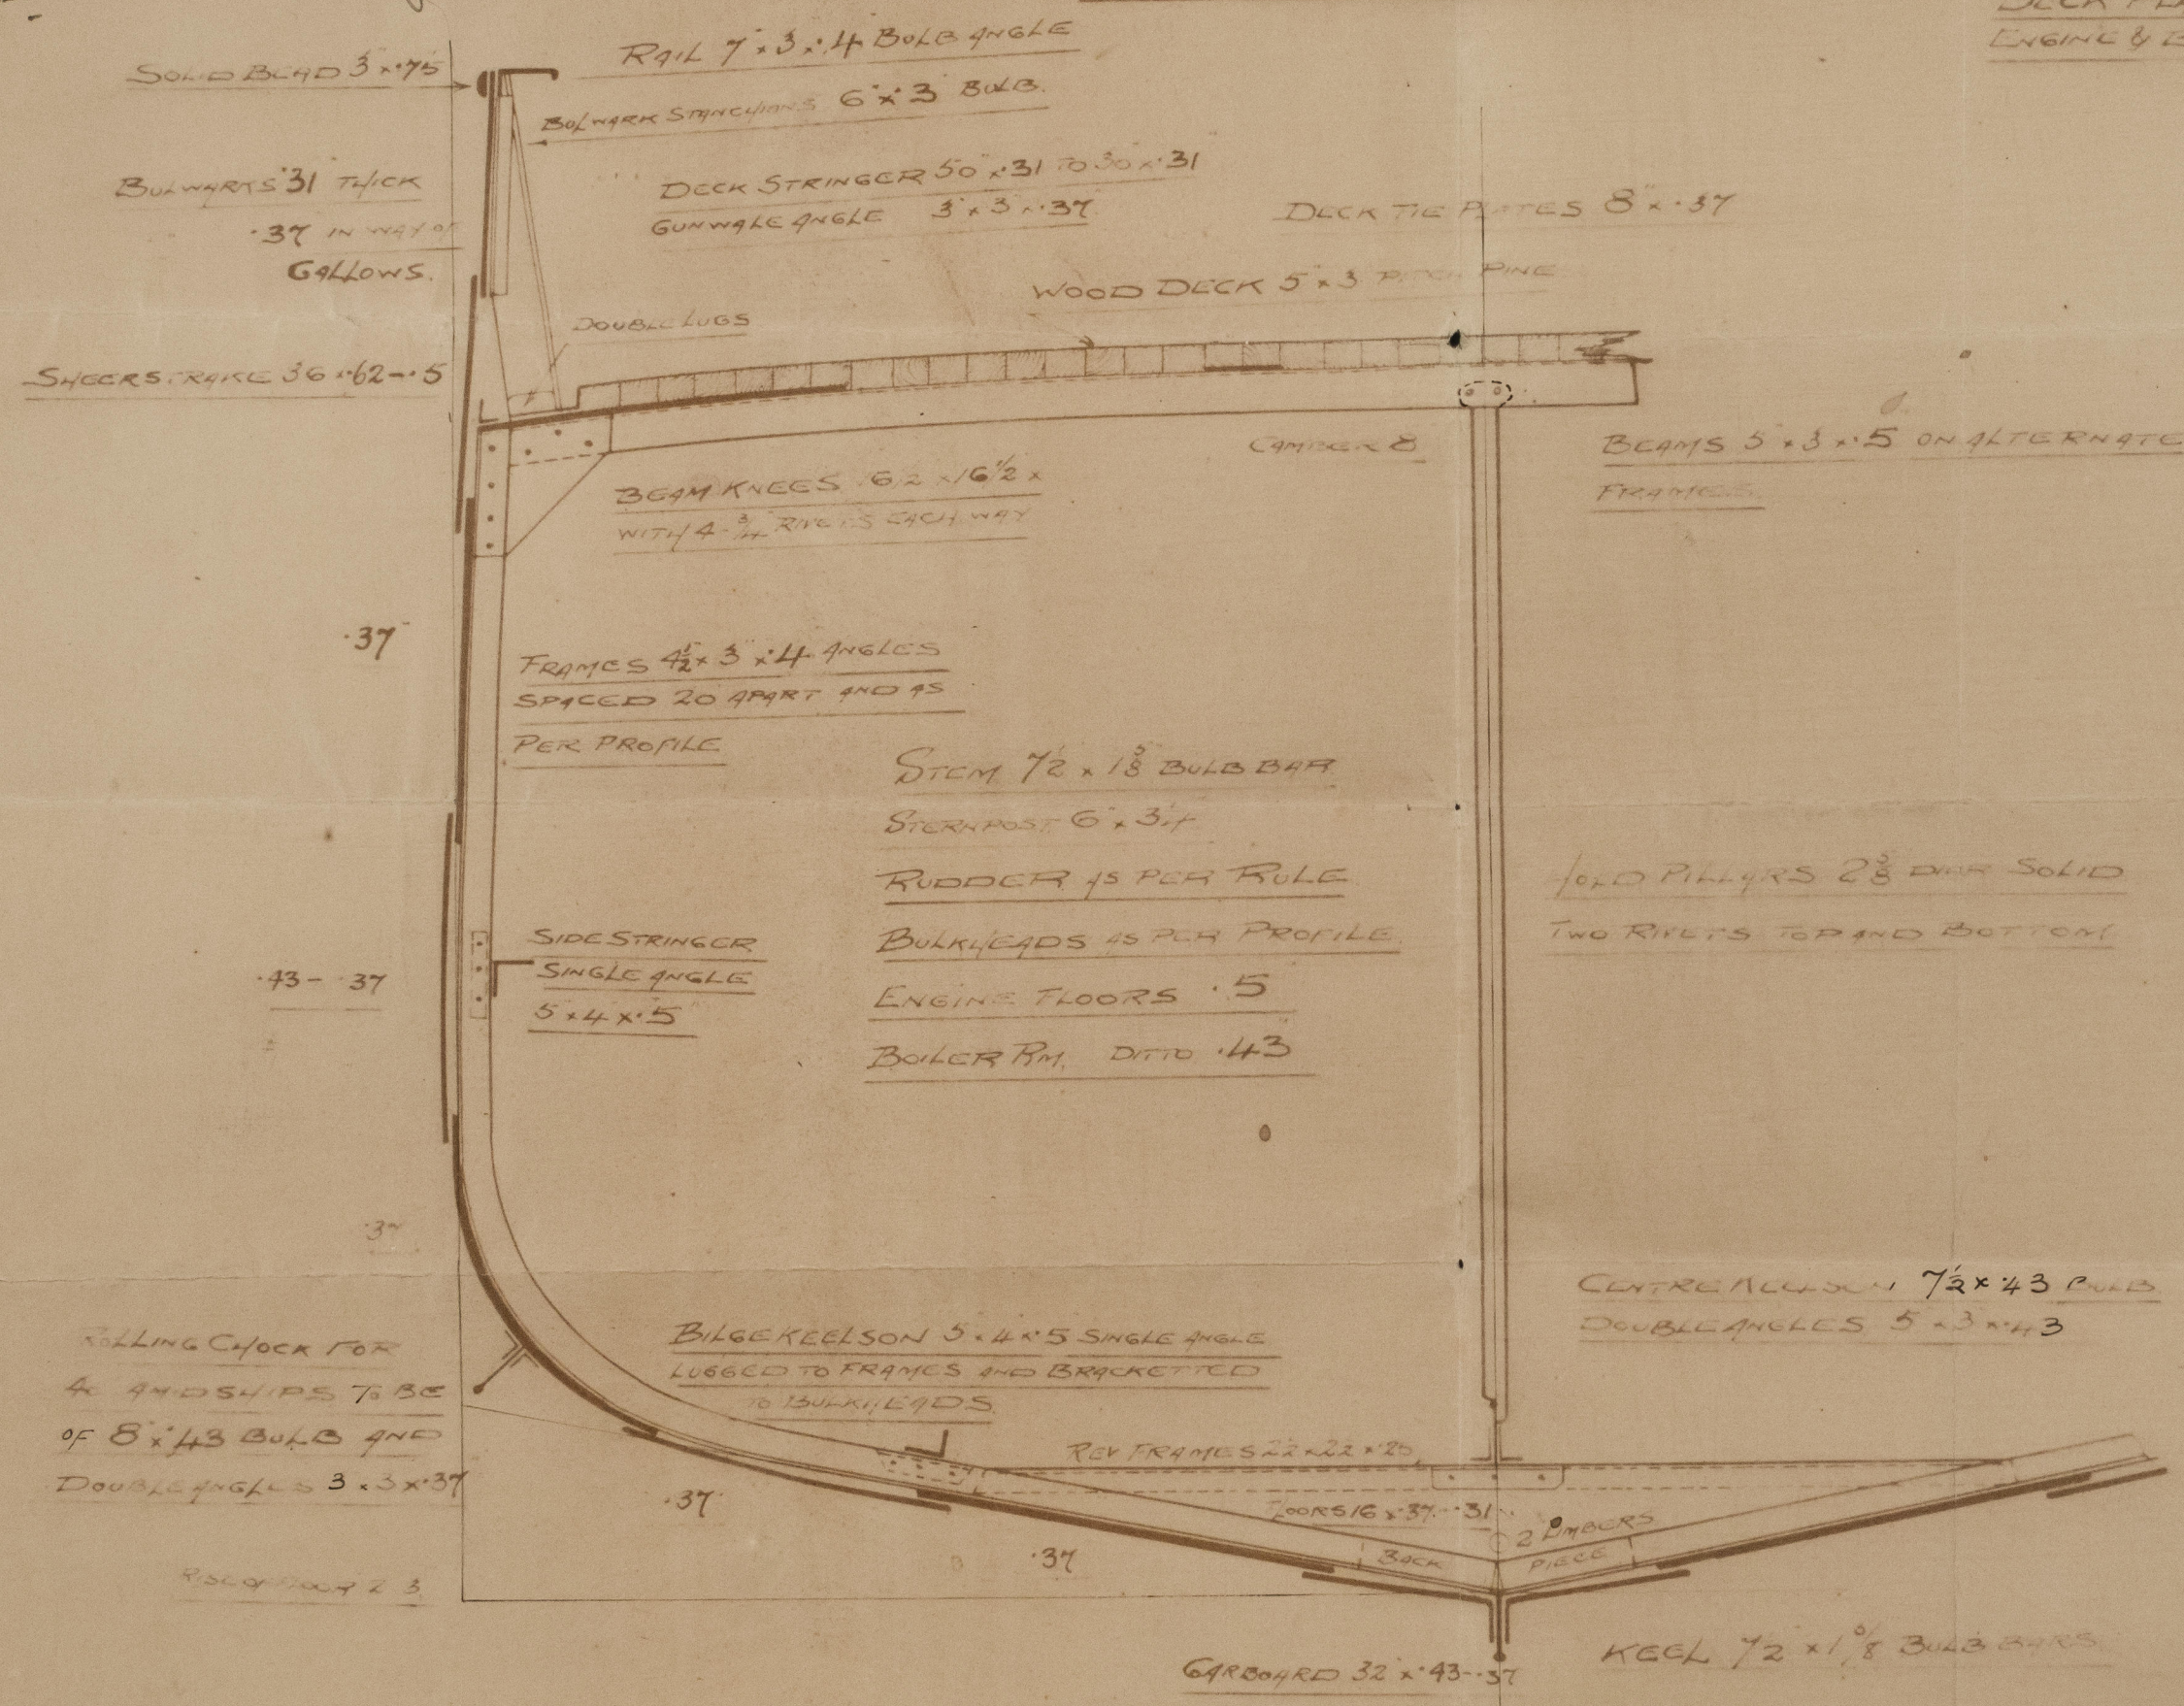

NUMERICALS

B + D 37.12.1
 L (B + D) 534.80

PROPORTIONS

L 5.85
 B 10.24
 D 12.12.83

EQUIPMENT

ONE 7 INCH SCOTTS STEELLESS
 AND 7/8
 WEDGE 3 1/2 L x 5 INCH
 120 FT THOMSON 1 1/2" STEEL WIRE CABLE
 60 6 HAWSEY
 60 5 WARP

PLATING

3075.0 SHEET PLATING APPLIED
 AND DOUBLE RIVETED EXCEPT GARBOARD
 AND SHILLERS LIKE WHICH ARE STRIPPED
 AND DOUBLE RIVETED
 LANDINGS DOUBLE RIVETED
 BULKHEADS SINGLE RIVETED


CCP
 10.4.15

27.12
 13.10
 2.10.2
 17.6
 12.2
 13.6
 12.10
 13.6
 14.3
 12.10


COCHRANE ~~YD~~ 70

MIDSHIP SECTION.

N^o 647848

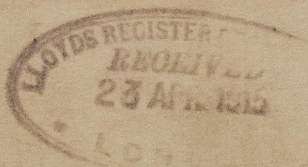

S.S. Ford Mersey Hull Rtno 29155
D. Ind Leading Hull Rtno 29268
N/N Begur

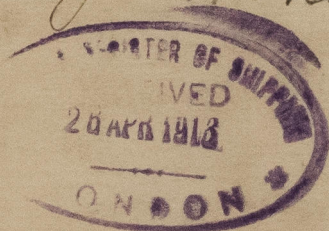

Transferred to
Begur Sir Lee
205



© 2020

Lloyd's Register
Foundation

008439-008445-0076