

178.23
69165

12.4.15.
18.4.16.

PROFILE AND PLAN



S.S. Nos 641 '8.

STEEL SKEL. TRAILERS

DIMENSIONS, 138' 4" x 23' 0" x 13' 6" MOULDED.


SCALE ARCH ONE FOOT

PLAN No. 5476
FOR ENCLOSURE TO
Messrs. LLOYD'S
FROM
COCHRANE & SONS, LTD.
SHIPBUILDERS, SEASIDE
DATE 8/4/15

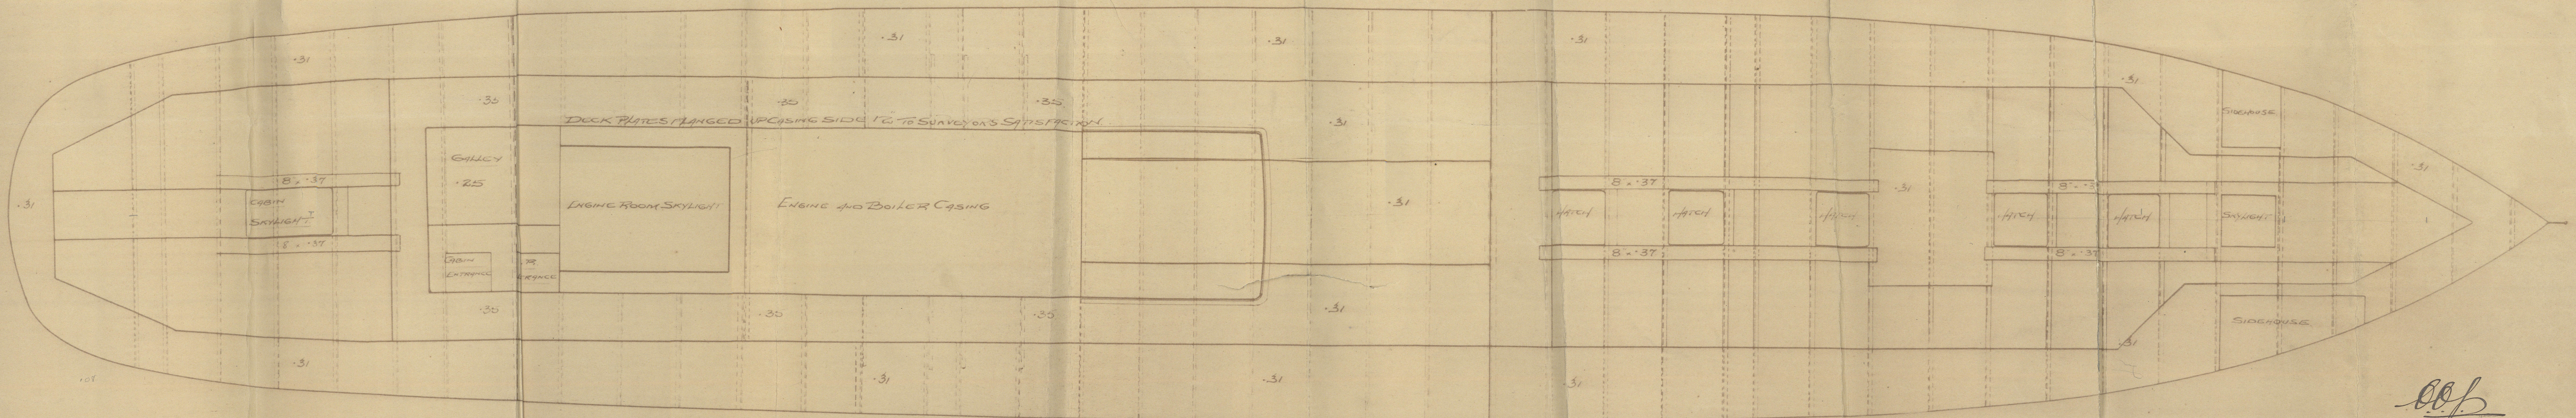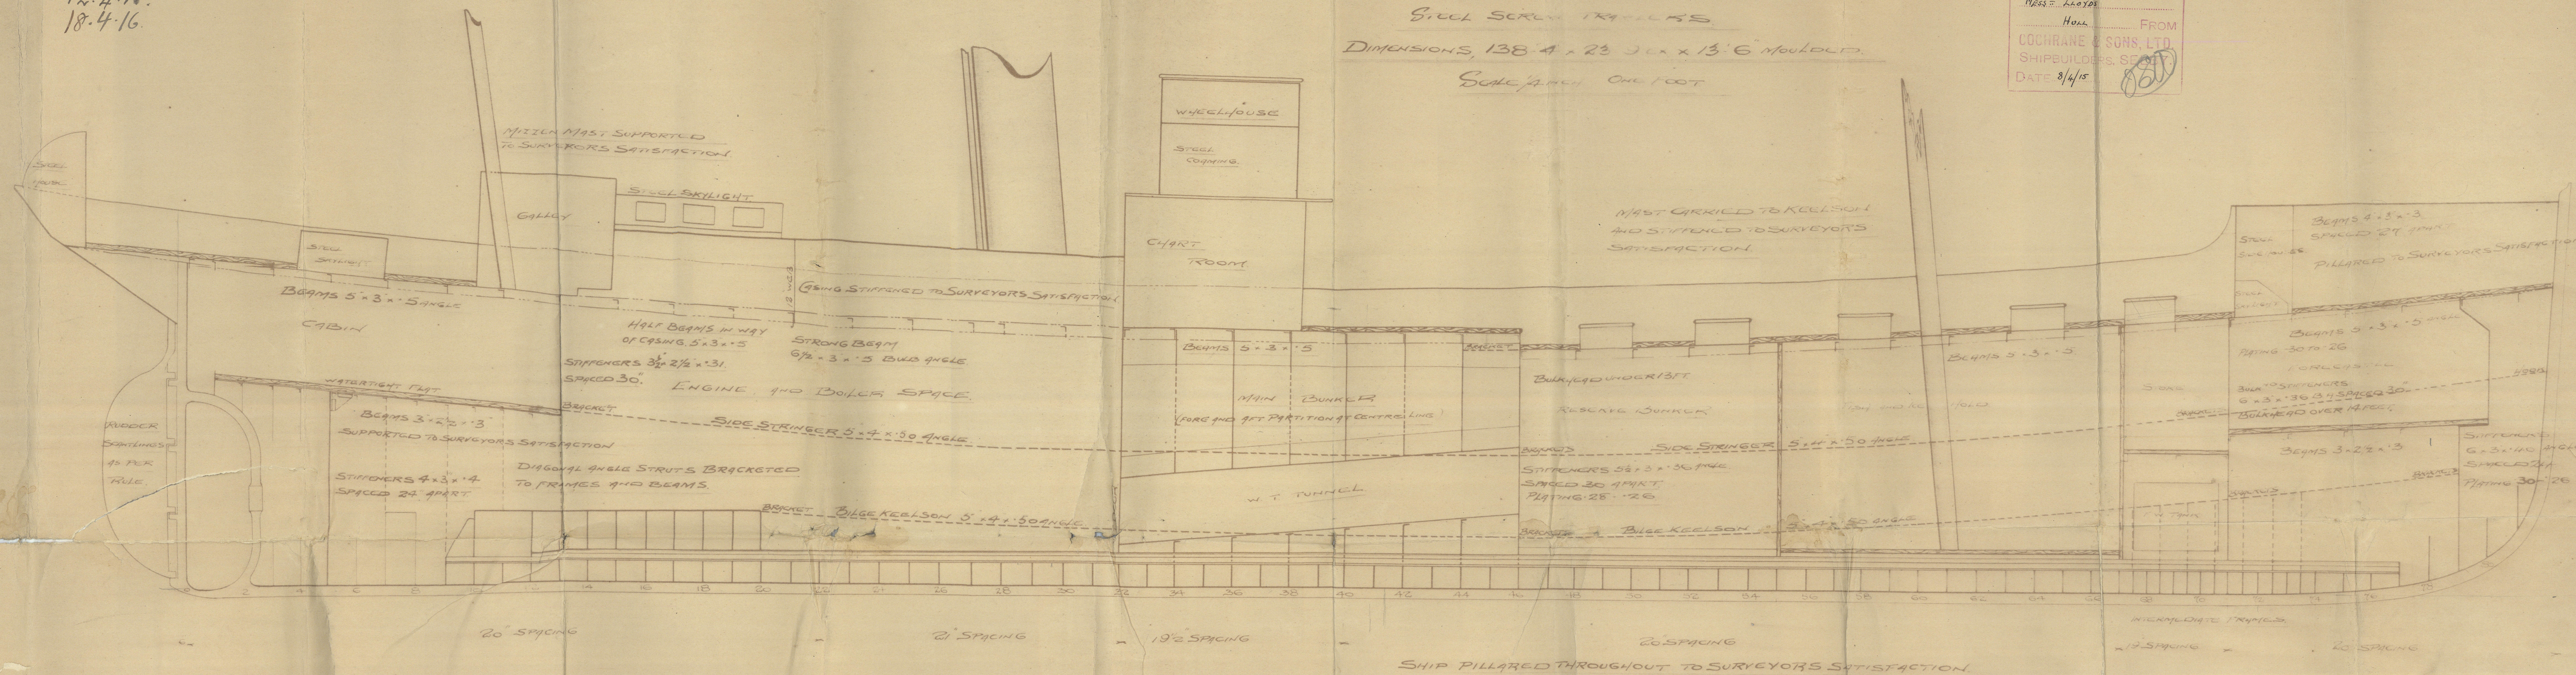


cop.
10.4.15

COCHRANE & SONS LTD
PROFILE & DECK PLAN
Nos 647 & 48.

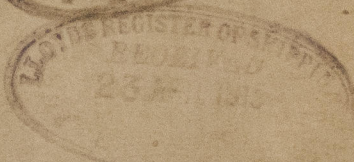

S.S. Lord Mowey Hull Rpn No 29155
S.S. Lord Reading Hull Rpn No 29268

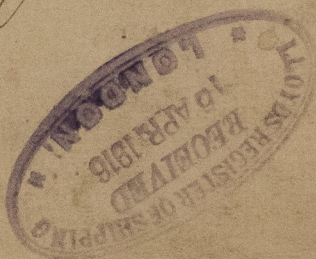

© 2020

Lloyd's Register
Foundation

008439-008445-0077