

## 製造數 卷 何

S NO 5  
IINO KAIUN KAISHA LTD  
5500 TON CARGO SHIP

STERN FRAME

完成圖

SCALE	$\frac{1}{25}$
WORK ORDER	85-5

MATZURU DOCKYARD
IINO SANGYO KAISHA LTD.
JAPAN
SHIP DESIGNING SECTION
CHIEF J. I. Kuroki
CHECKED Ando
DESIGNED
DRAWN
LATE APR. 10, 1953
DWG. NO. MAISEN 953

送先	教
控	1
修	
鉢	5
鏢	1
機	
電	
機	1
機設	1
船	2
船	
本好	7
船	
CLOUD	4
MAX	4
計	26
(2)	




TO LLOYDS REGISTER  
OF SHIPPING

AS BUILT

*Sternframe*

CERTIFIED COPY OF "APPROVED PLAN"

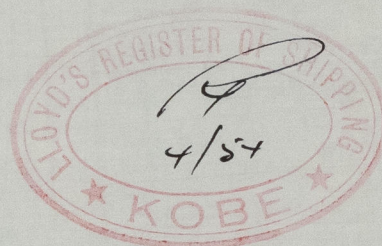


★ NAGASHIMA MARU

KOBE RPT. NO. 2076


DATED. \_\_\_\_\_

RECORDS DEPT.,  
LONDON.

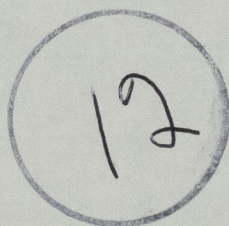

第  
設  
計  
課  
長

造  
船  
部  
長

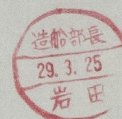

Lloyd's Register  
Foundation

008439-008445-0096