



8-MAR-1979

AFTER MAST.
RAKE $1\frac{3}{4}$ " PER FOOT.

FORE MAST.
RAKE $1\frac{1}{2}$ " PER FOOT.

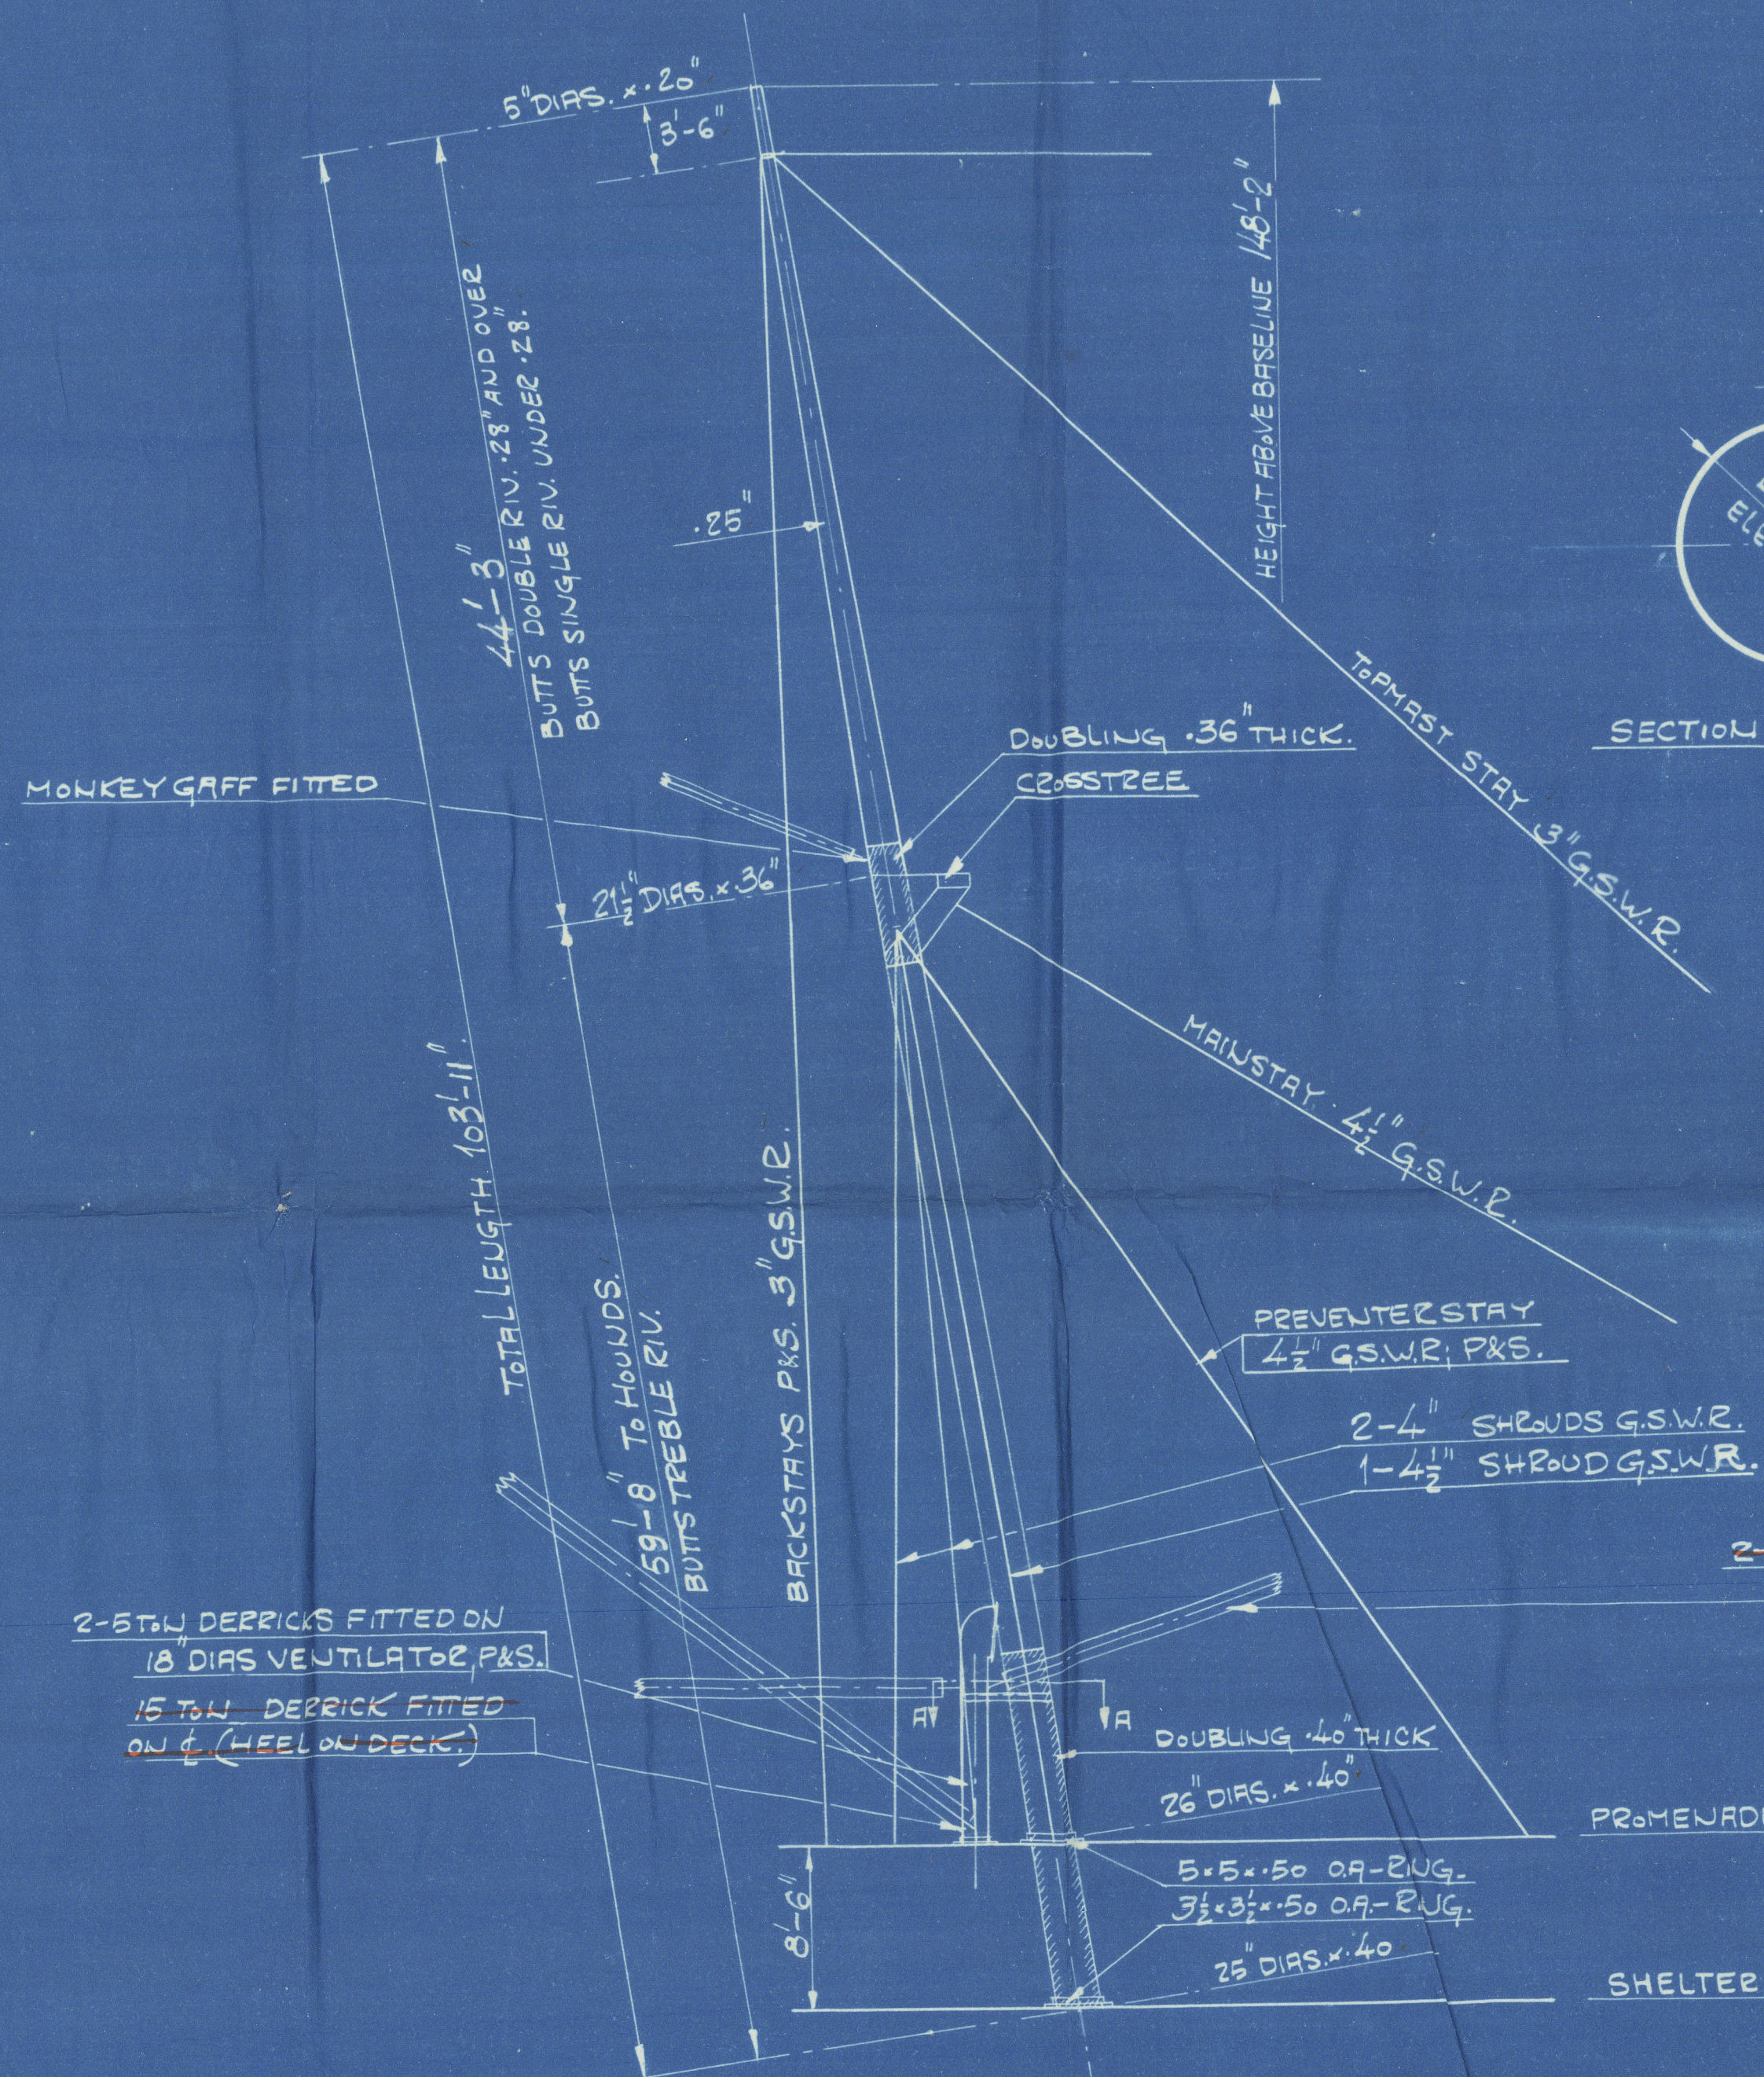


X See letter.

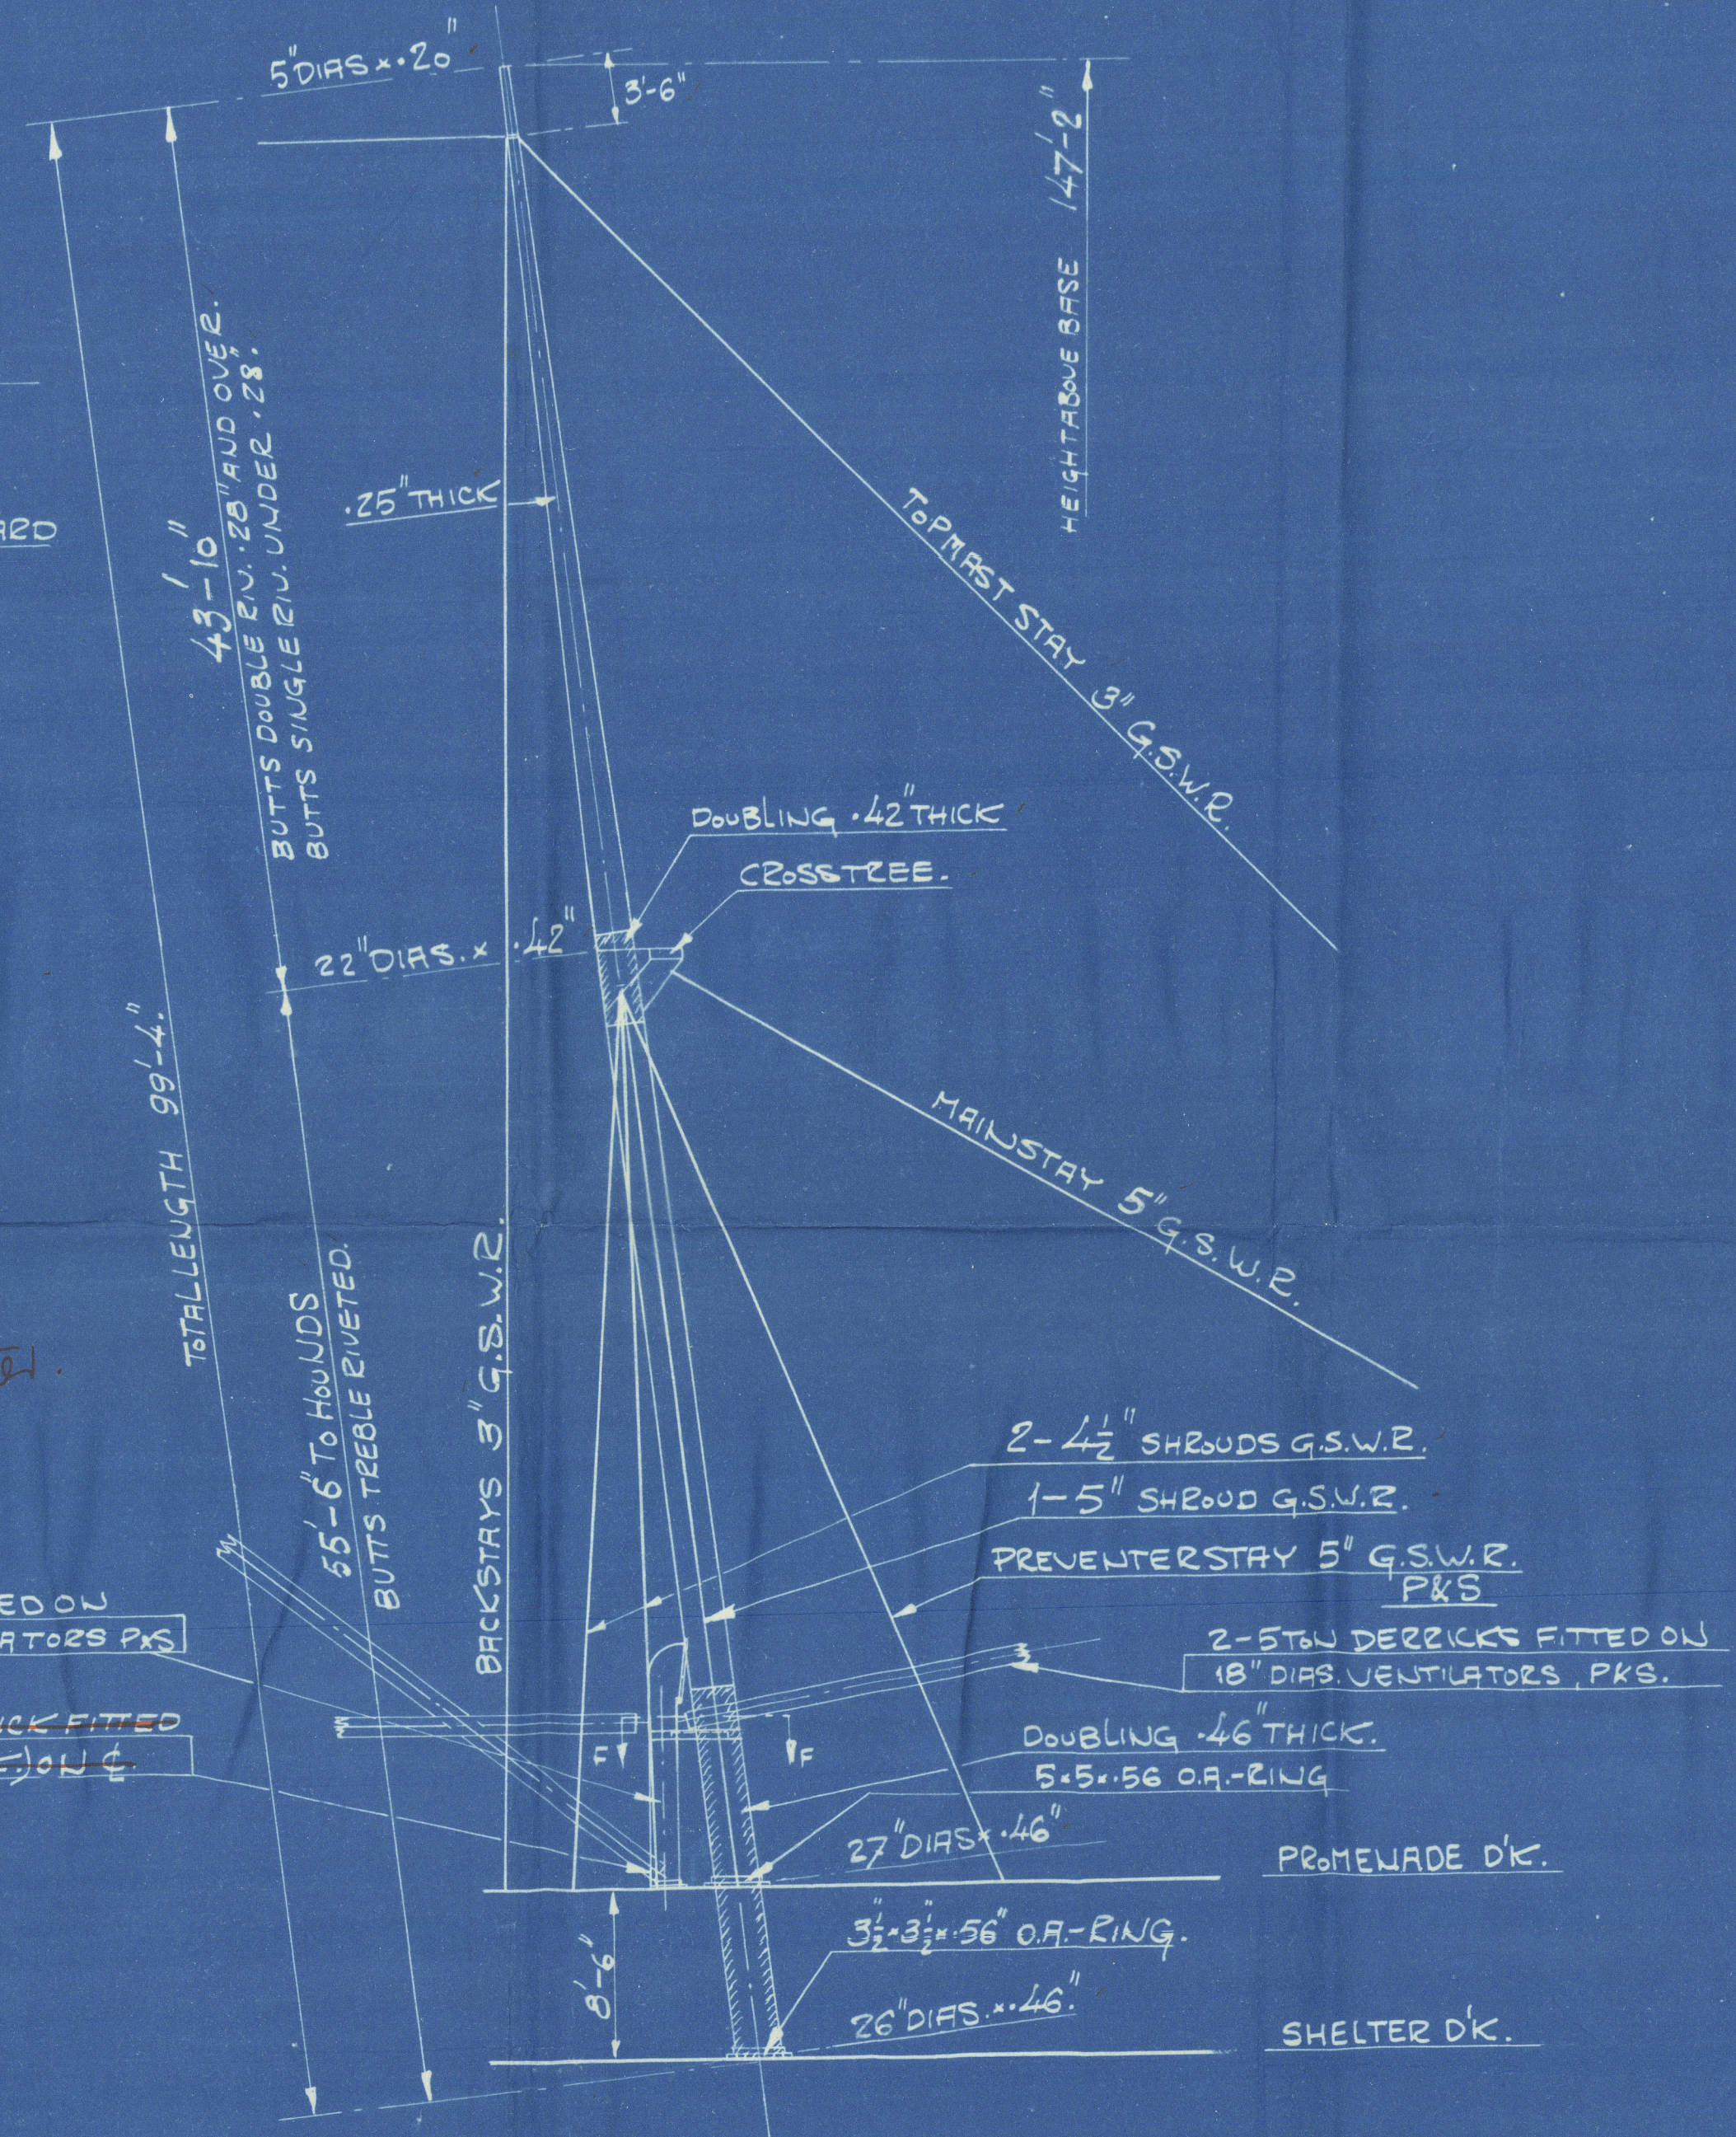

2-8 TON DERRICKS FITTED ON 18\"/>



3-5 TON DERRICK FITTED (HEEL ON DECK) ON ϕ .

N \equiv 1572
MAST SCANTLINGS.
SCALE $\frac{1}{8}$ " = 1 FOOT.

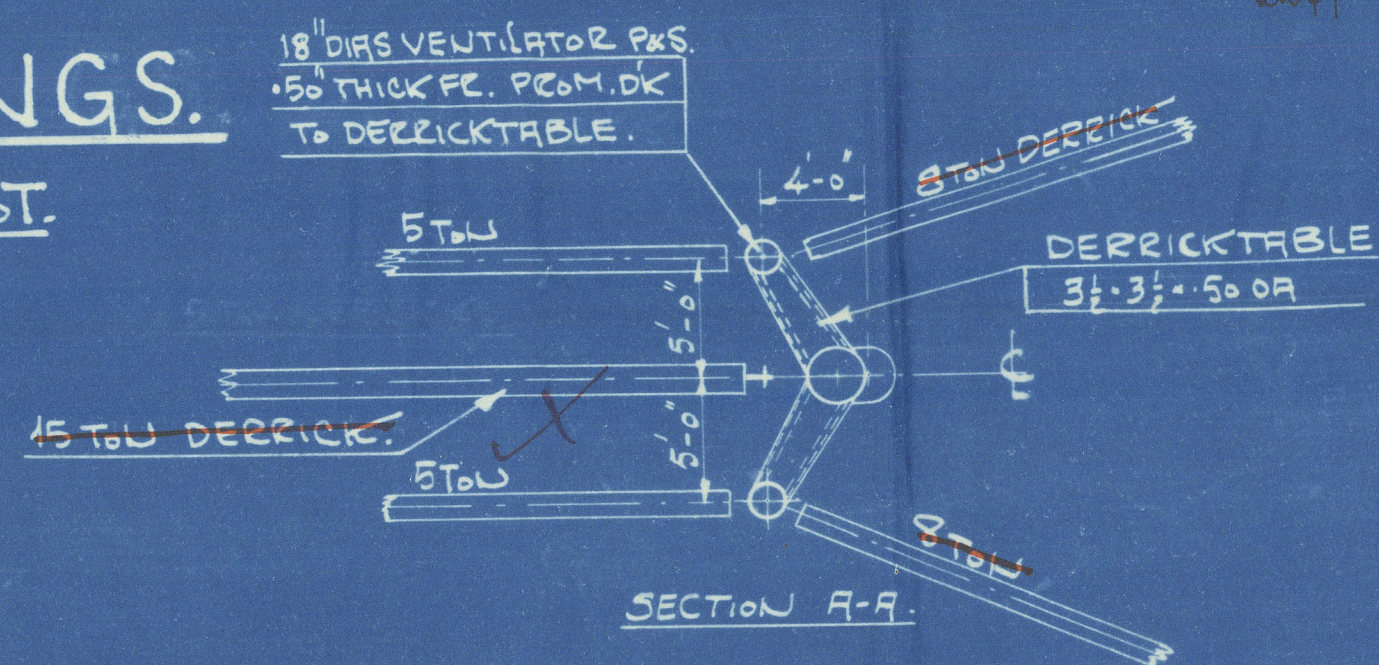

MASTRINGS WELDED TO MASTS.
RIVETED TO DECK.

supplied under masts to satisfy satisfaction.

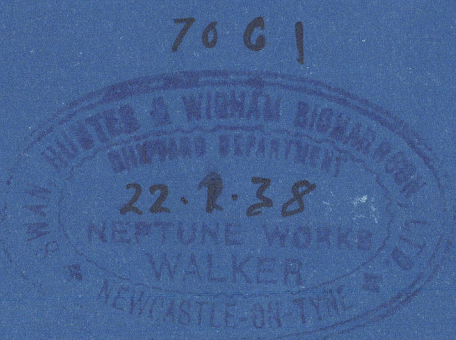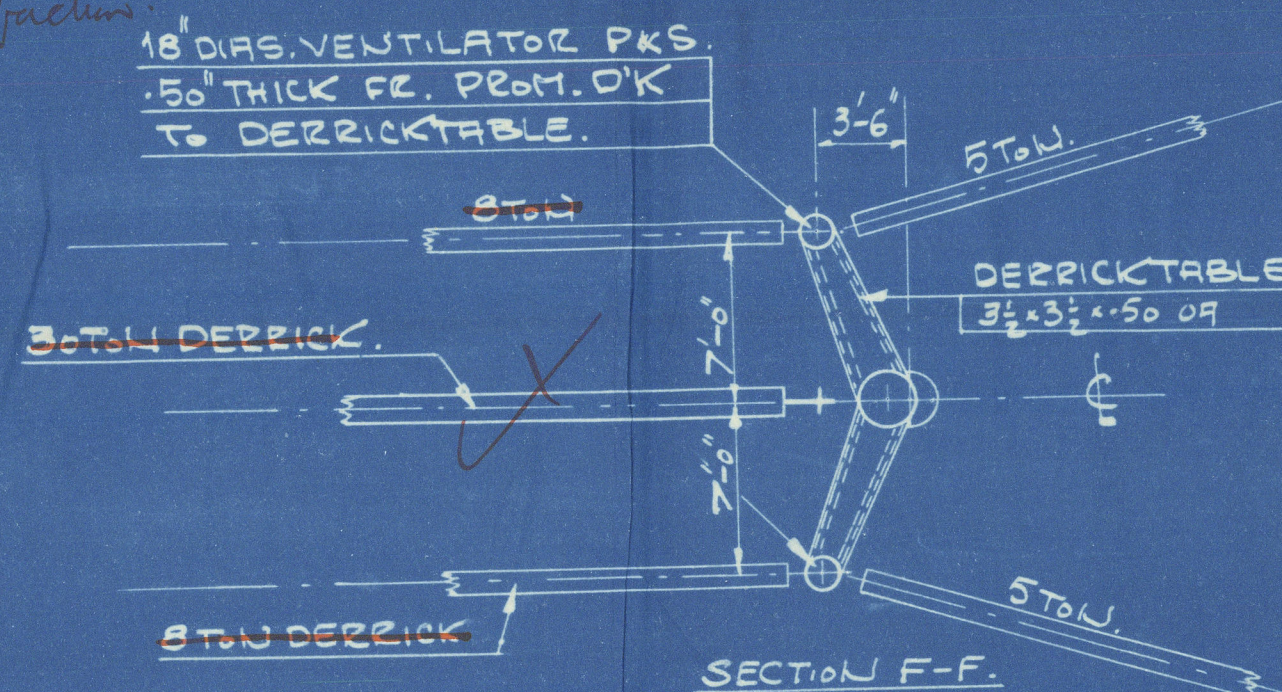

SHWR 1572

30

Mar. & Rigging

EX *m.v. Sobieski*

NEWCASTLE ON TYNE.

Report No. 97503.

4/4 "GRUZIA"

M.M. 8446



© 2020

Lloyd's Register
Foundation

008446-008454-0014