



151, 153, 155, 157, 159 & 161. (RIVERS STEAM NAVIGATION CO. LTD.)

DIMENSIONS :- 190'-0" L.W.L. x 30'-0" BDRTH. MLD. x 12'-6" DPTH. MLD.


SCALE ~ 1/8" = 1 FOOT.

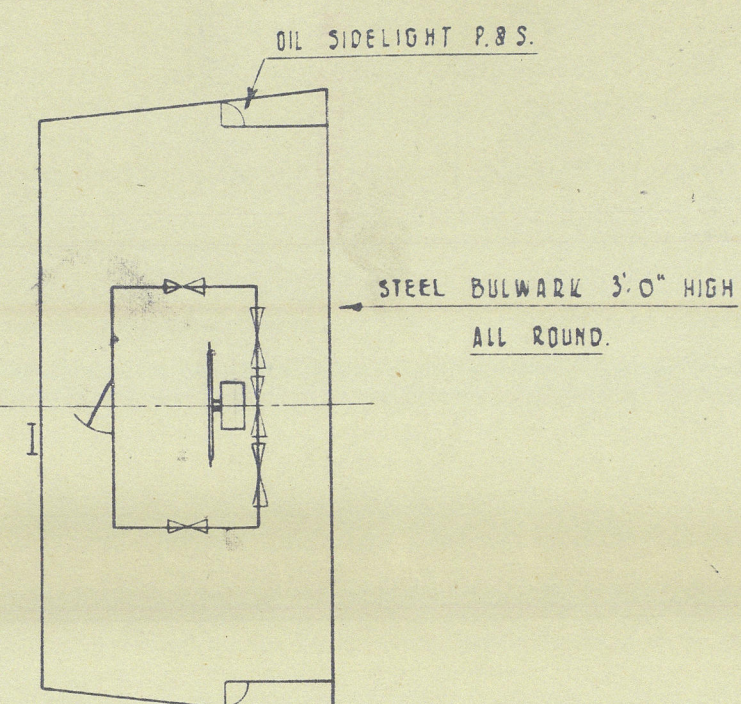

WHEELHOUSE.


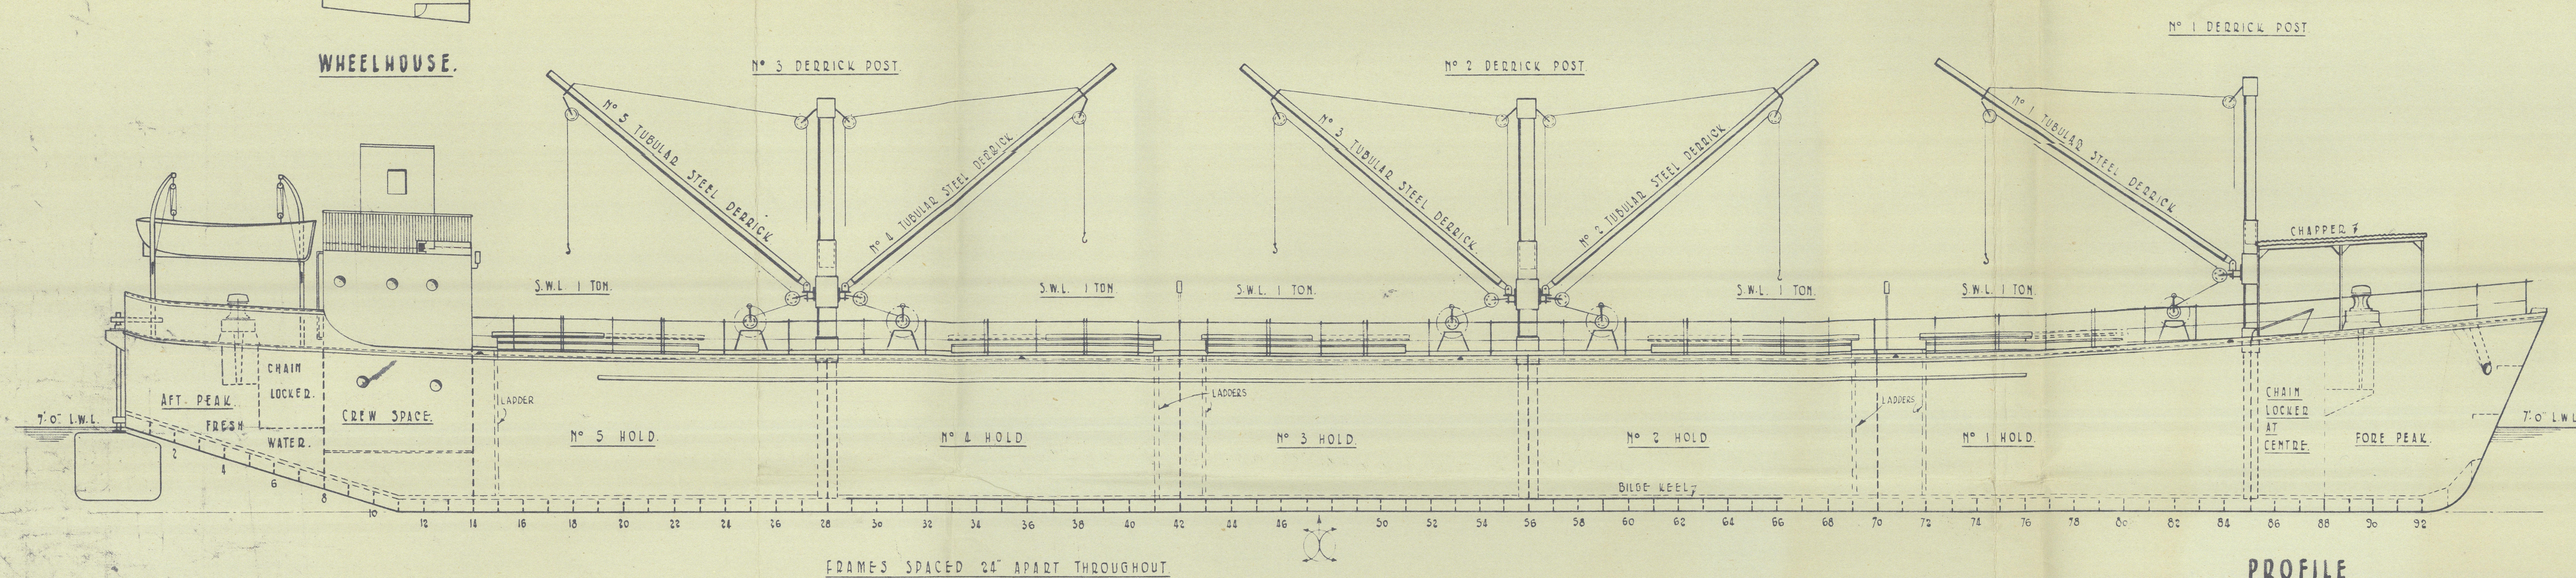


PROFILE

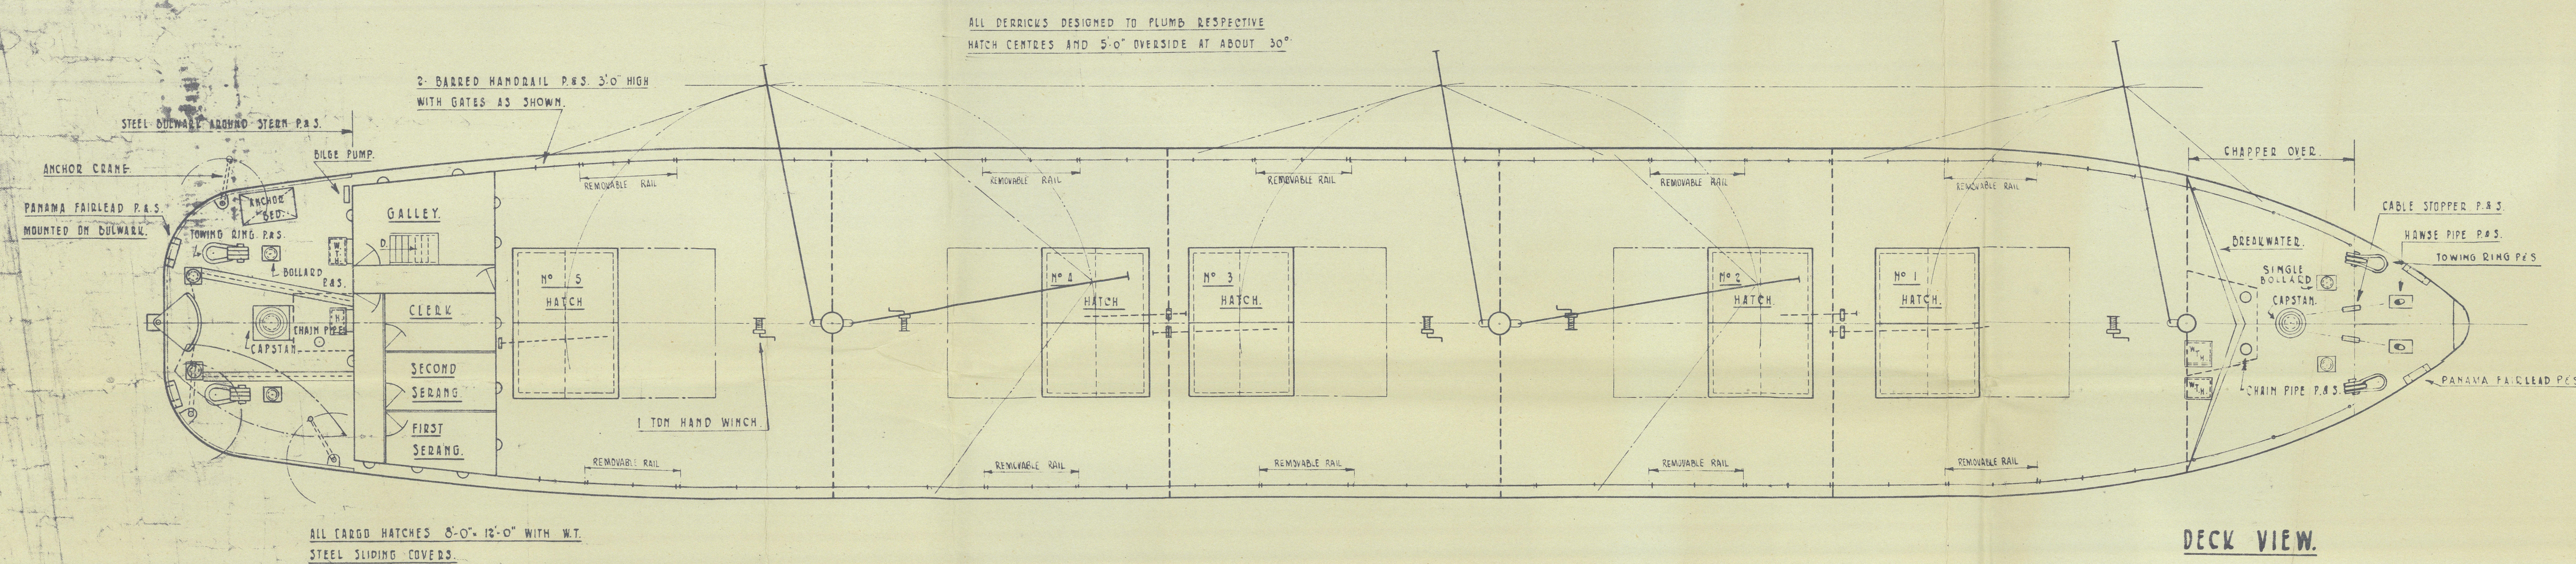


DECK VIEW.

GENERAL ARRANGEMENT.

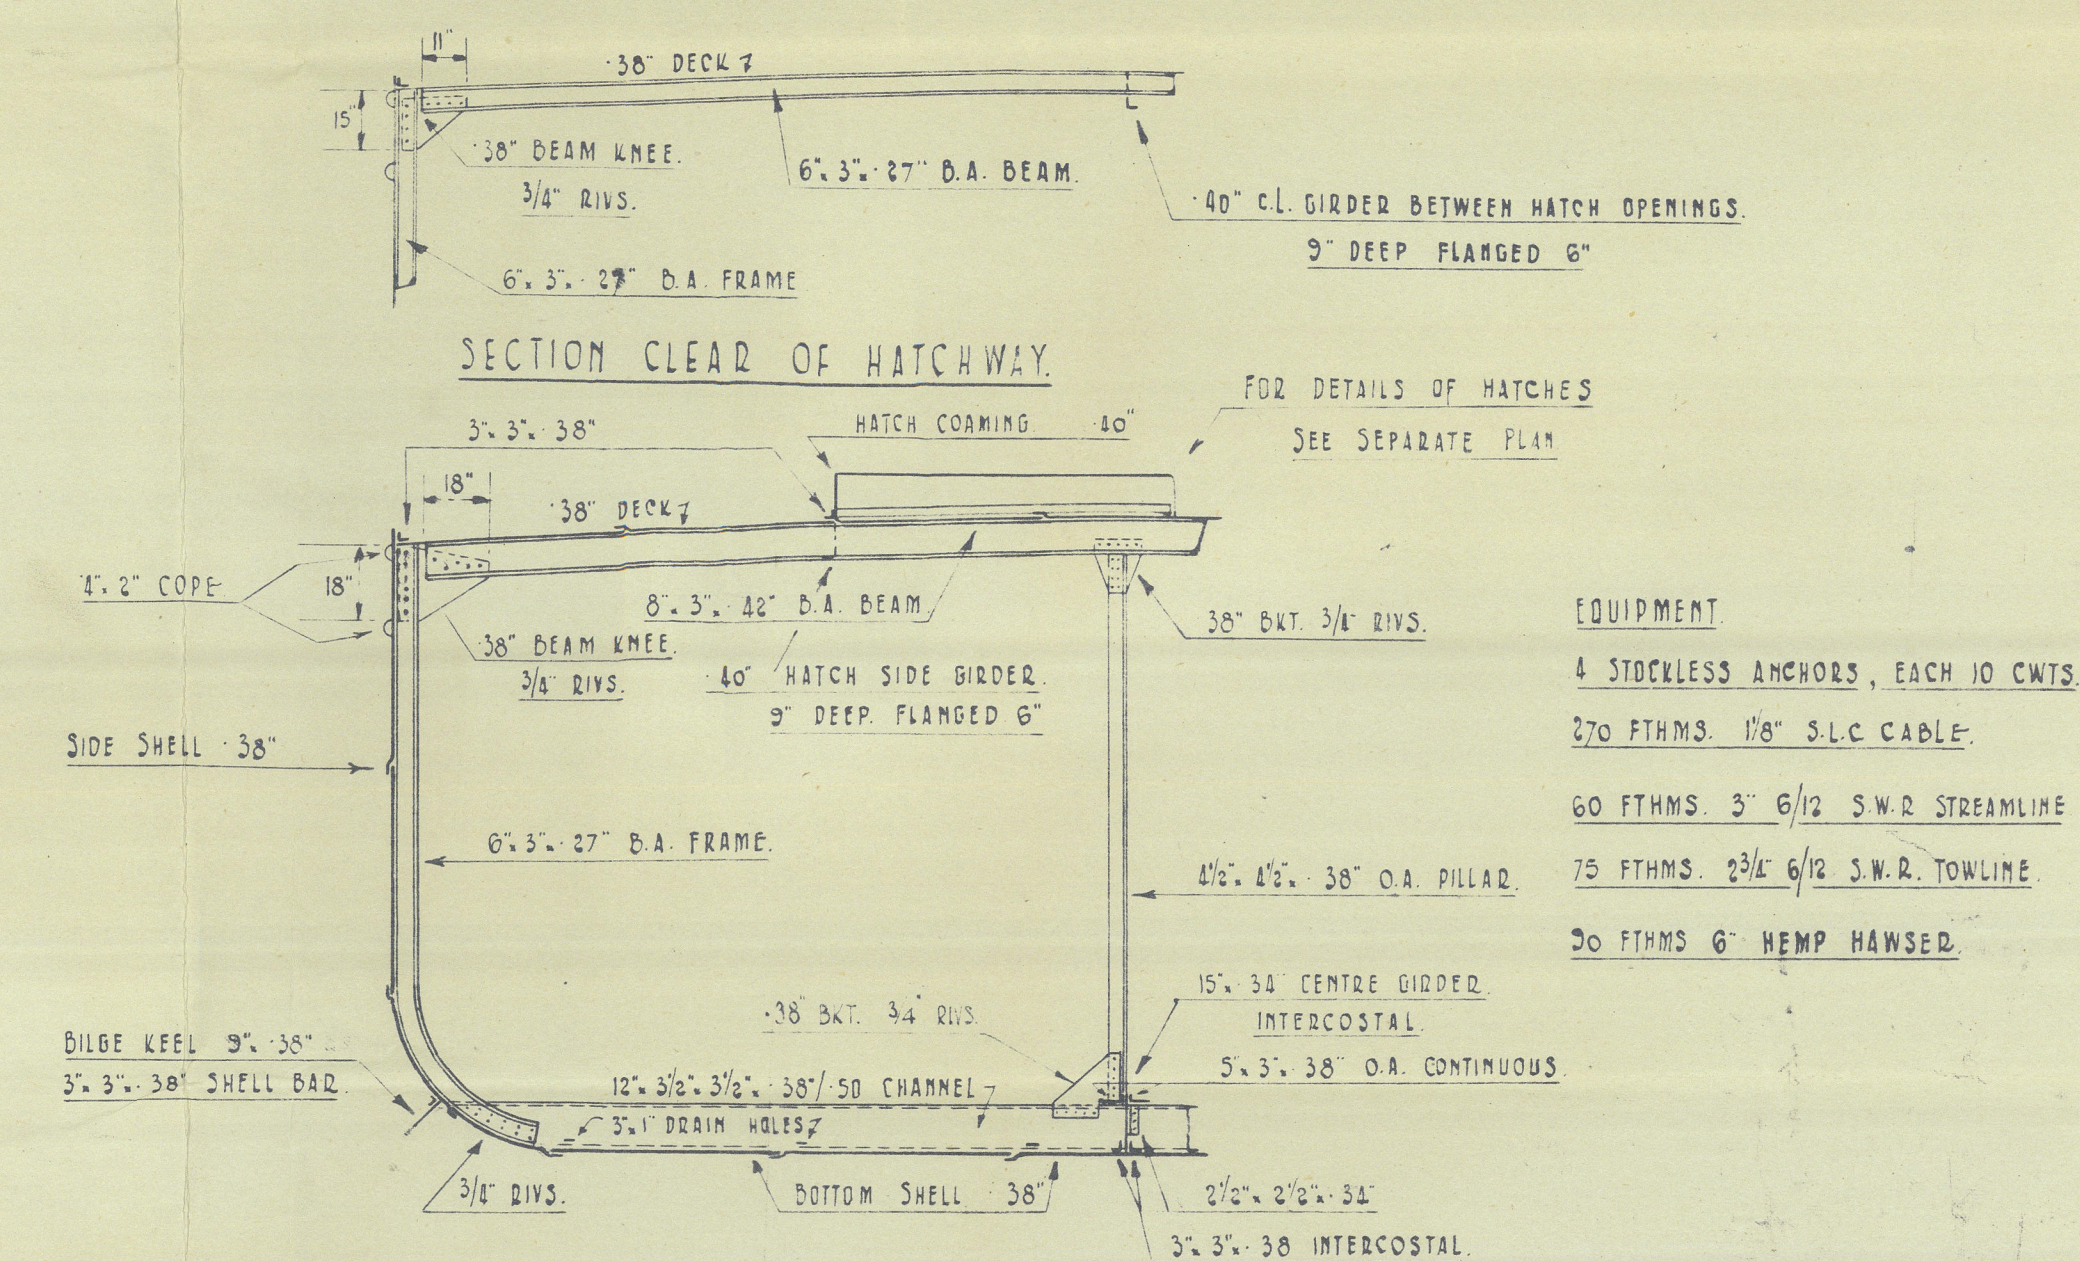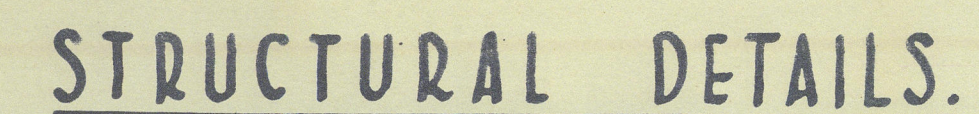

SECTION AT HATCH END.

SCALE - $\frac{1}{8}'' = 1$ FOOT.

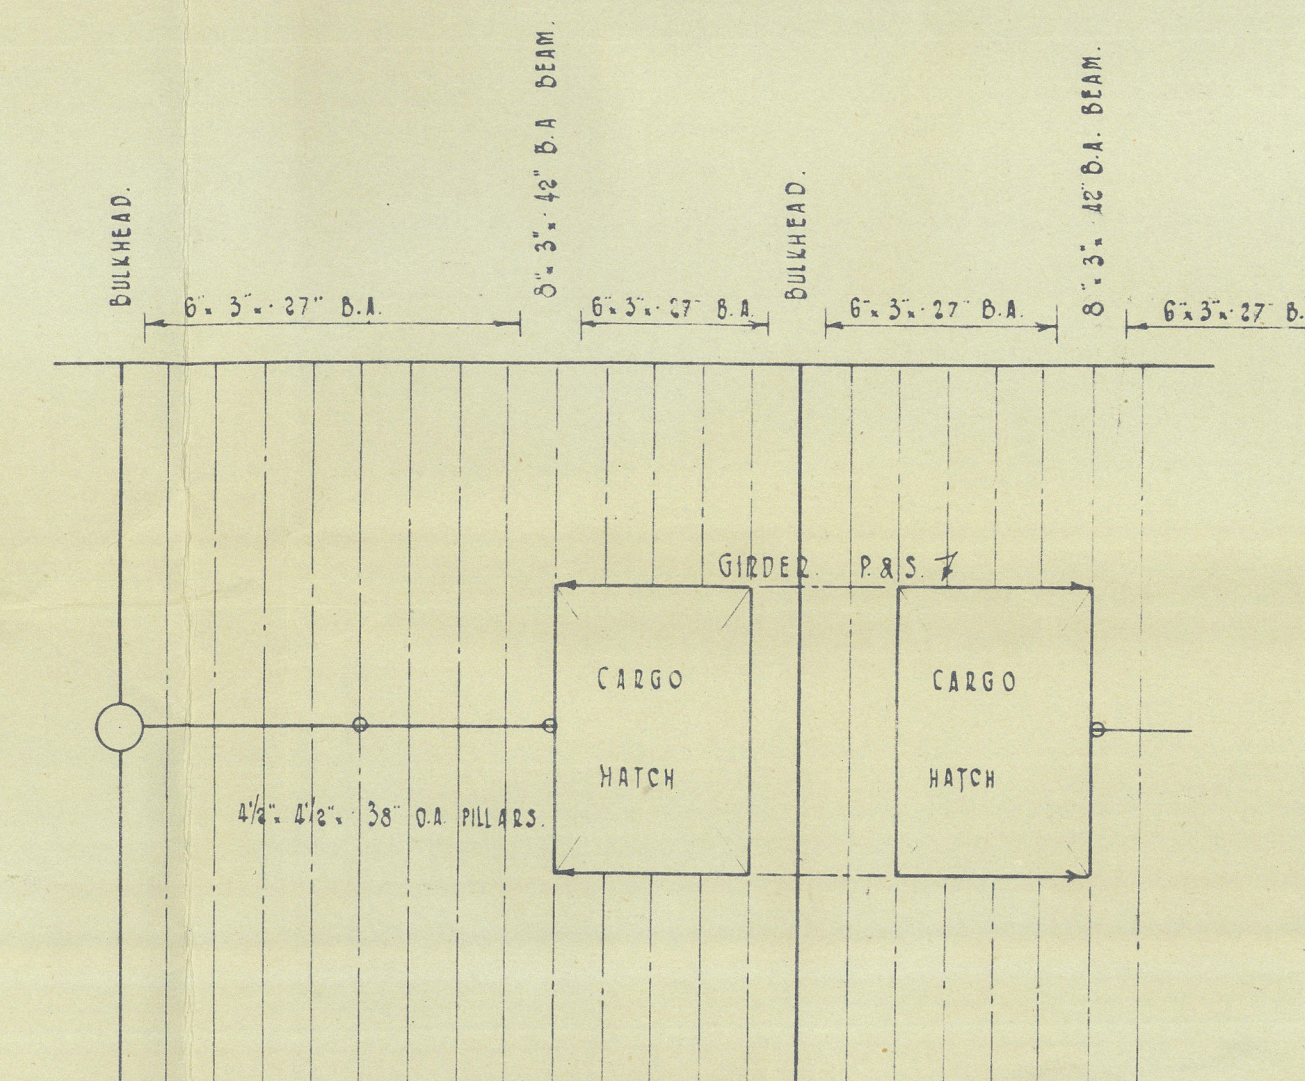

TYPICAL PLAN SHOWING LAYOUT OF PILLARS, GIRDERS & BEAMS

SCALE ~ 1/8" = 1 FOOT.

CLELANDS (SUCCESSORS) LTD.

Yard No 158


gen. dwt & structural details

(As Erected)

NEWCASTLE-ON-TYNE, No. 108227.

MANGAL' ★

RECORDS DEPT.
LONDON

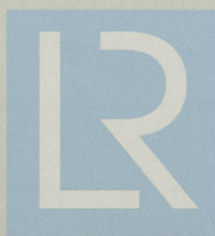

© 2020

Lloyd's Register
Foundation

008446-008454-0115