


158 "AS ERECTED"  
N<sup>o</sup>s 150/161 (12 CRAFT) DIMENSIONS :- 190'-0" L.W.L x 30'-0" BPTH. MLD. x 12'-6" DPTH. MLD.  
MAIN DECK. APPROVED BY LLOYDS 5:8:49.

SCALES - 1/4" = 1 FOOT & AS MARKED.

SIDE FRAMES, ALL 6"x3"x27" B.A.s., SPACED 24" APART THROUGHOUT.



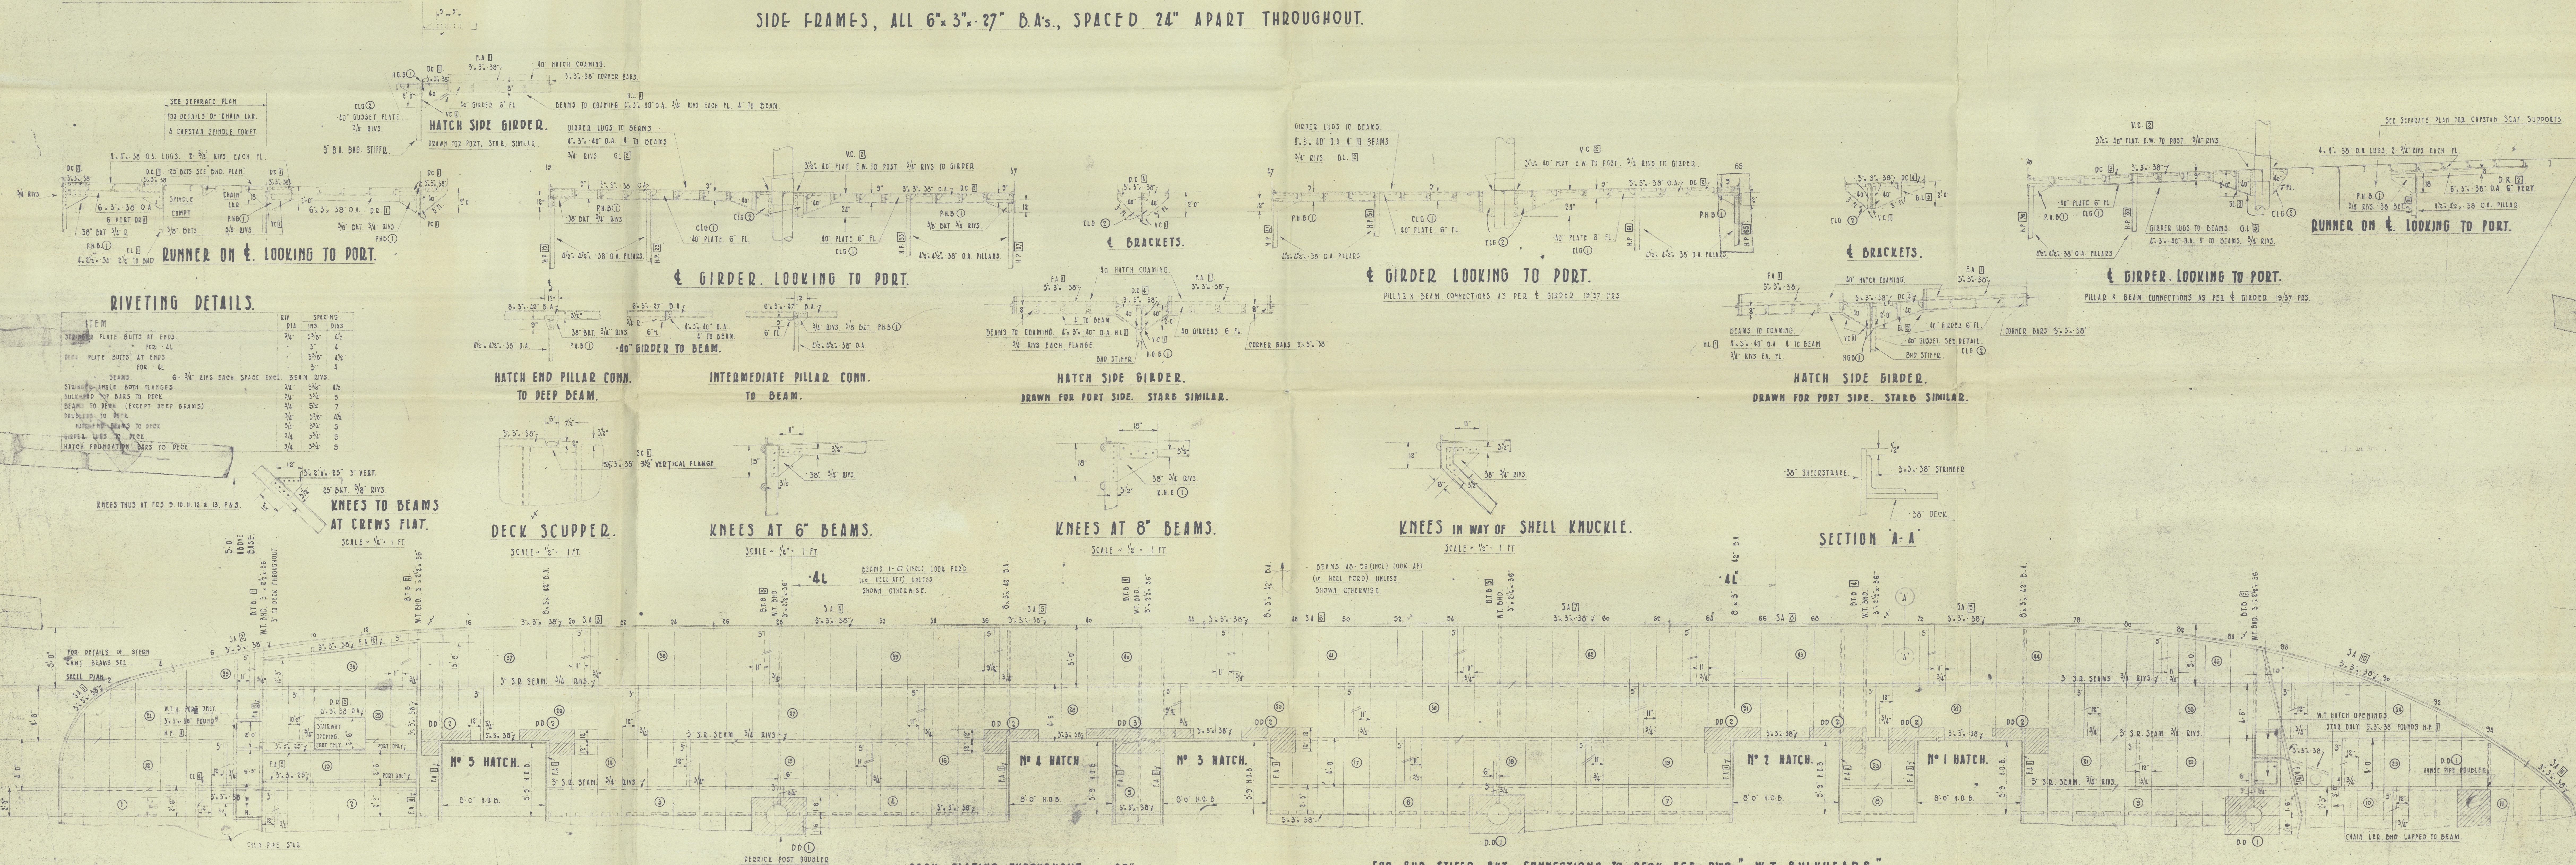

3

CLLANDS (SUCCESSORS) LTD.


'MANGAL' ★

Yard No 158

Main Deck (As Erected).

NEWCASTLE-ON-TYNE, No 108227.

RECORDS DEPT.  
LONDON

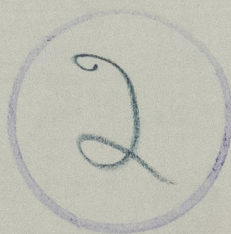

© 2020

Lloyd's Register  
Foundation

008446 · 008454 · 0116