

SCALE 1/2" = 1 FOOT

EQUIPMENT.


13	2 POWER ANCHORS 6" CWTS.	Stockless (HALL'S) ✓
13.75	1 STREAM ANCHOR 2 1/4"	EX. STOCK. ✓
2.8	150 FMS. 1 3/16" CABLE	✓
16.44	30 FMS. 6" MANILLA	✓
	120 "	5" ✓
	60 "	12 THREAD HEAVING LINE ✓
	60 "	9" " ✓
	30 "	3 1/2" MANILLA (MESSENGER) ✓

4 MAY 1928

BUNKER CEILING 2 $\frac{1}{2}$ " W.P.
RUBBER BEAD BAR. 3 $\frac{1}{2}$ " x 1 $\frac{3}{4}$ " FOR. 380° P.V.S.

RIVETING. —


BUTTS OF CS KEELSON	D.R.	4 3/8"	5/8 RVS	2 3/4"	✓
BUTTS OF SHELL	D.R.	4 3/8"	5/8 RVS	2 1/4"	✓
BUTTS OF DECK	D.R.	4 7/8"	5/8 RVS	2 3/4"	" To SR outside 3/4 L. ✓
SEAMS OF SHELL	S.R.	2 1/4"	5/8 RVS	2 3/4"	✓
SEAMS OF DECK	S.R.	2 1/4"	5/8"	2 3/4"	✓
FRAMES TO SHELL	5/8" RVS.		7 DIAS	APART, EXCEPT IN AFT PEAK, FORWARD BALLAST TANK, & FROM KEEL TO WELL ABOVE L.W.L. FOR 15L FROM STEM WHERE SPACING IS 5 1/2 DIAS. ✓	
FRAMES & REV. FRAMES TO FLOORS	5/8" R - 7 DIAS	APART	✓		
BEAMS TO DECK PLATING	5/8" RVS.	7 DIAS	APART	✓	
DECK STRINGER BAR TO SHELL & DK.	5/8" R.	4 1/2 DIAS	APART	✓	
WATERWAY BAR	5/8" R.	5 DIAS		✓	
CS KEELSON BARS TO PLATE	5/8" R.	7 "		✓	
CASING BASE BARS (BOTH FLANGES)	5/8" R.	5 "		✓	
CASING & HOUSE STIFFES.	5/8" R.	7 "		✓	
SEAMS & BUTTS OF CASING & HOUSES	5/8" R.	4 1/2 "		✓	
ECK " " " " COMBINES	5/8" R.	4 1/2 "		✓	
BULKHEADS BOUNDARY BAR TO BND.	5/8" R.	4 1/2 "		✓	
" " " " TO SHELL & DK.	5/8" R.	5 "		✓	
CAN. ELM NILES " STIFFES TO PLATING	5/8" R.	7 "		✓	Closed at Ends if No Br.
" SEAMS OF PLATING	5/8" R.	4 1/2 "		✓	
(E) 5 x 3/4 " BUTTS OF PLATING	5/8" R.	4 1/2 "		✓	

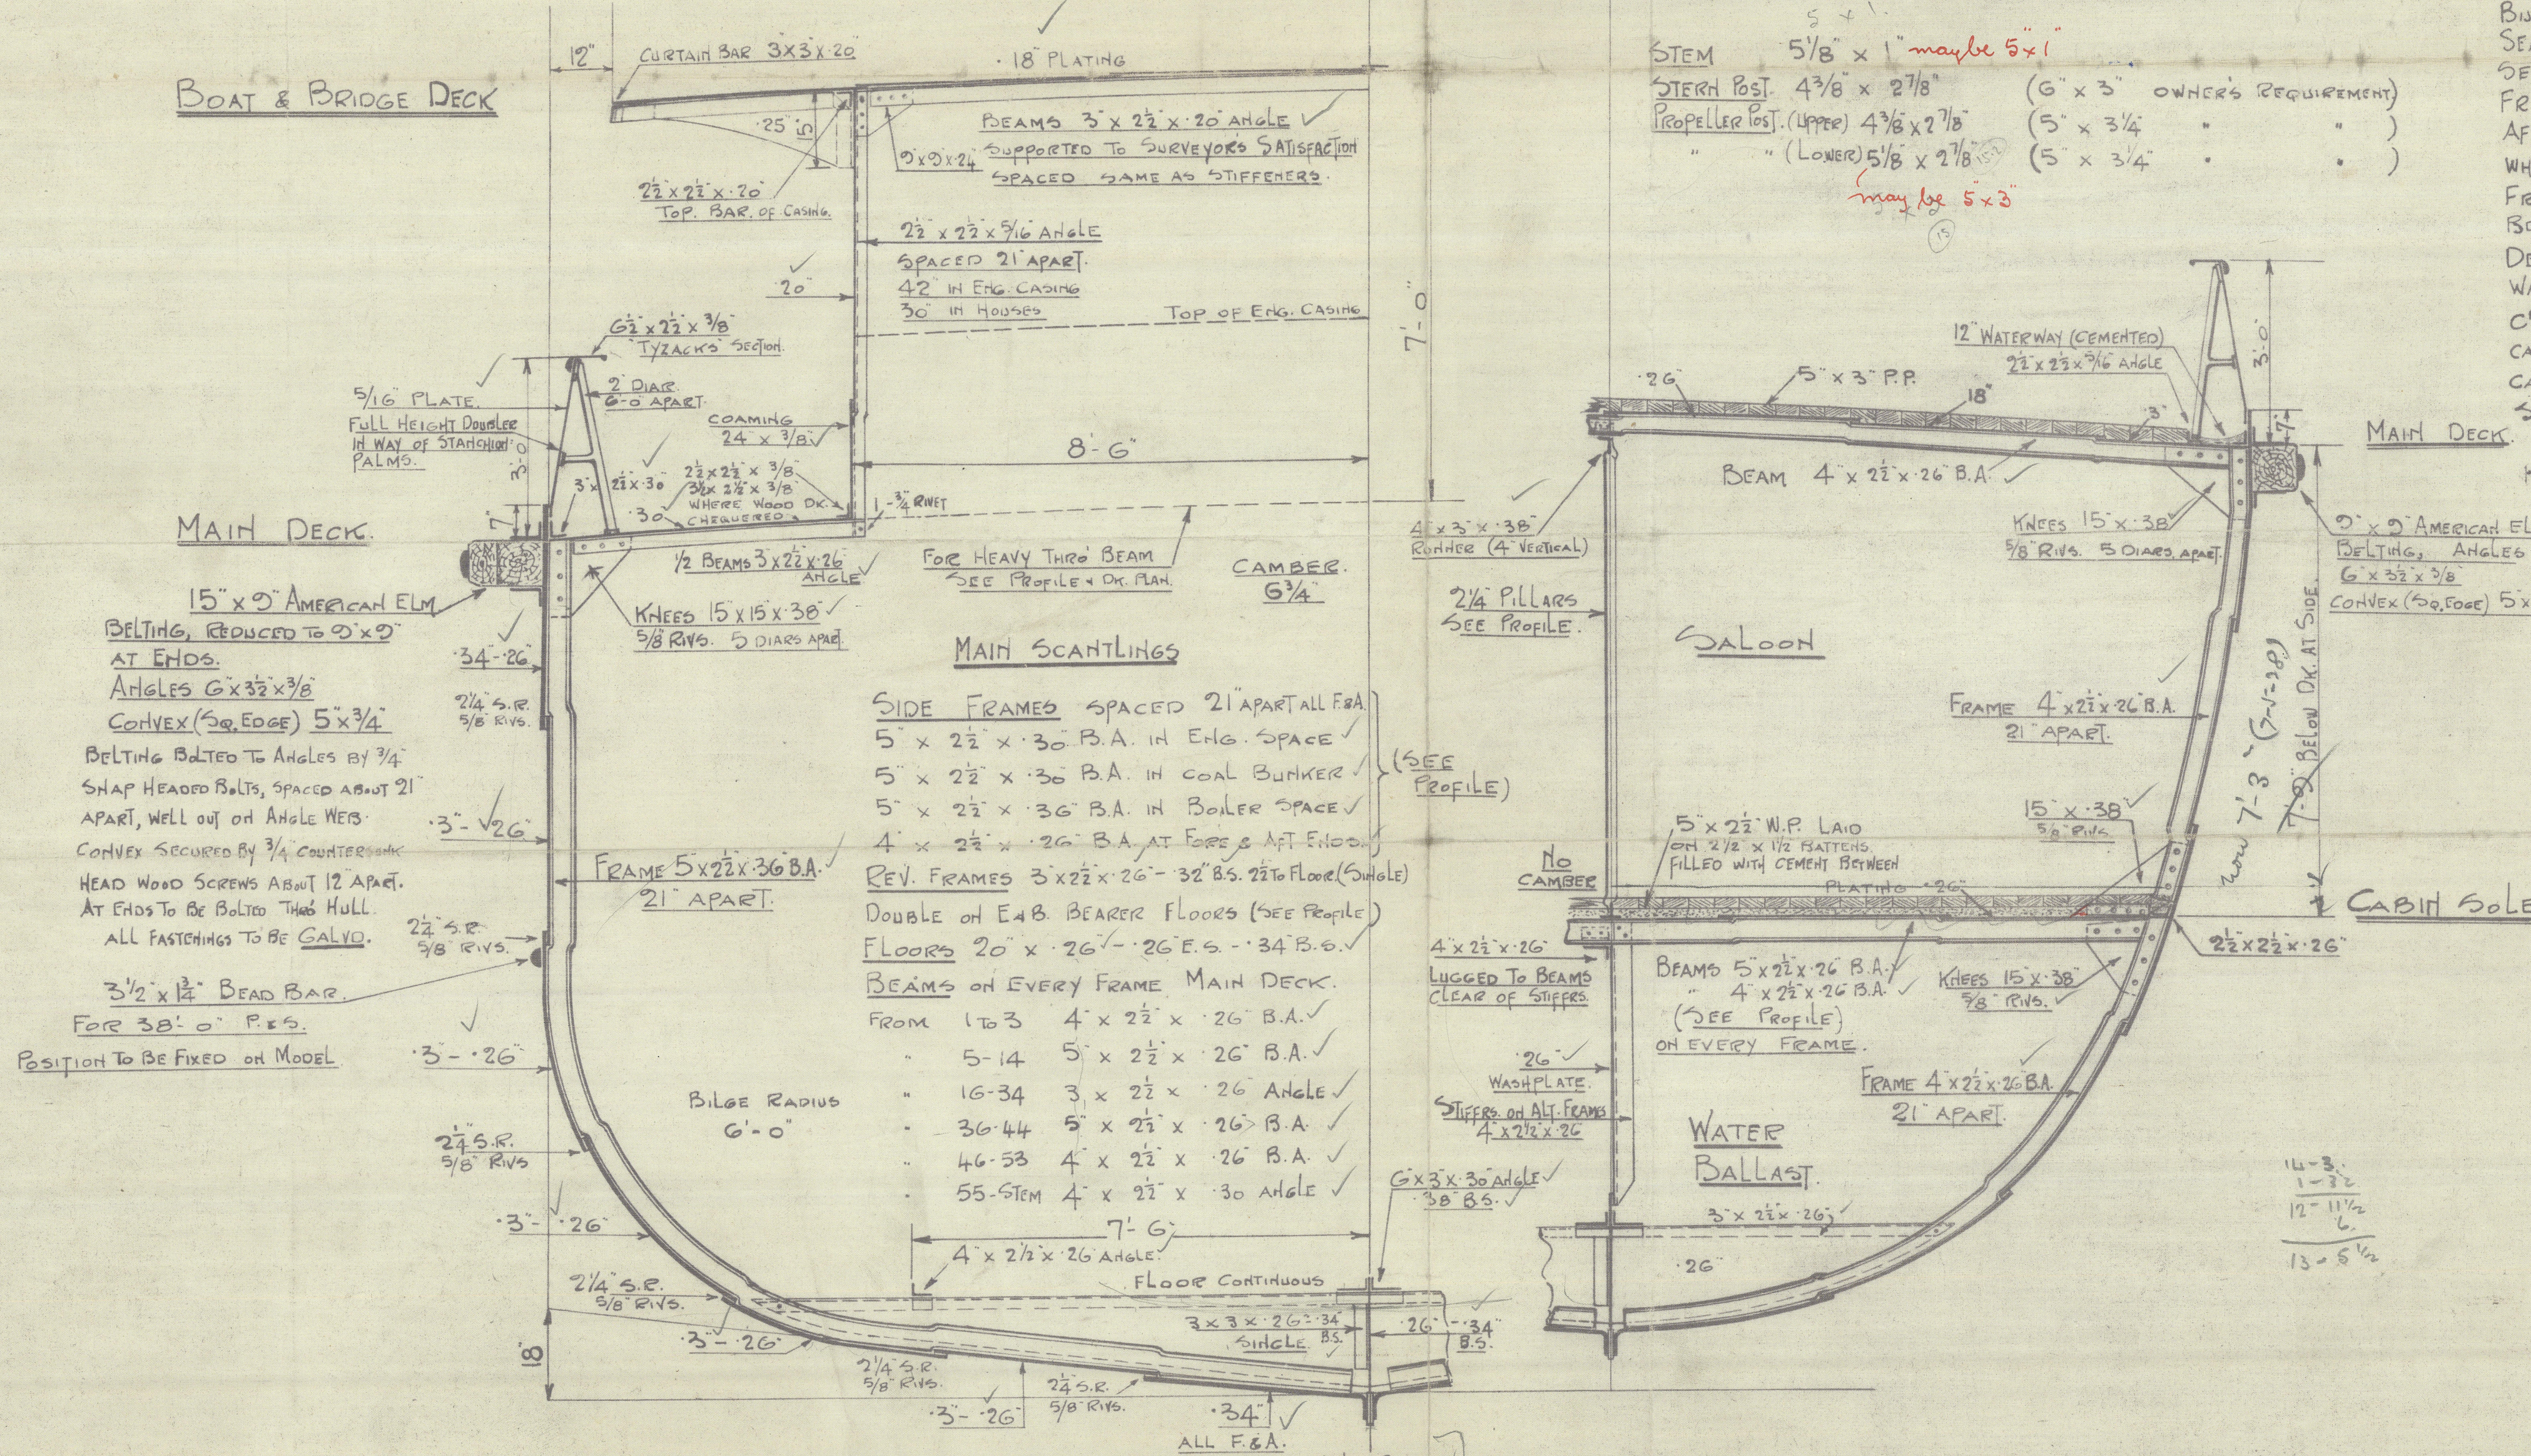

SECTION THRO' BOILER SPACE.

SECTION THRO' WATER BALLAST TANK FORWARD

SECTION THRO. ENGINE SEATING
FLOORS 17, 18, 19, 20, & 21.

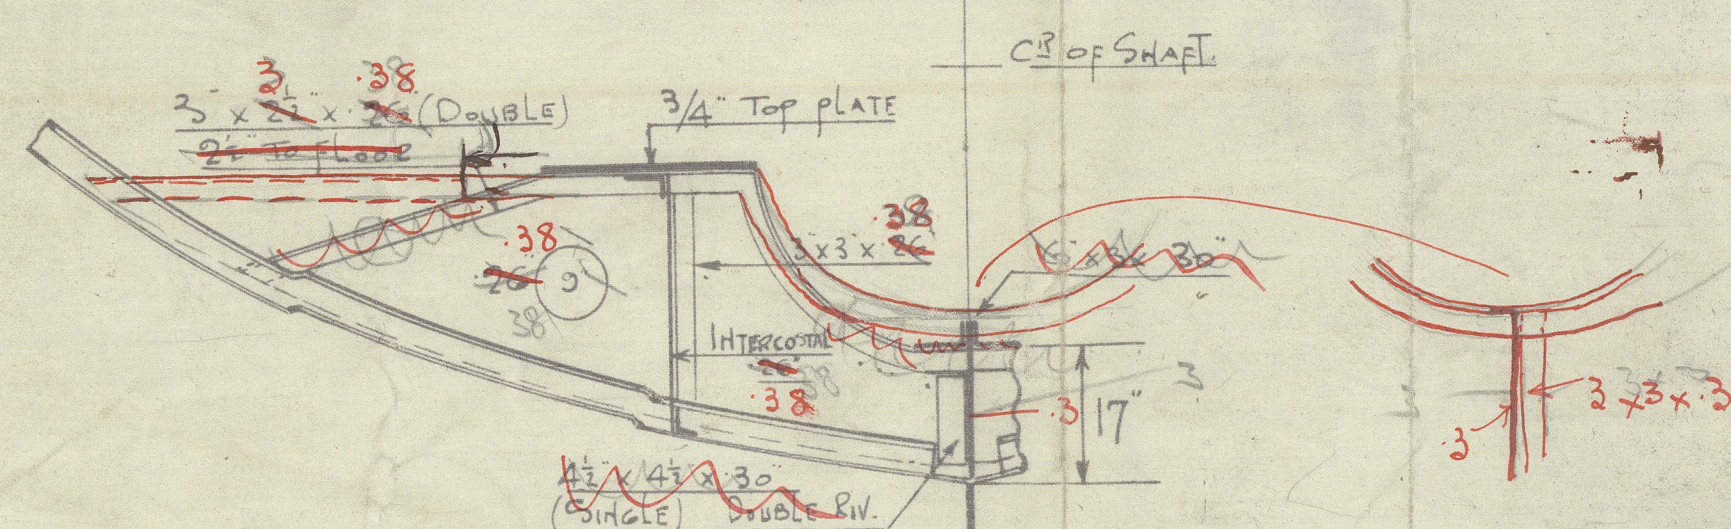

2/480
3-5-28

© 2020
Lloyd's Register
Foundation

1
Midship Section.

Gow, Mc Lachlan & Co. Ltd.

N^{os} 480. + 487.

J. b. 16. 5. 28.

H. 5. 28.

" 6. 3. 29 for 487.

480 ^{2/3} "Flying Eagle" *

487 ^{2/3} "Flying Hile."



© 2020

Lloyd's Register
Foundation

008446-008454-0134