

STERNPOST & RUDDER.

SCALE 1" = 1 FOOT.


DETAILS - SCALE 3" = 1 FOOT.

NOTE.
STERNPOST (AFT POST) IS INCREASED 10" OVER
B.C. DIMENSIONS OWNER'S REQUIREMENTS


C.G. AFT OF CR OF RUTLES 2.75 FT
AREA " " " " 54 sq

STEERING RODS = 1 1/4" DIAM.
STEERING CHAINS = 1" DIAM. OF LINKS


1/8" RIVETS IN ARMS.
7/8" DIAM. SPACED 6 DIAM. APART REELED,
TO 4 DIAM. APART, AT POINTS

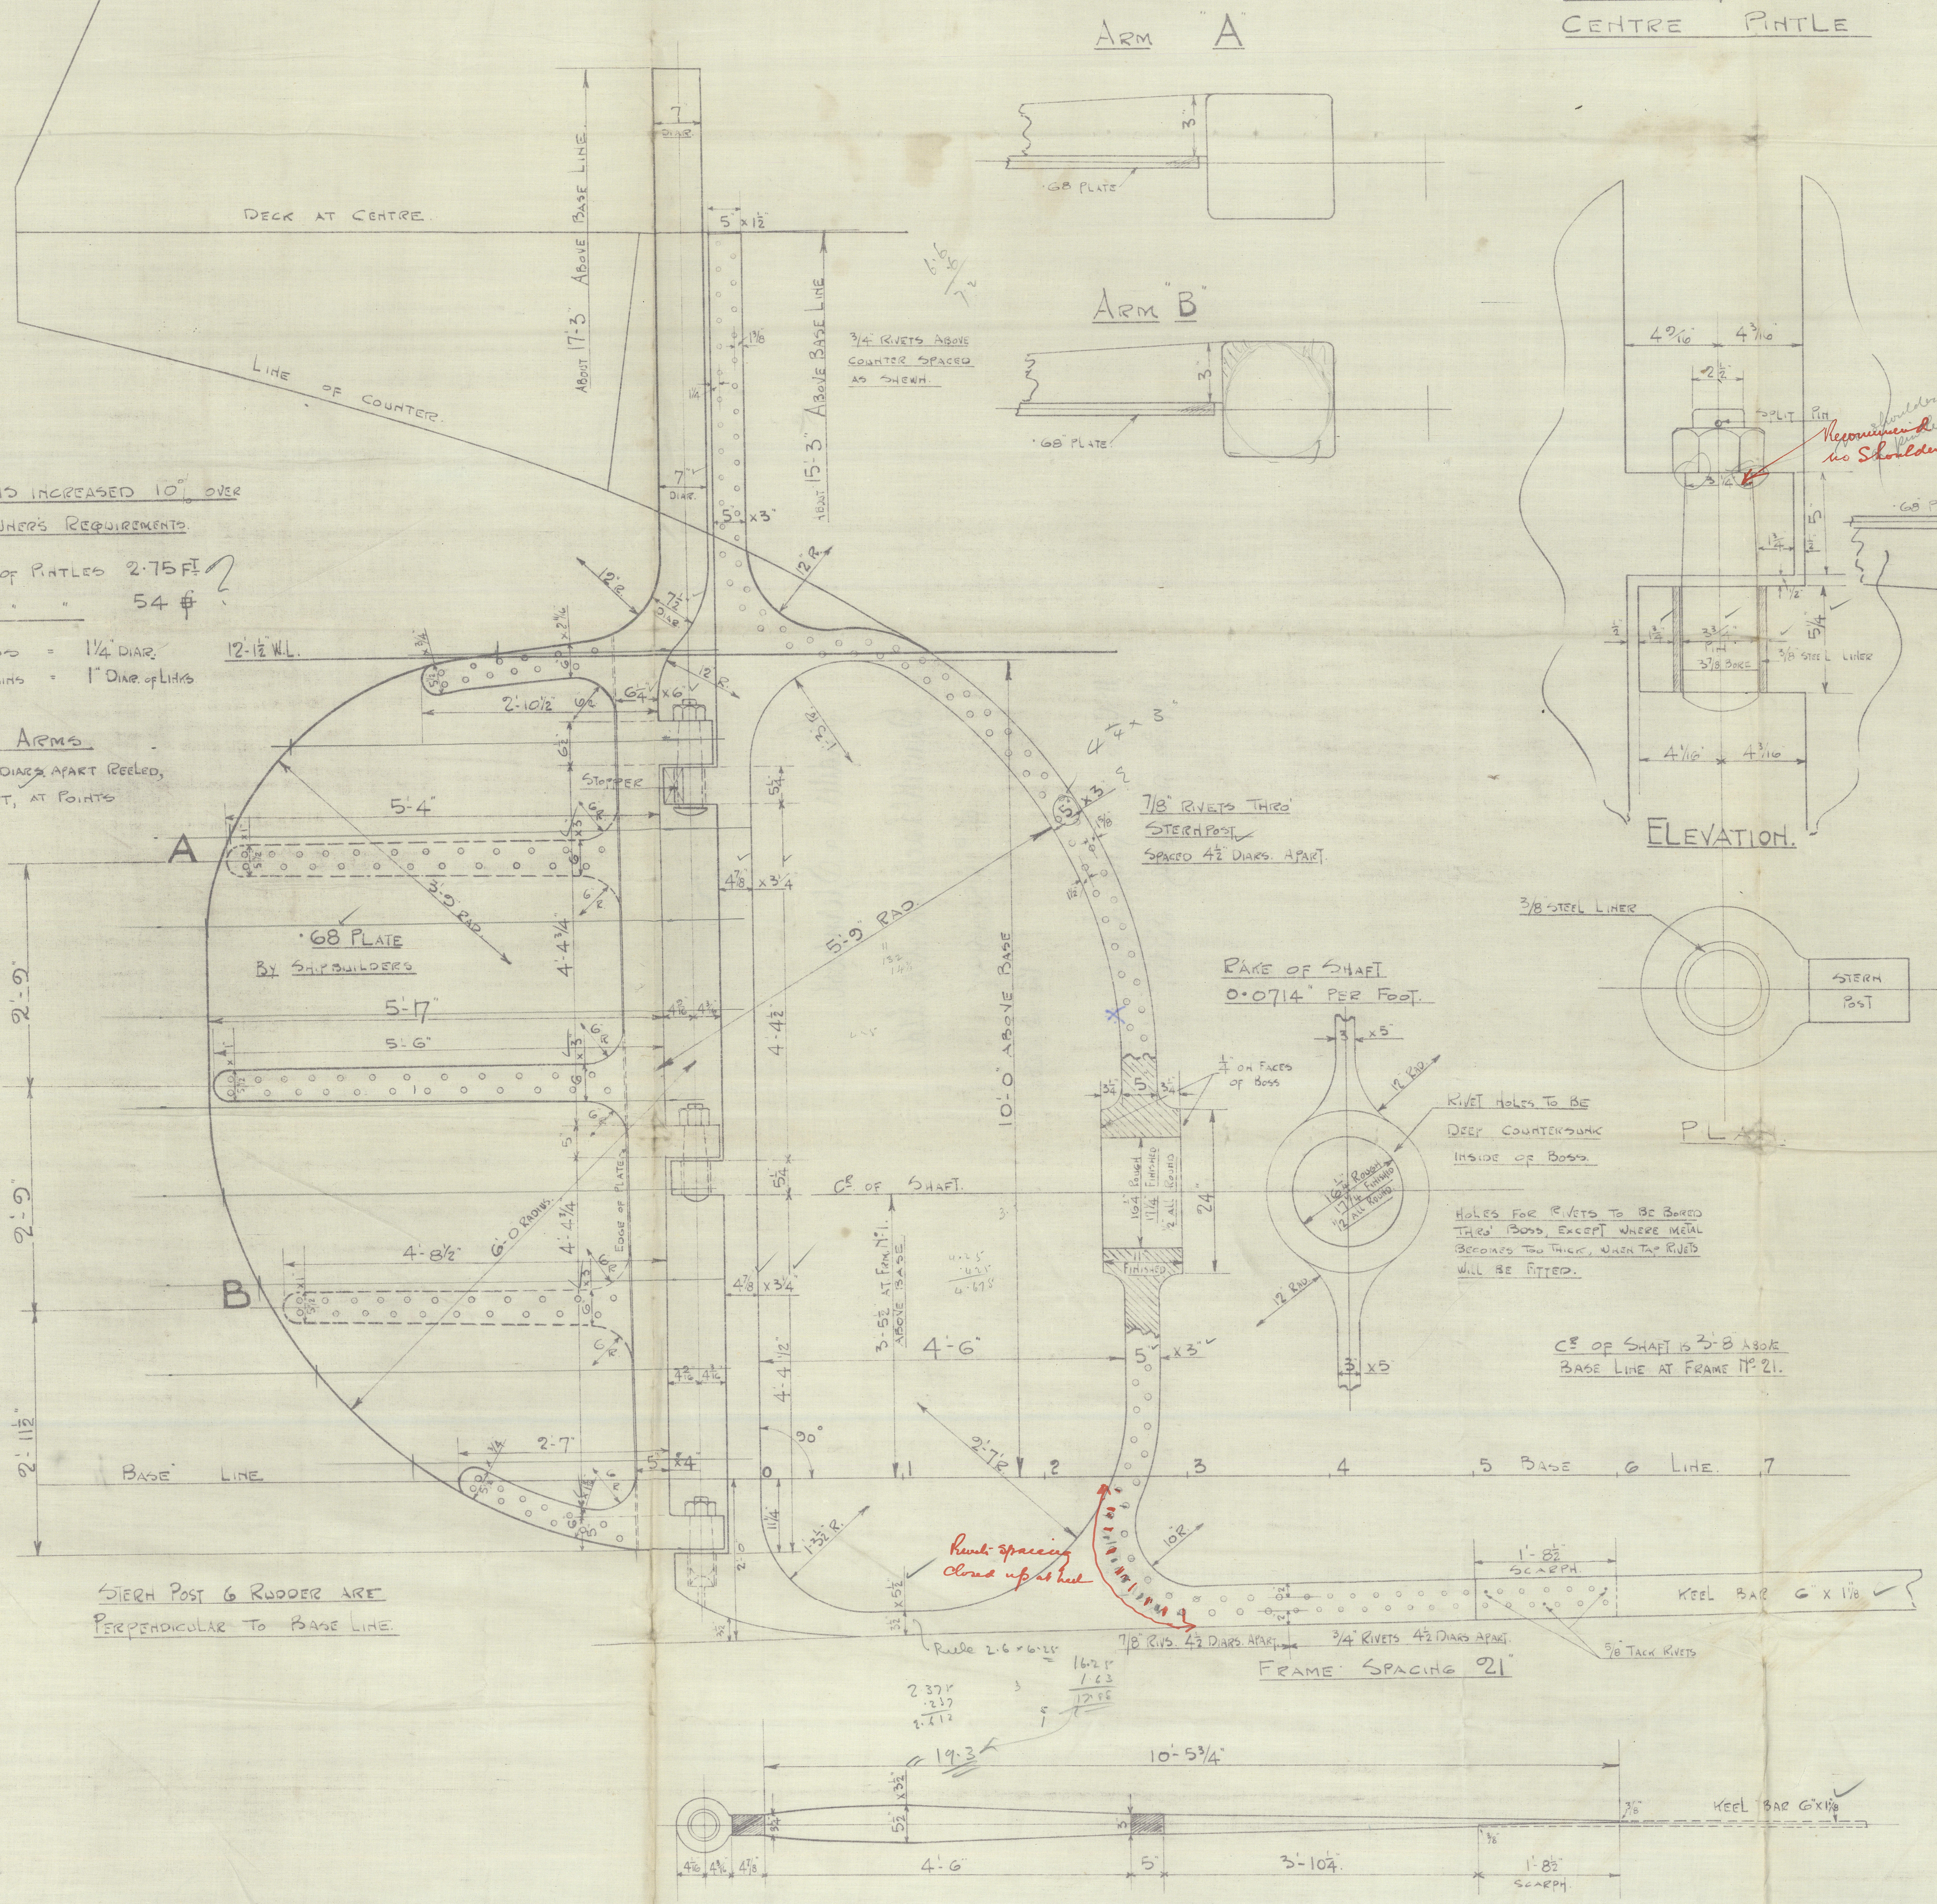


DETAIL OF
CENTRE RUTLE

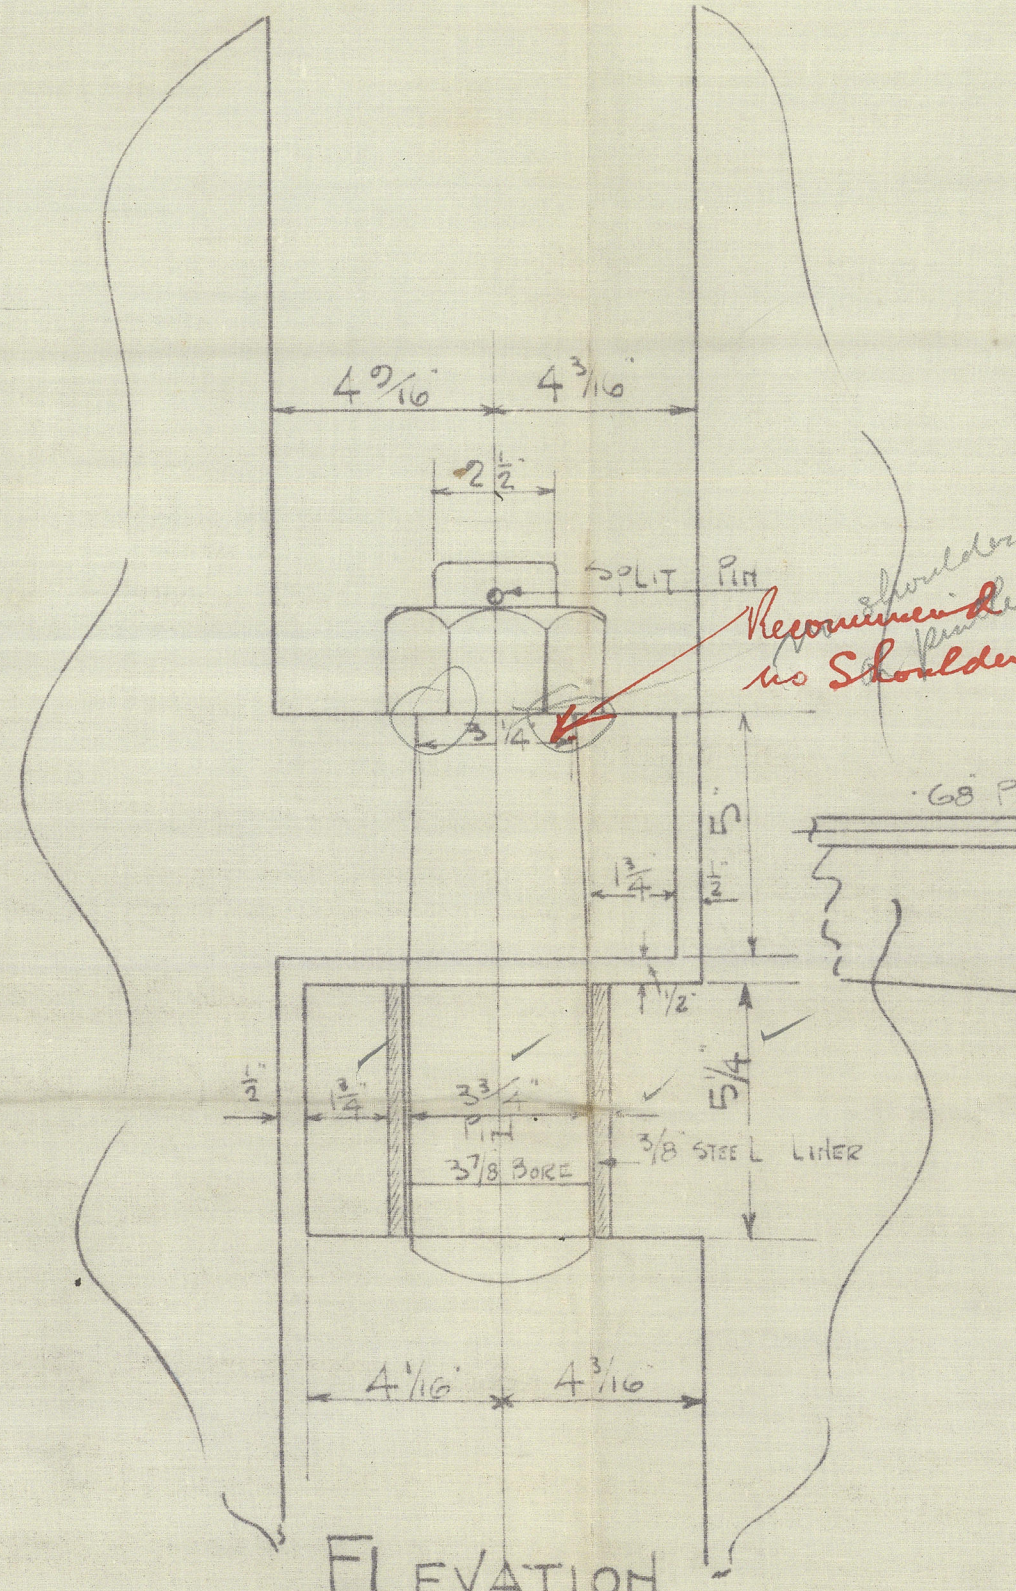

DETAIL OF TOP RUTLE
& STOPPERS.

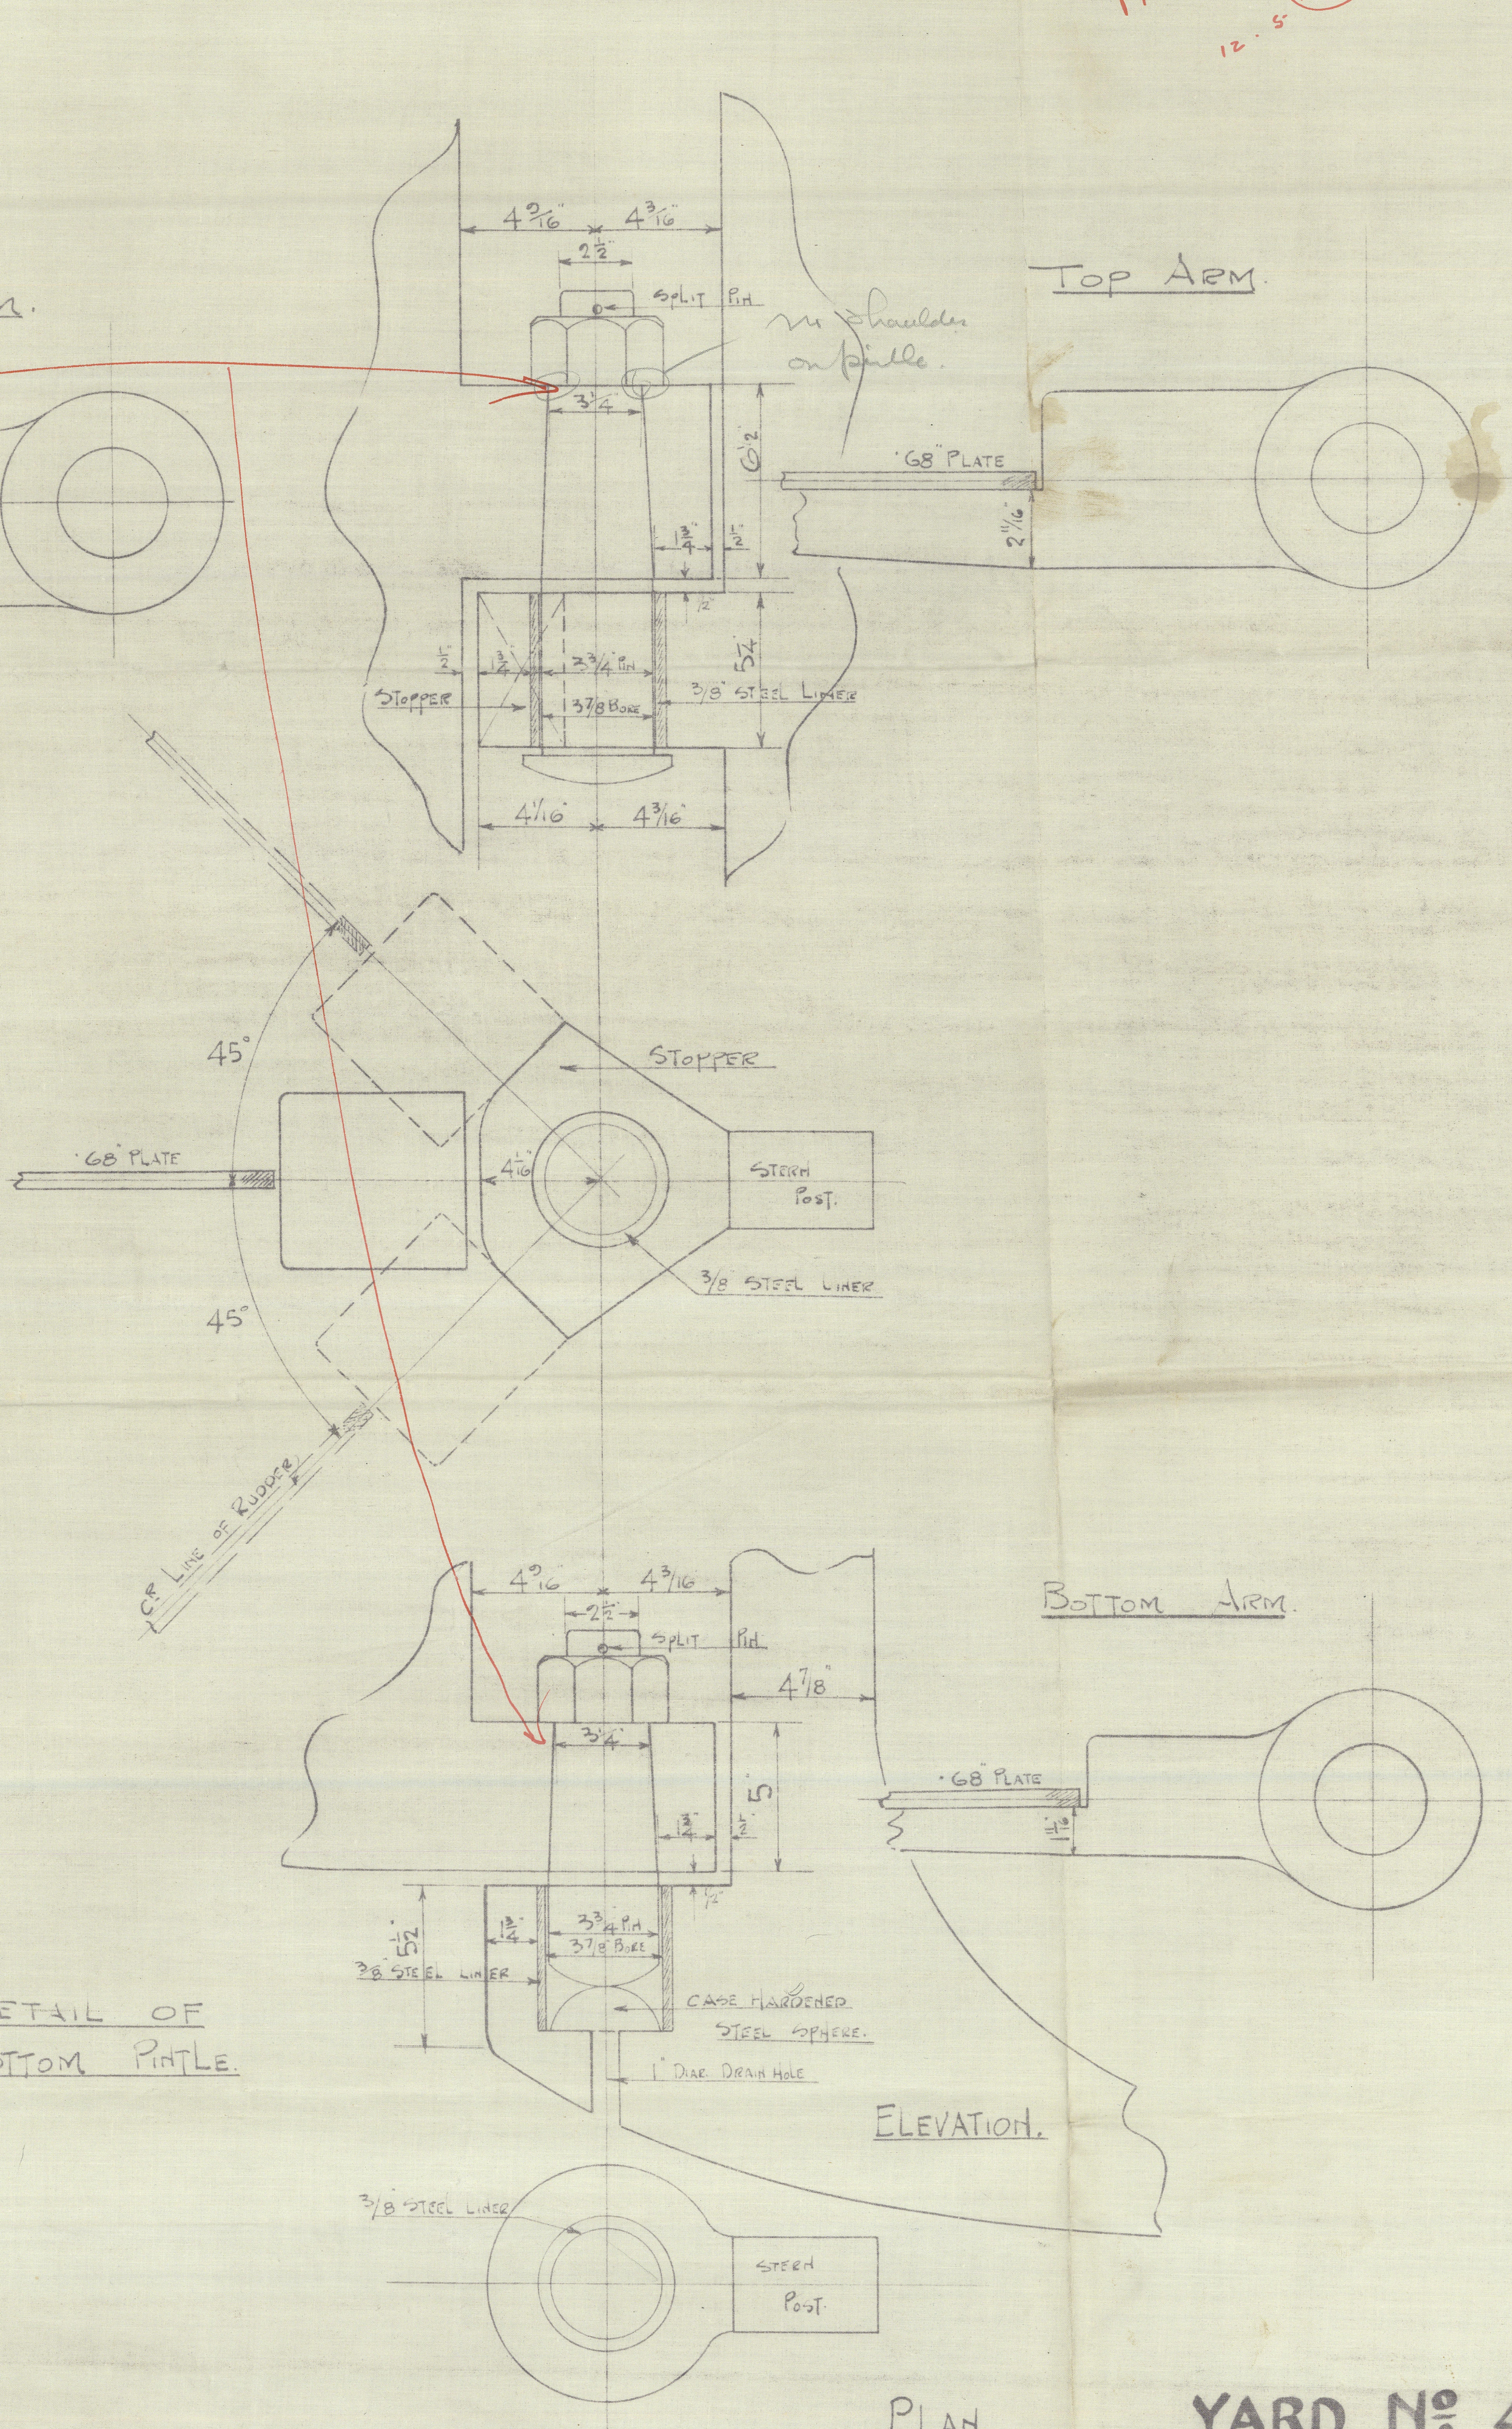

DETAIL OF
BOTTOM RUTLE

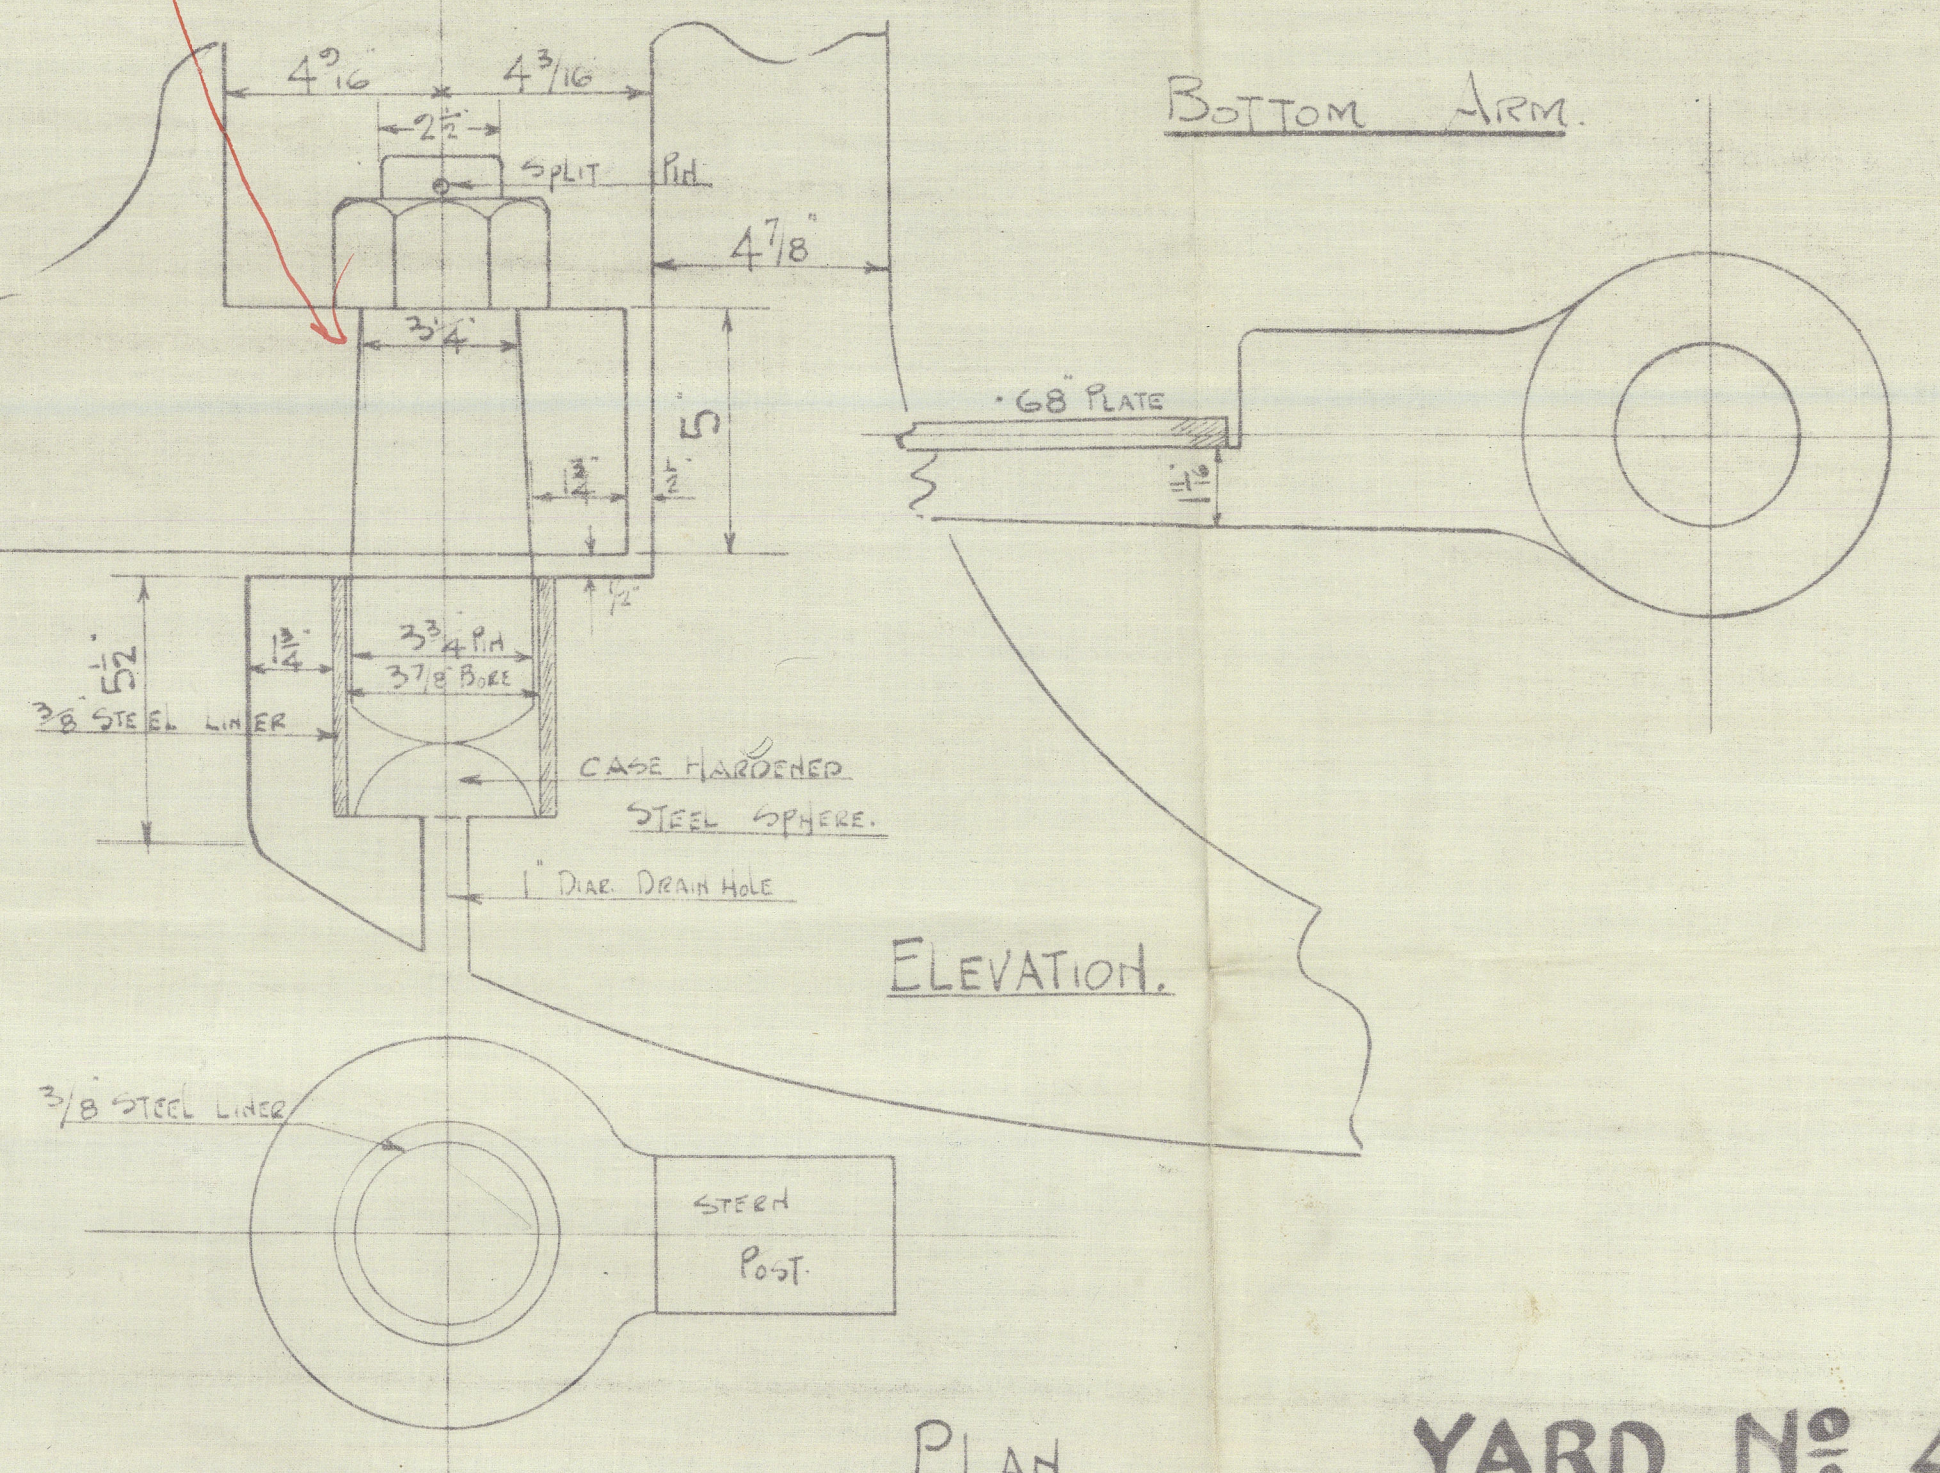

YARD N° 480

3

Rudder & Sternpost.

Bow MacLachlan & Co. Ltd.

N^{os} 480 & 487.

12 " 5 " 28.

480. $\frac{5}{8}$. "Flying Eagle" X

487. $\frac{5}{8}$. "Flying Kite"



© 2020

Lloyd's Register
Foundation

008446-008454-0135

Day.



© 2020

Lloyd's Register
Foundation