

3 OCT 1928


S.S. TUG "FLYING EAGLE"

DIMENSIONS 105' x 27' x 14' M<sup>LD</sup>

STEELWORK PROFILE & DECK PLAN

SCALE 1/4" = 1 FOOT

TO CLASS 'BS' \* (TONING PURPOSES)

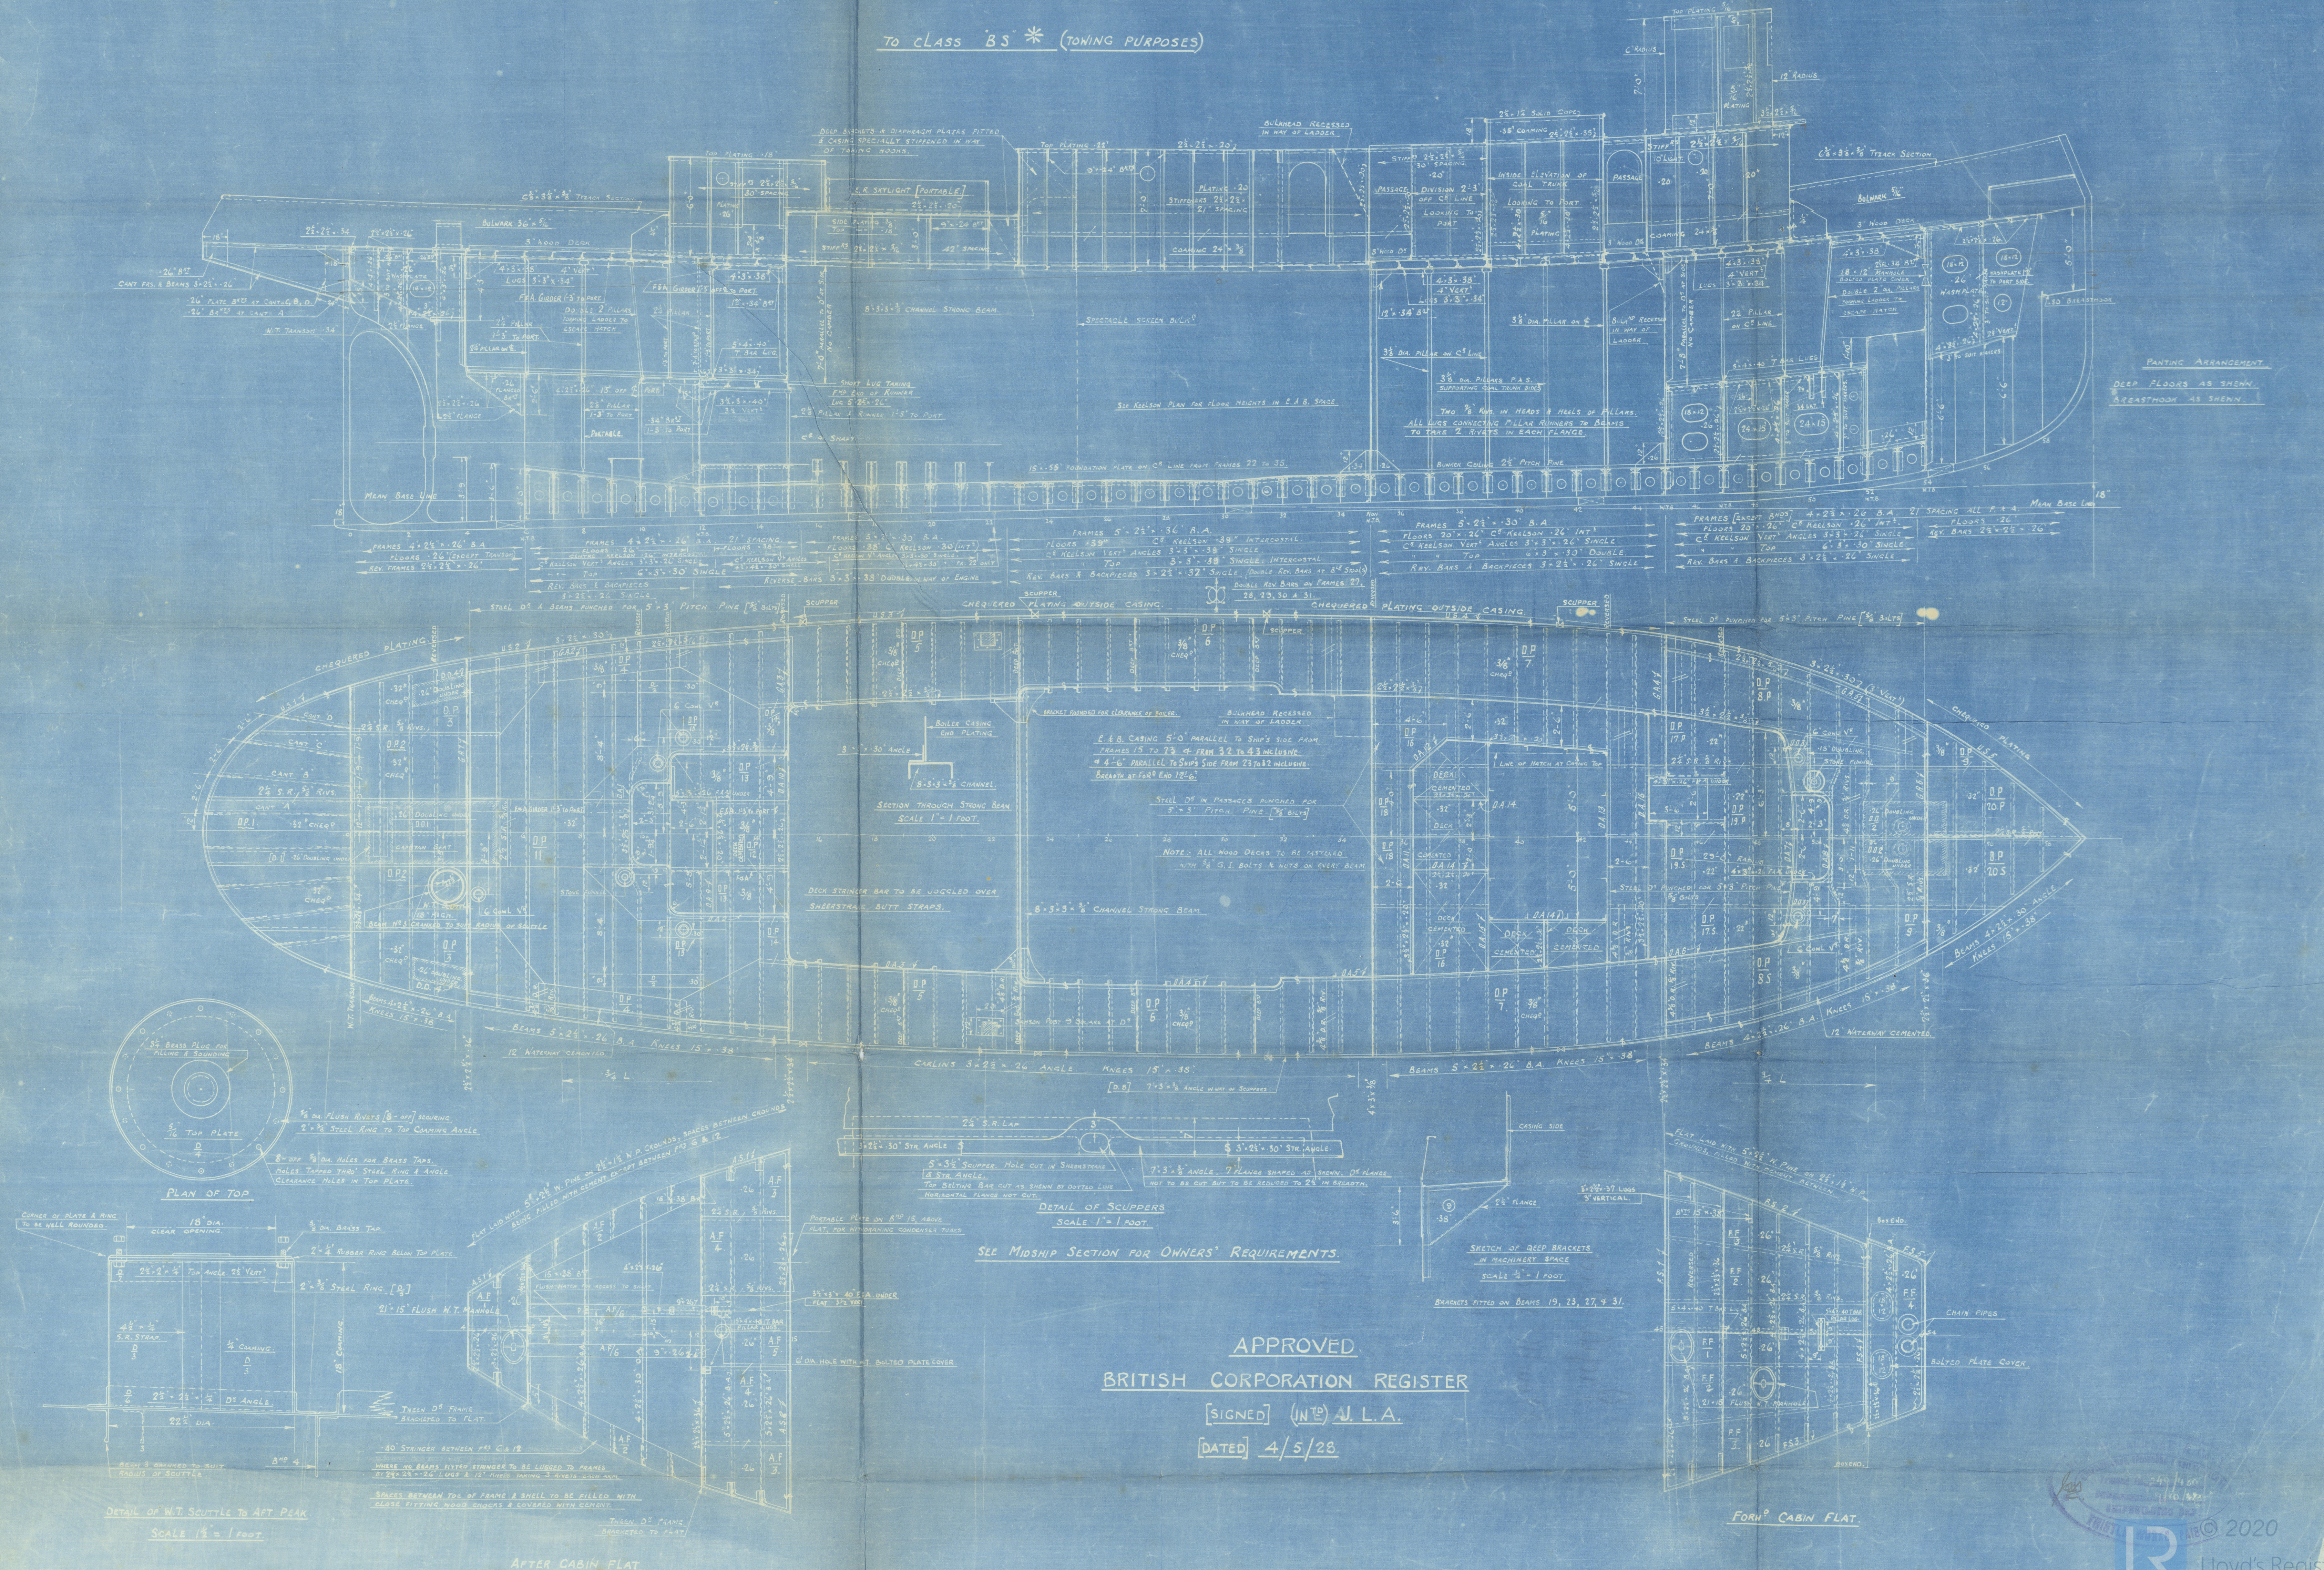

APPROVED  
BRITISH CORPORATION REGISTER  
[SIGNED] (INT) J.L.A.  
[DATED] 4/5/28



12

Profile & Deck [as built.]

How Mc Lachlan & Co.

N<sup>os</sup> 480. & 487.

Reference.

480 "Flying Eagle"

487. "Flying Kite"



© 2020

Lloyd's Register  
Foundation

008446-002434-0136

12