"H. H. Meier"
Twin Screw Steamer

— No 573 —
— Correct —
— Midship Section. —

Sister Vessel to S.S. "Ruthenia"
Newcastle report — No. 26278

Equipment No 418.75 × 109.09 = 45681
$\frac{239.5}{418.75} \times \frac{1}{8} \times 45681 =$ Eqt. No. = 3266 / 48947

3 Bowers 45 cwts ex stock.
1 " 38¼ " " "
1 Stream 15¼ " " "
1 Kedge 7½ " " "
1 Kedge 3½ " " "
300 Fathoms 2¼" stud chain cable.
90 " 1¼" Stream chain
120 " 4¾" Steel Wire
90 " 4" " "
90 " 3¼" " "

Principal Dimensions.

	Feet	Inches
Length over all	435	0
Length between Perps	420	0
Breadth Extreme	48	0
Depth Moulded	32	3
Depth of Hold	29	3

Scale ½ Inch = One foot.

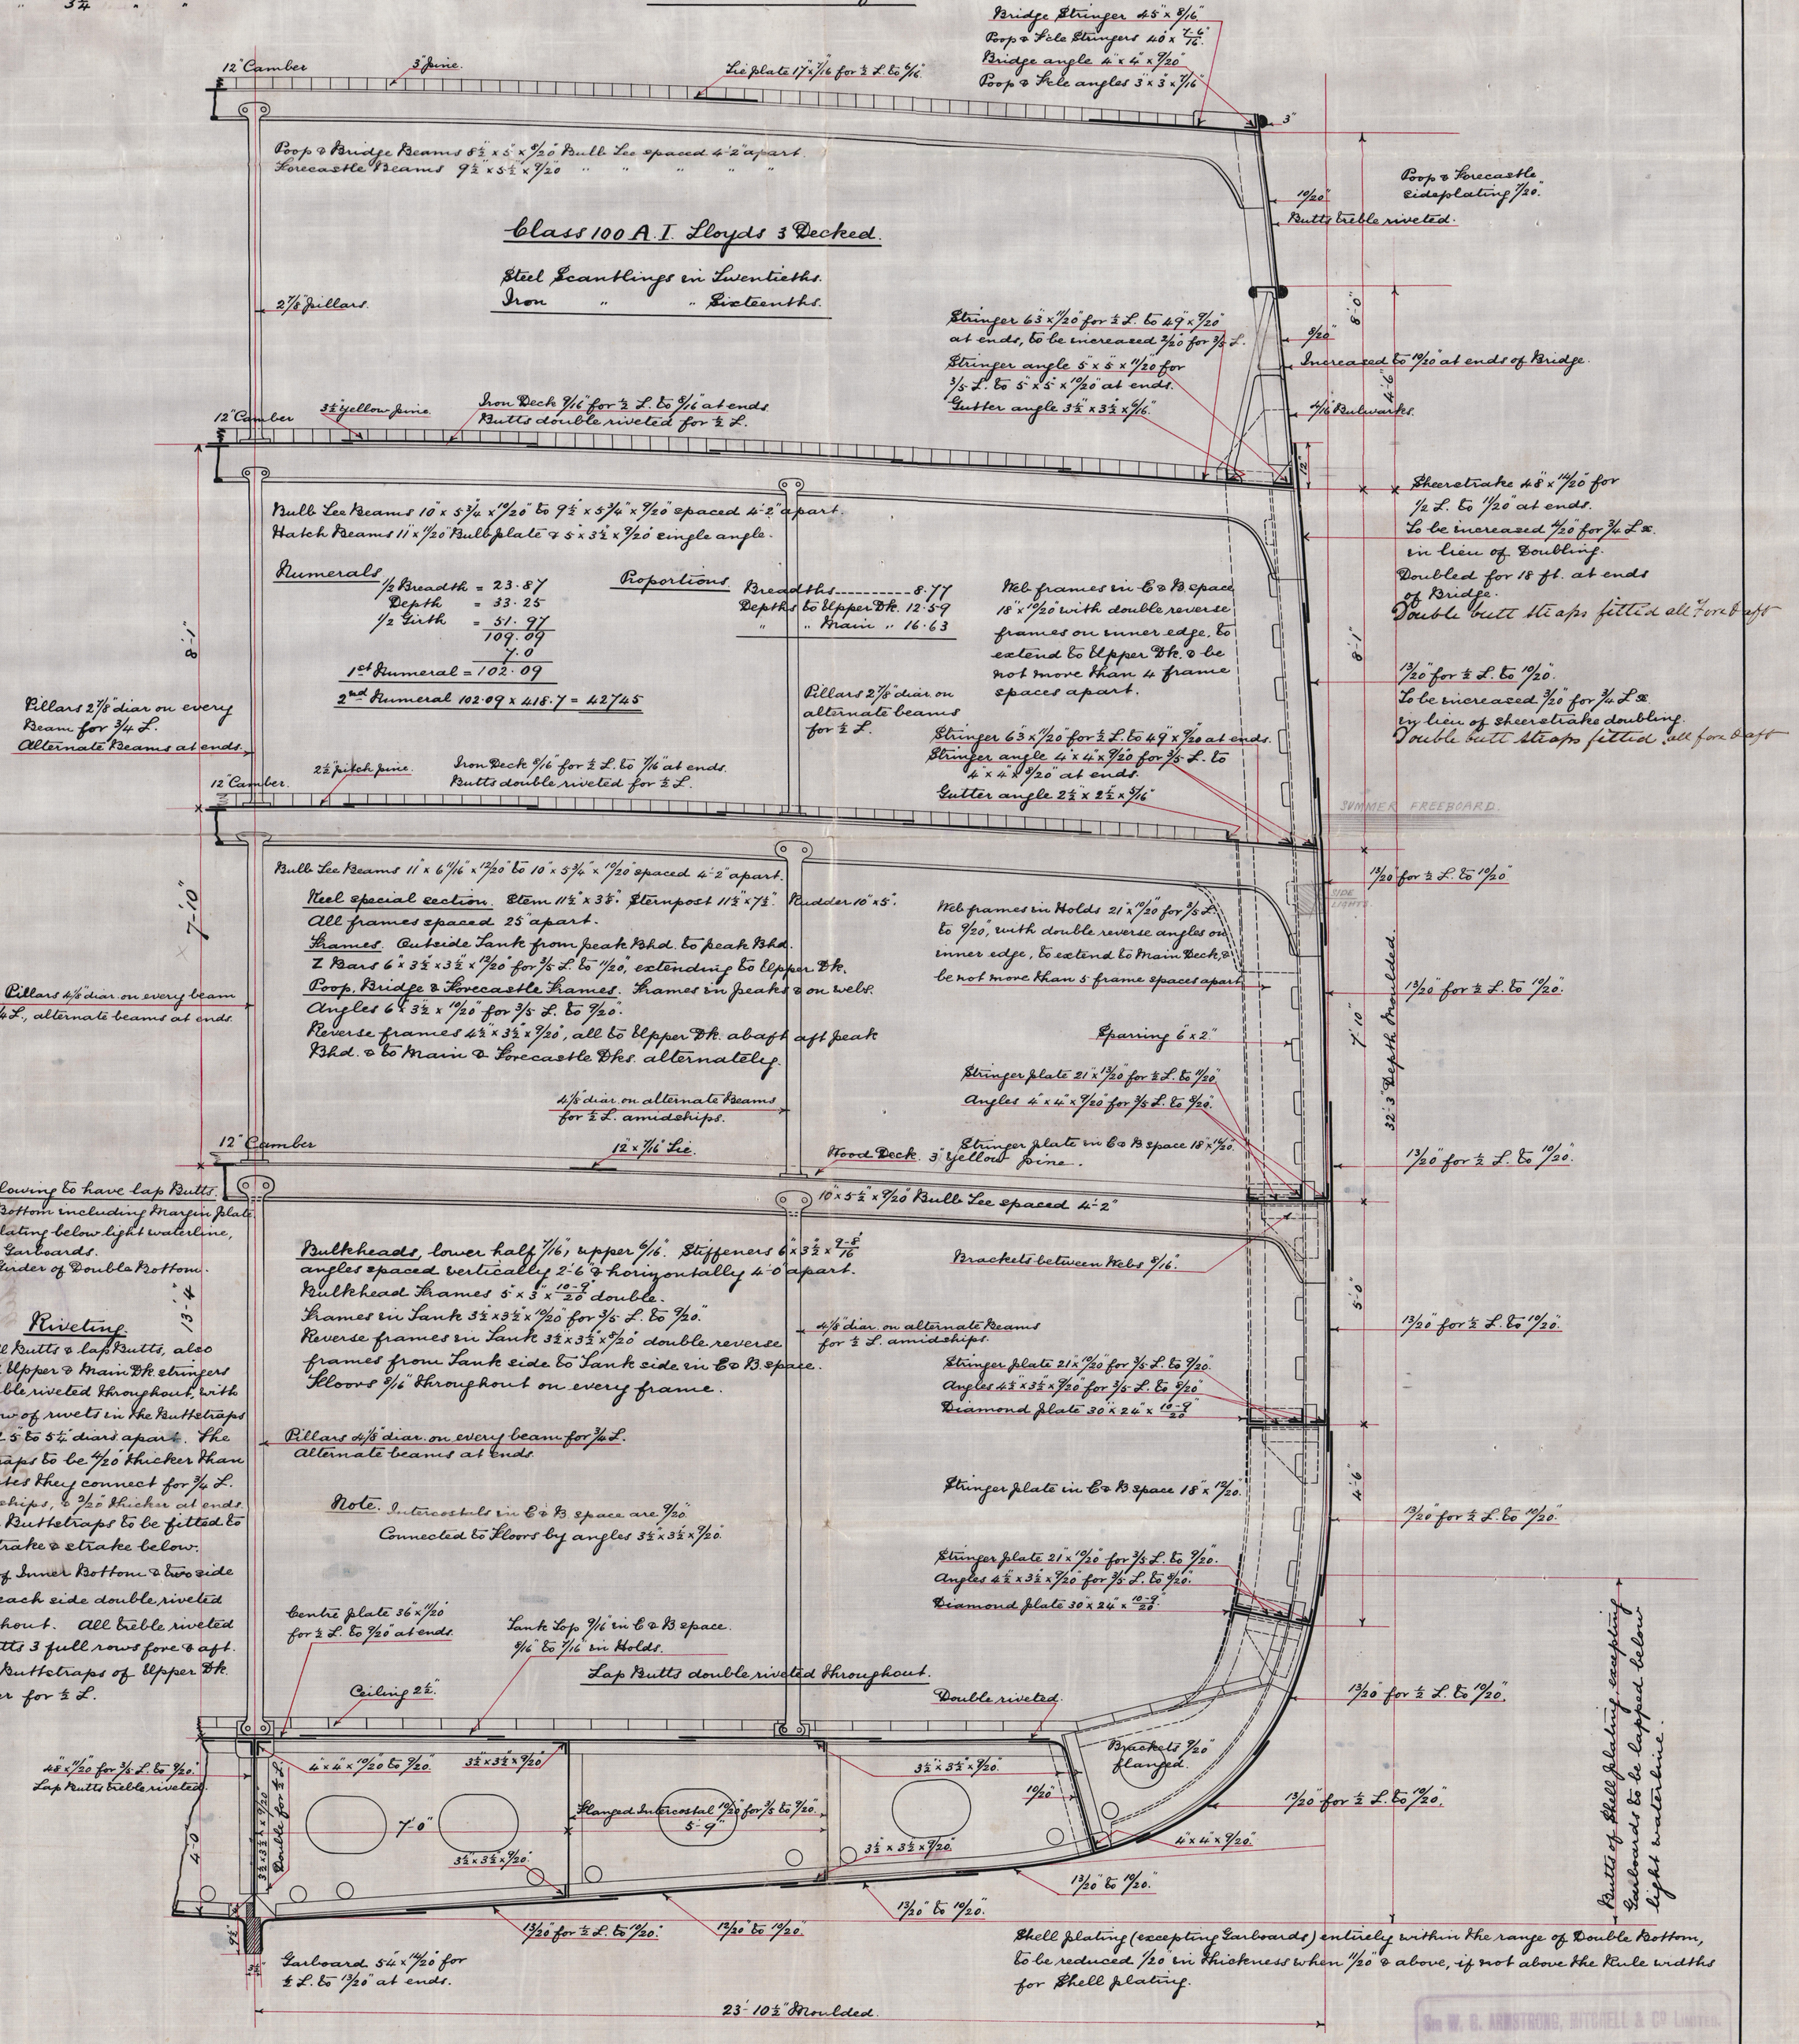

Midship section of s.s.

"H. H. Meier"

Manuel Calvo

Messrs Armstrong Mitchell & Co's No 573.