


# MIDSHIP SECTION S.S. N° 396 SCALE 1/2 INCH = ONE FOOT.




16.3.05  
10.4.05  
1.6.05



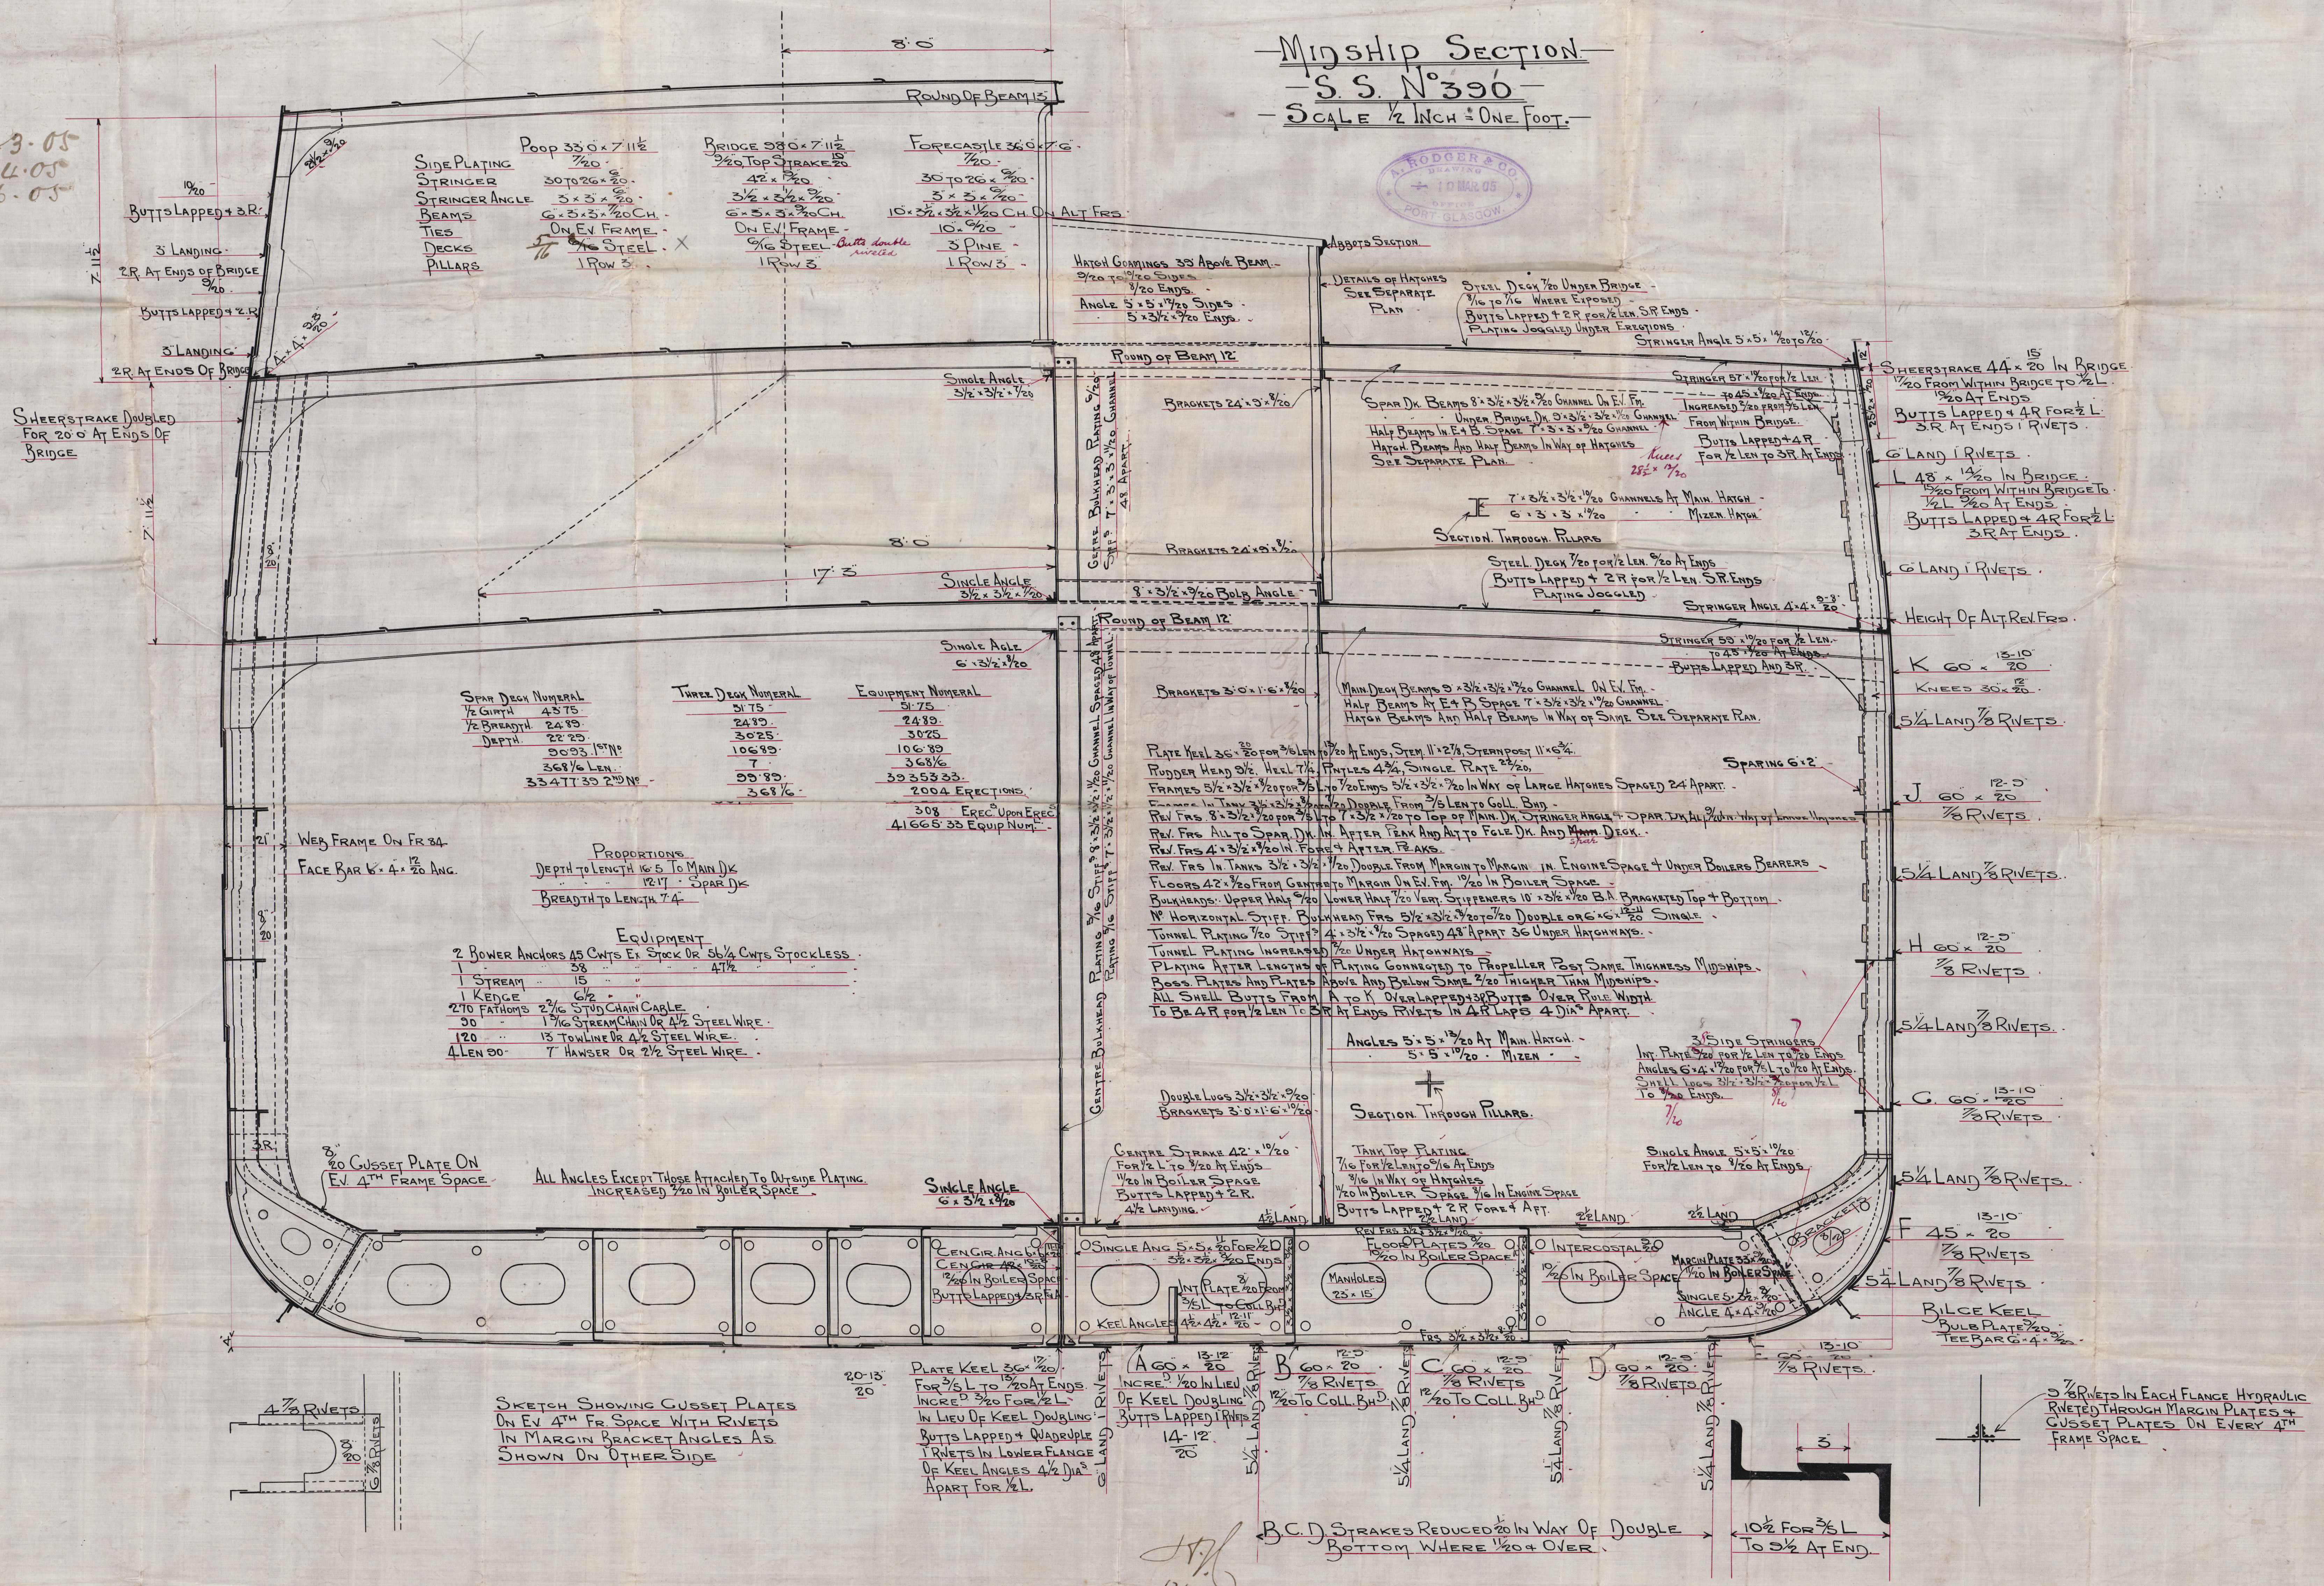

Midship Section  
A. Rodger & Coy  
No. 390

S.S. "Bessie Dollat"  
report No 14500

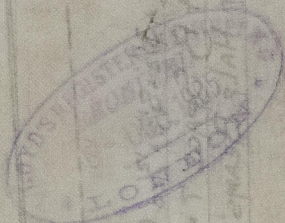

© 2020

Lloyd's Register  
Foundation

008507-008514-0097