



S.S. N° 390

SCALE  $\frac{1}{2}$  INCH = ONE FOOT.

10.4.05

1 ROW TWEEN DECK STANCHIONS

IN LIEU OF CENTRE BULKHEAD

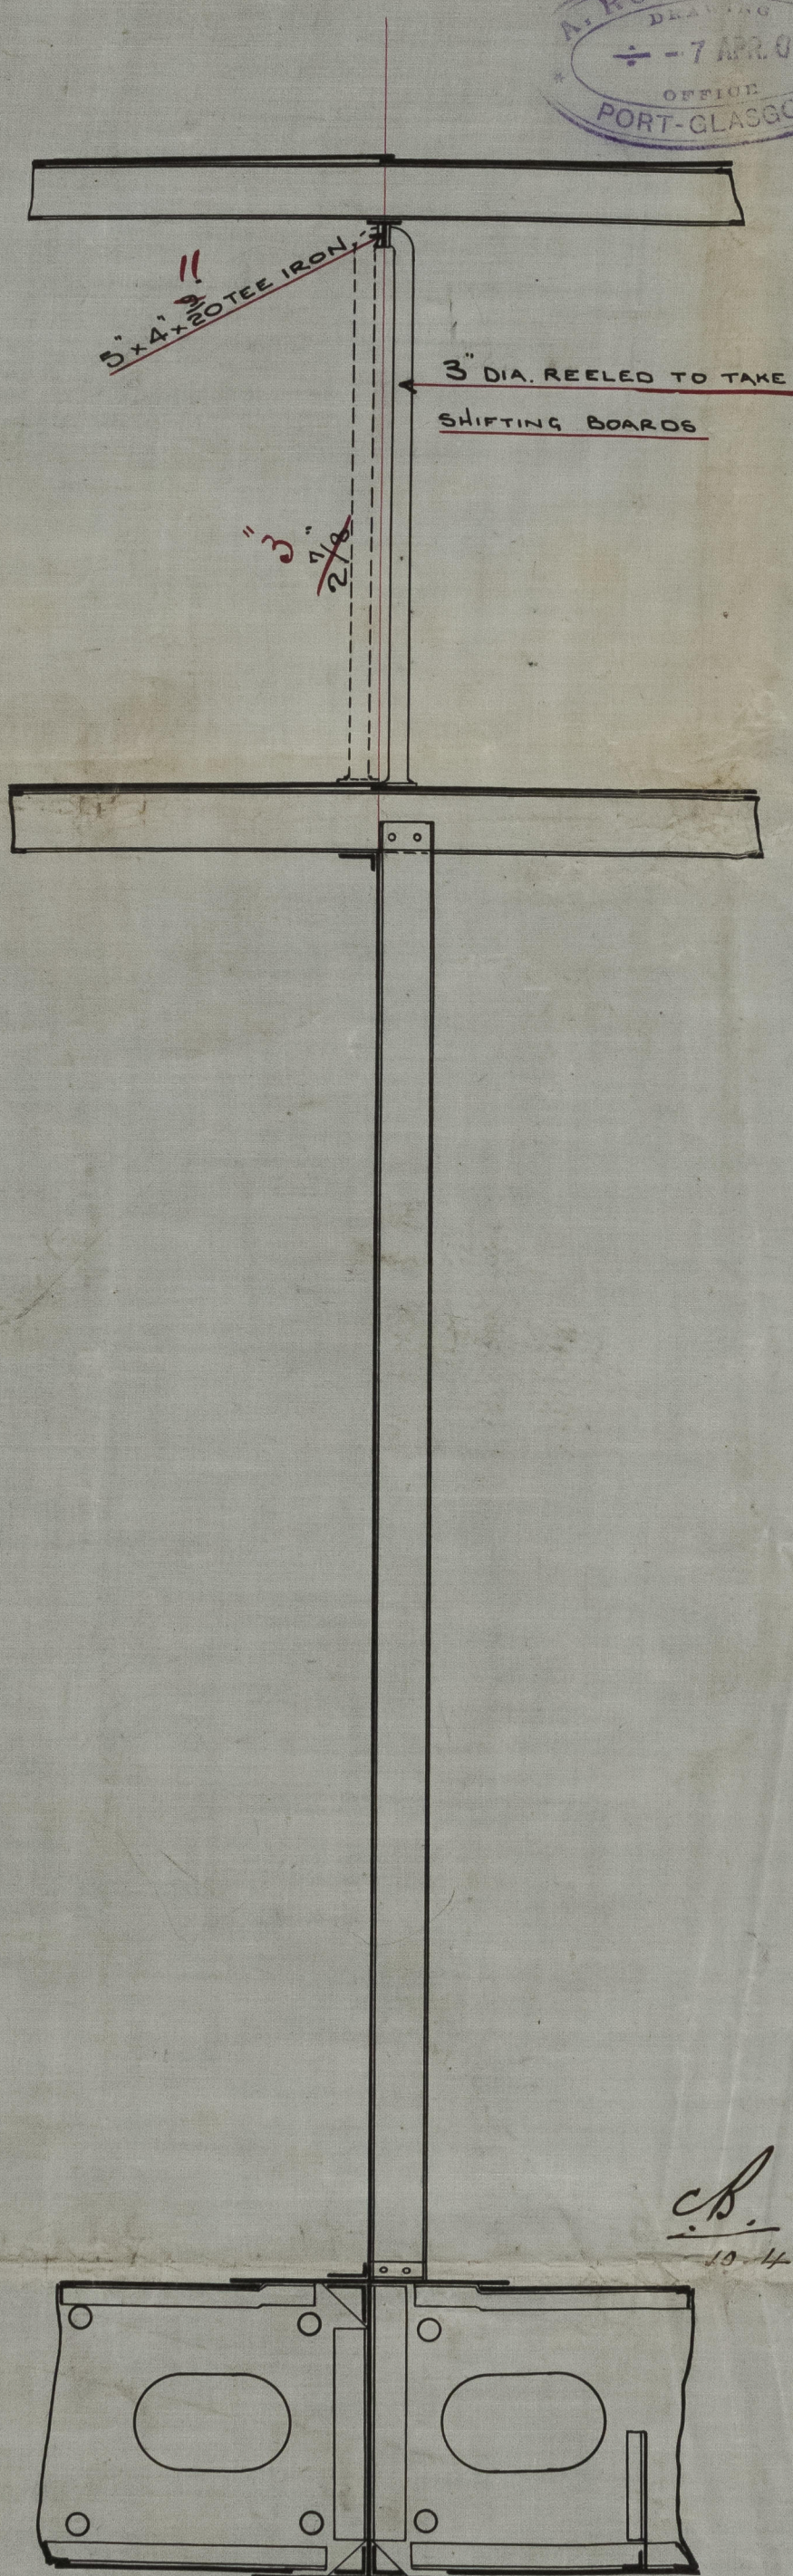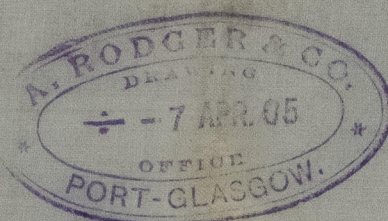

C.B.

10.4.05



© 2020

Lloyd's Register  
Foundation