



10.4.05

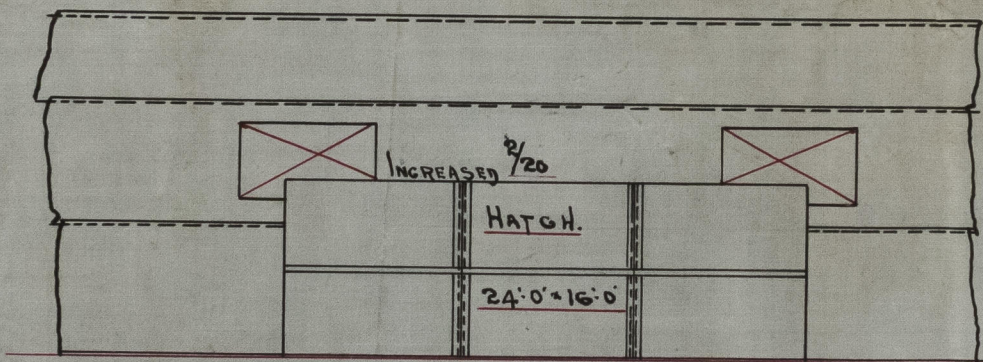

ALTERNATIVE ARRANGEMENT OF AFTER HATCH.
S. S. 390
SCALE 1/8 INCH = ONE FOOT

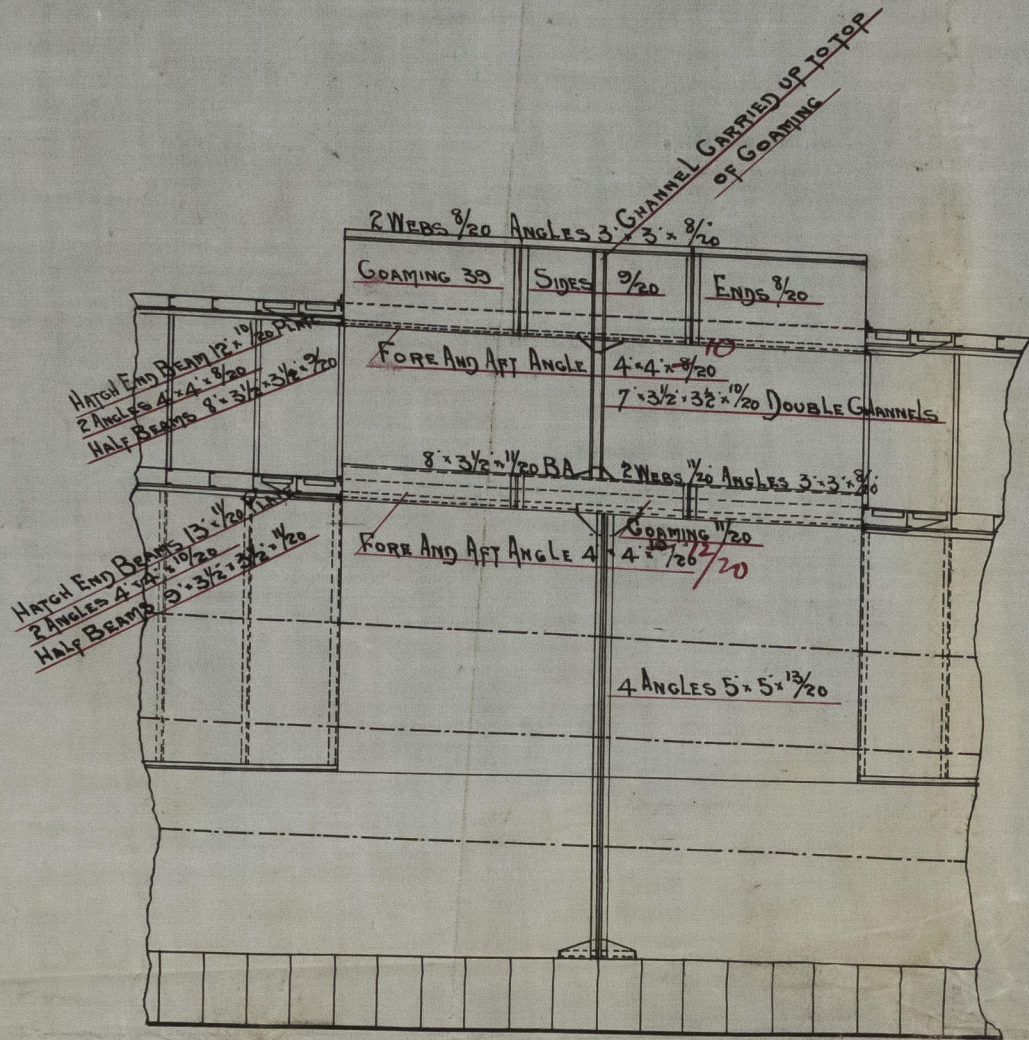