


25.2.19.

RUDDER & SCREW FRAME.

RUDDER & STEM BAR, FORGED STEEL.
STERN FRAME FORGED IRON.
(TO PASS LLOYDS)

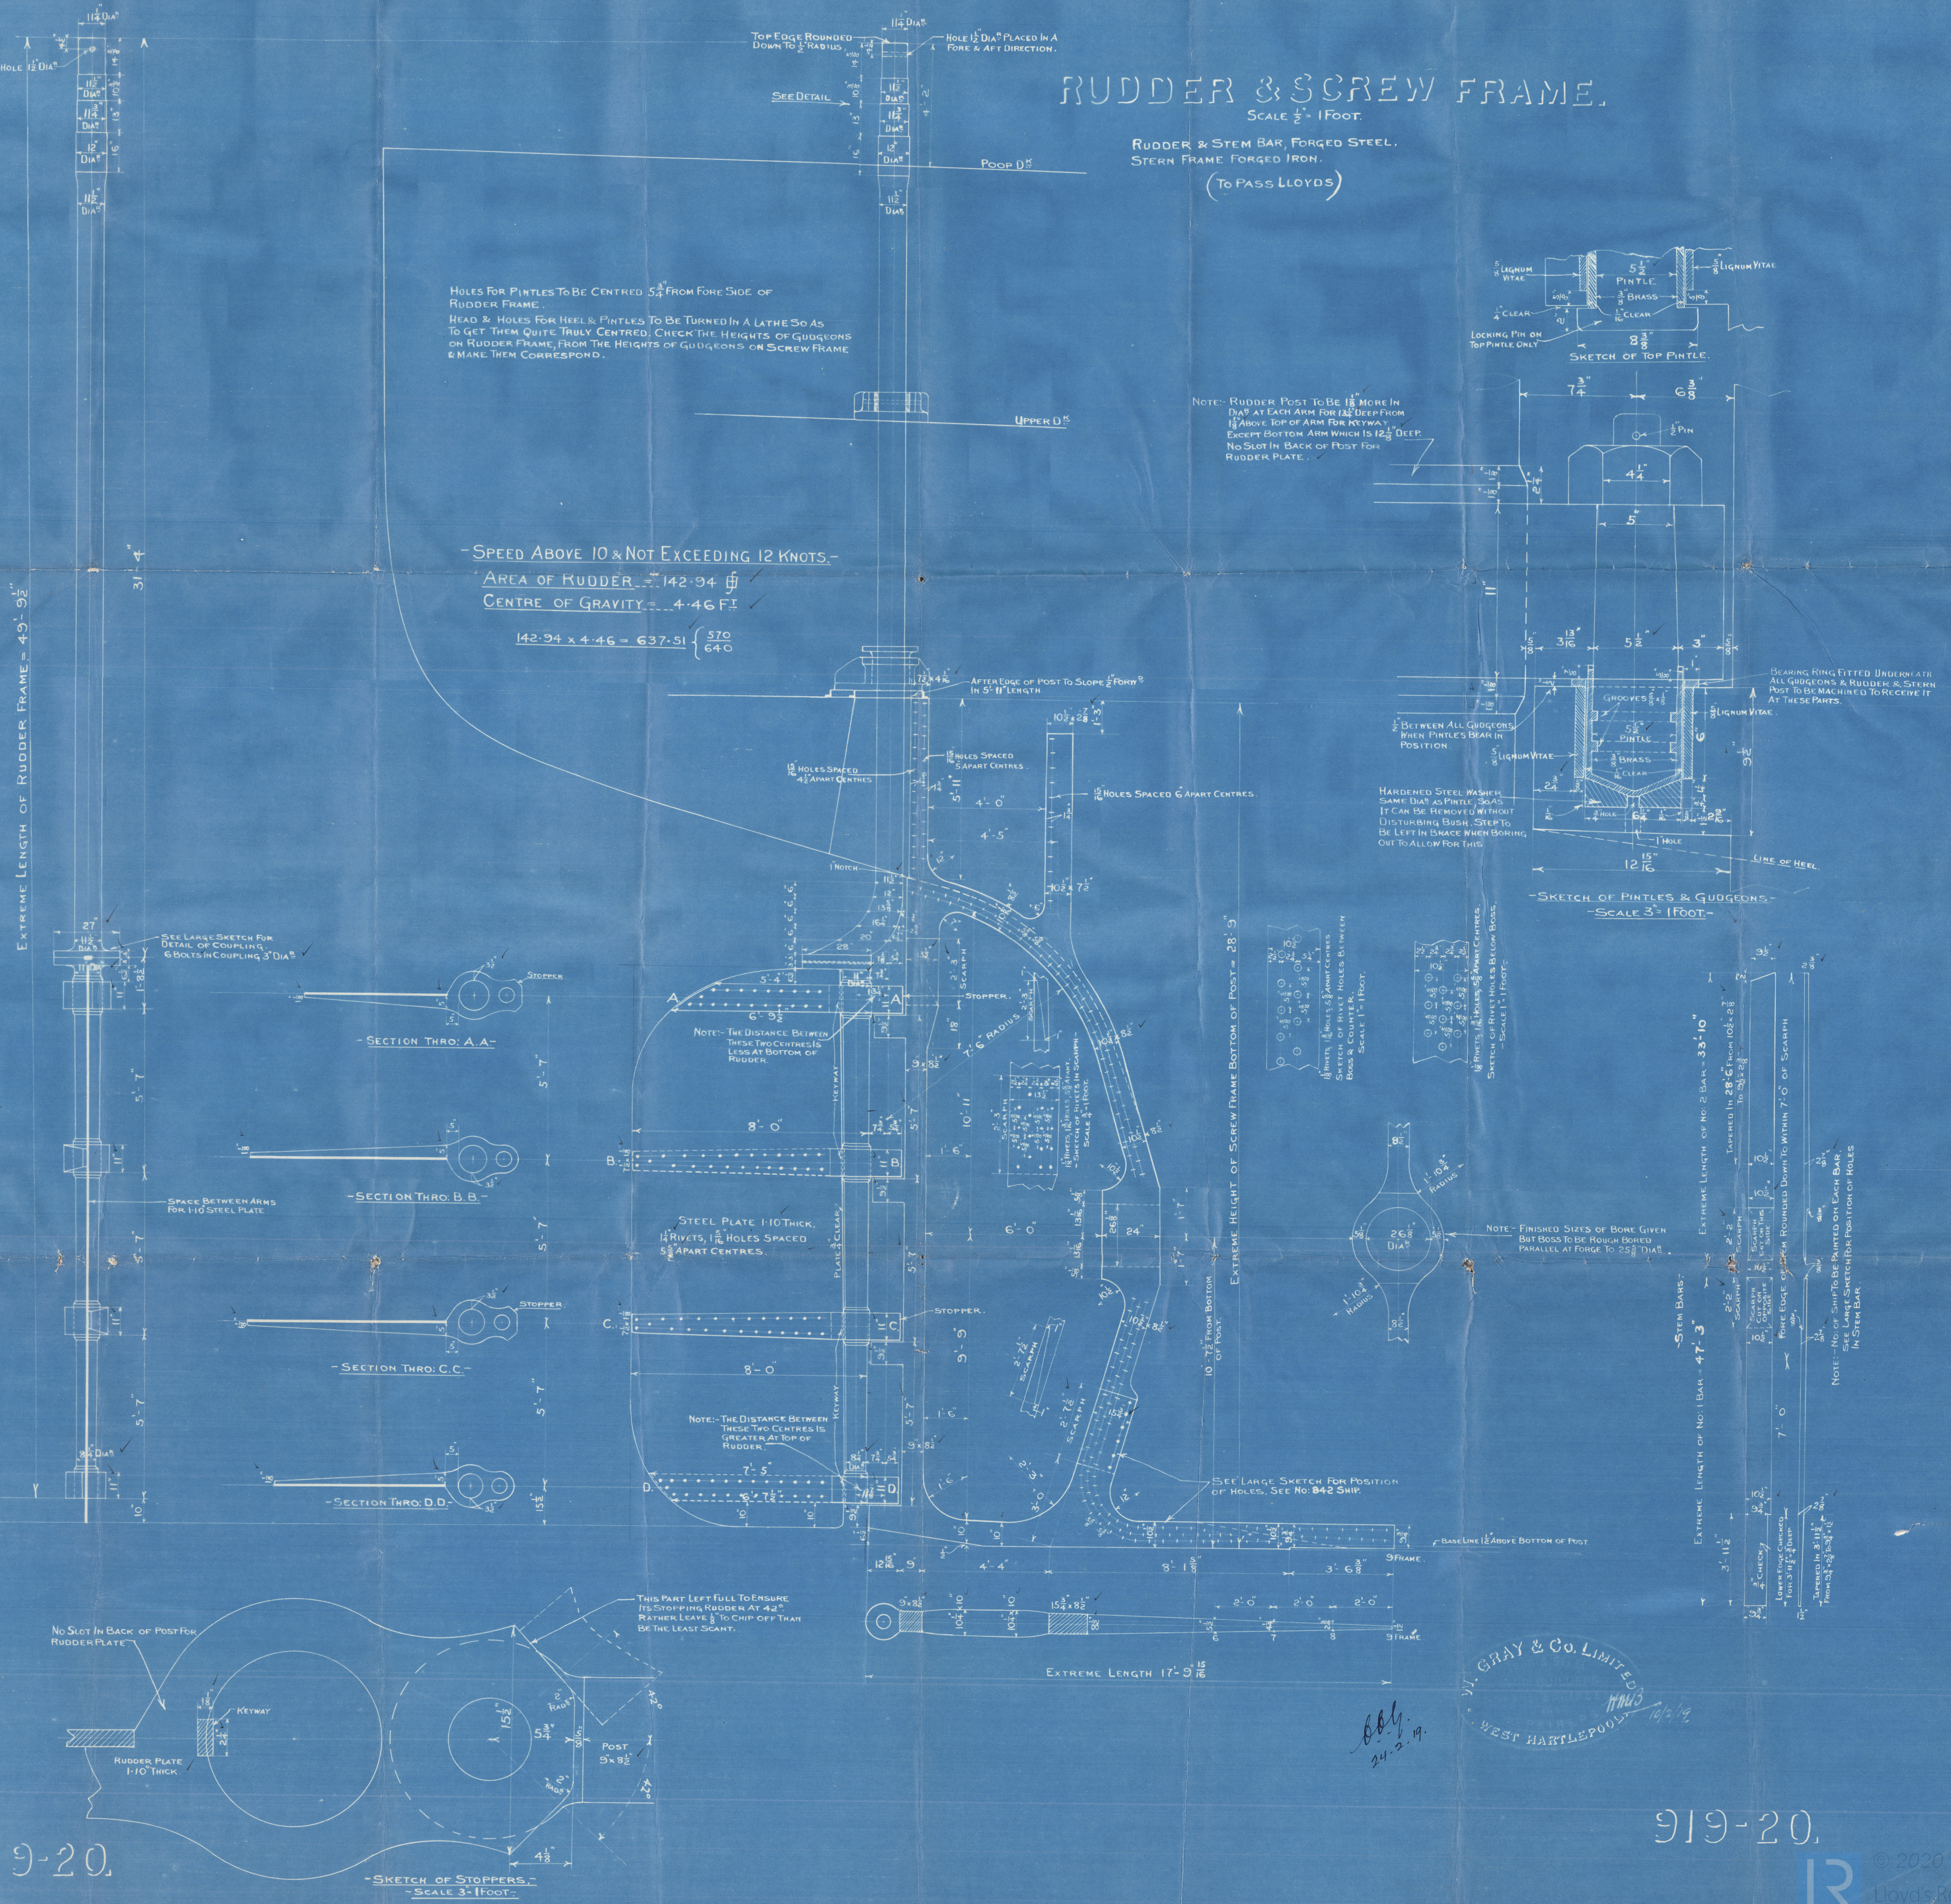

919-20

919-20

ALBANY

(1)

RUDDER

GRAY'S 919-20

No 919

City of Evansville
Apr. 16033.

No 920

S/s "City of Singapore". Apr Rpt 16062.


Rudder

Gray's 919-20

GRAY'S

16033

008507-008514-0136

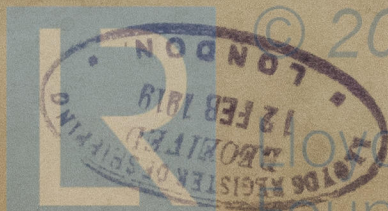

© 2020

Lloyd's Register
Foundation