

2407-11

PROFILE & DECK PLAN


No 511

DIMS 120'-0" x 21'-6" ex x 12'-3" MLO


SCALE 1/4" = 1 FOOT

PILLARS TO SURVEYORS SATISFACTION

PLAN No. 532
FOR ENCLOSURE TO
Messrs Lloyd's Surveyors
Full FROM
COCHRANE & SON'S
SHIPBUILDERS, SEABY
DATE 2/7/11 RK

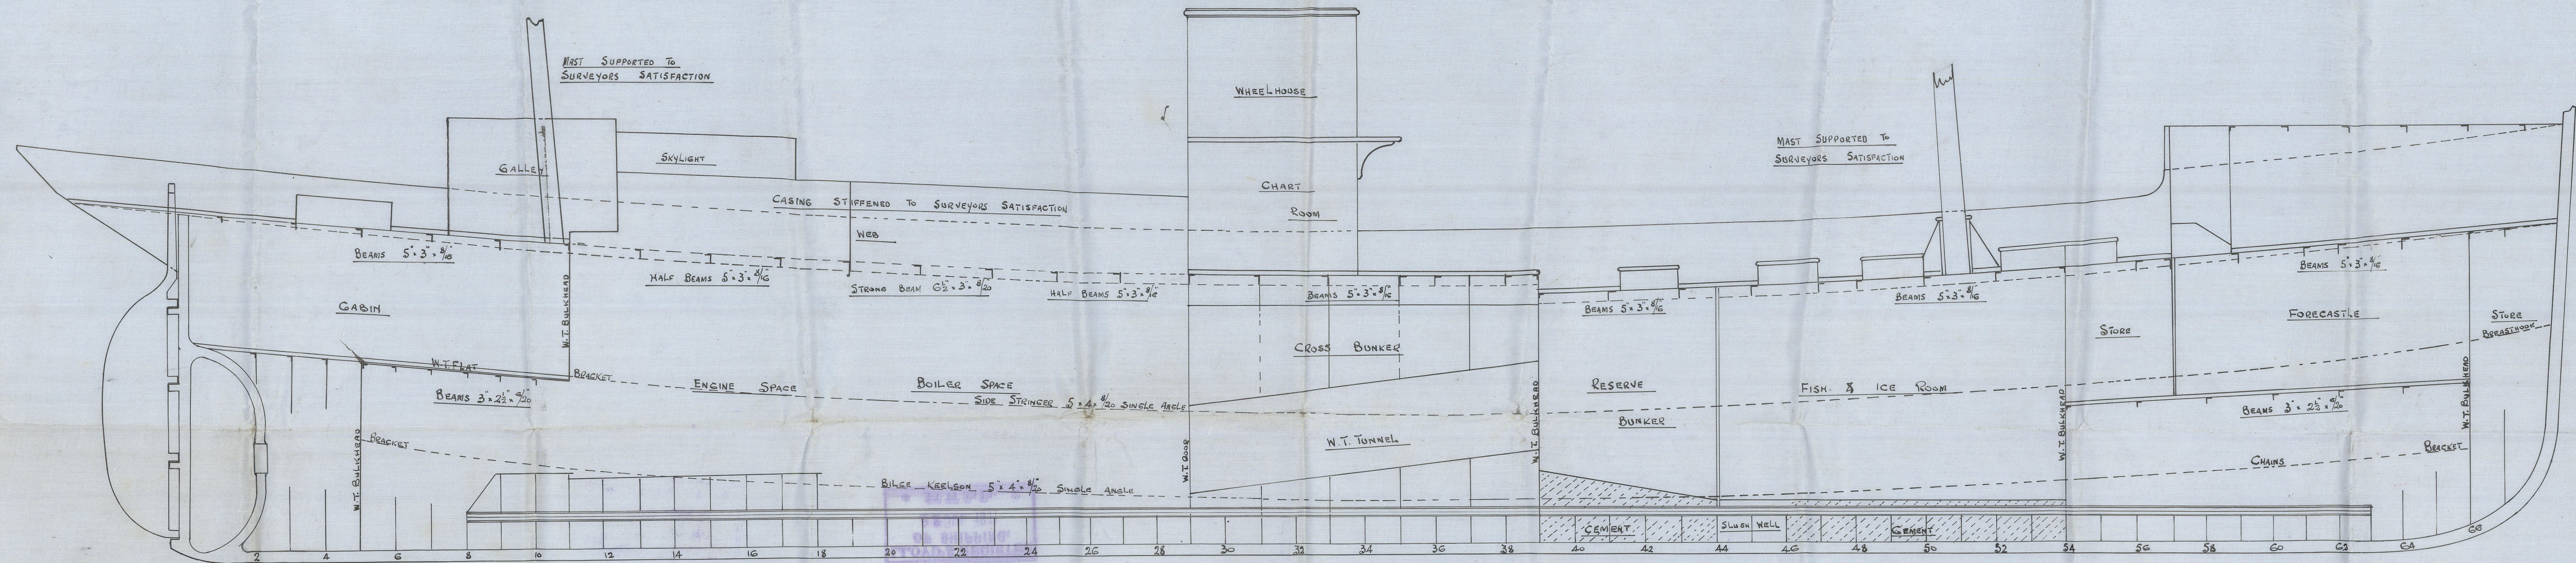

Pillaring throughout to Surveyors Satisfaction.

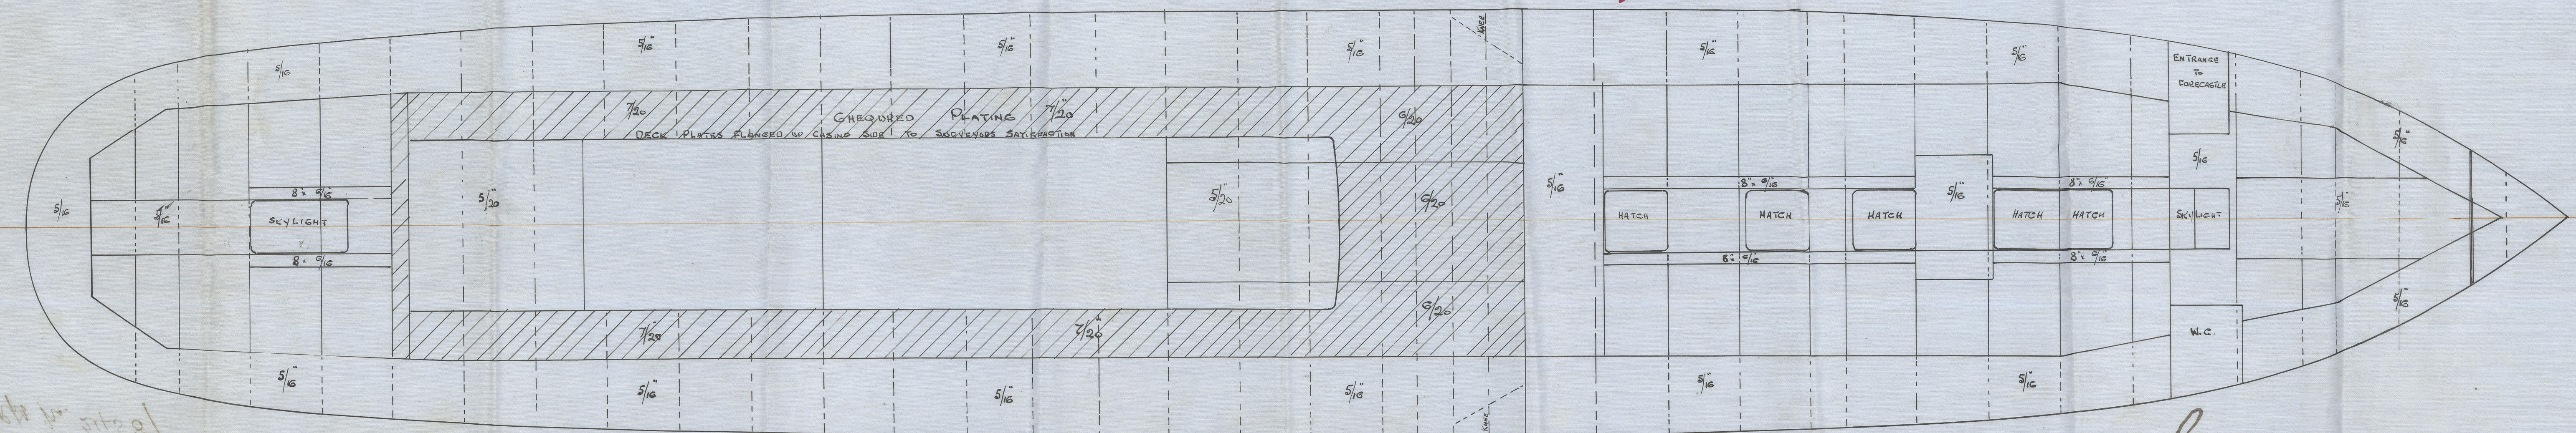


W. W. W. W. W.

Nº 511
PROFILE + DECK
COCHRANE & SONS

St. Glycine
Hull Rpt No. 24587



005995-006015-0289

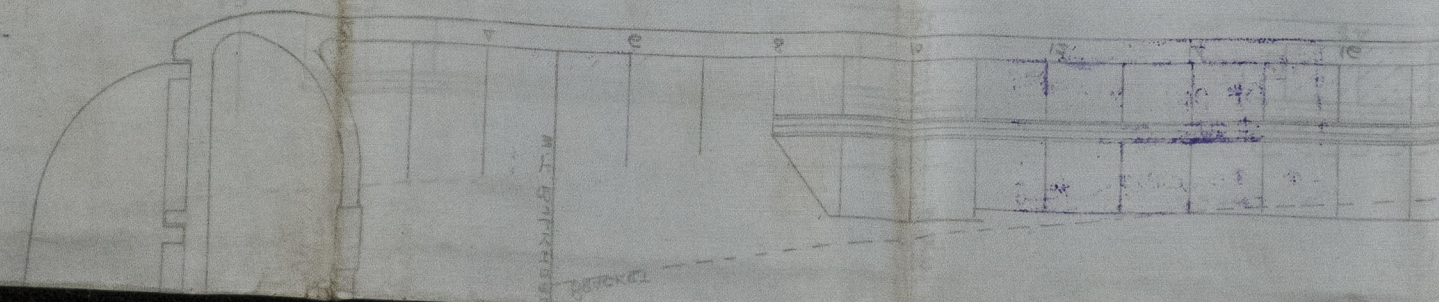

LLOYD'S REGISTER
OF SHIPPING
22 JUL 1911
HULL



© 2021
Lloyd's Register
Foundation

008515-008523-0054.1