

247.11

MIDSHIP SECTION

No 511

PLAN No. 533

FOR ENCLOSURE TO
Messrs Lloyd's Surveyors
Hull

COCHRANE & SONS
SHIPBUILDERS, BELLY


DATE 21/7/11 RK

STEEL SCREW TRAWLER

DIMS 120'-0" B.P. x 21'-6" EX x 12'-3" MLO

SCALE $\frac{1}{2}$ = ONE FOOT

VESSEL TO CLASS 100. A.1. AT LLOYDS FOR FISHING PURPOSES
DECK PLATED OVER IN WAY OF MACHINERY SPACE E & B
CASING AS PREVIOUSLY APPROVED

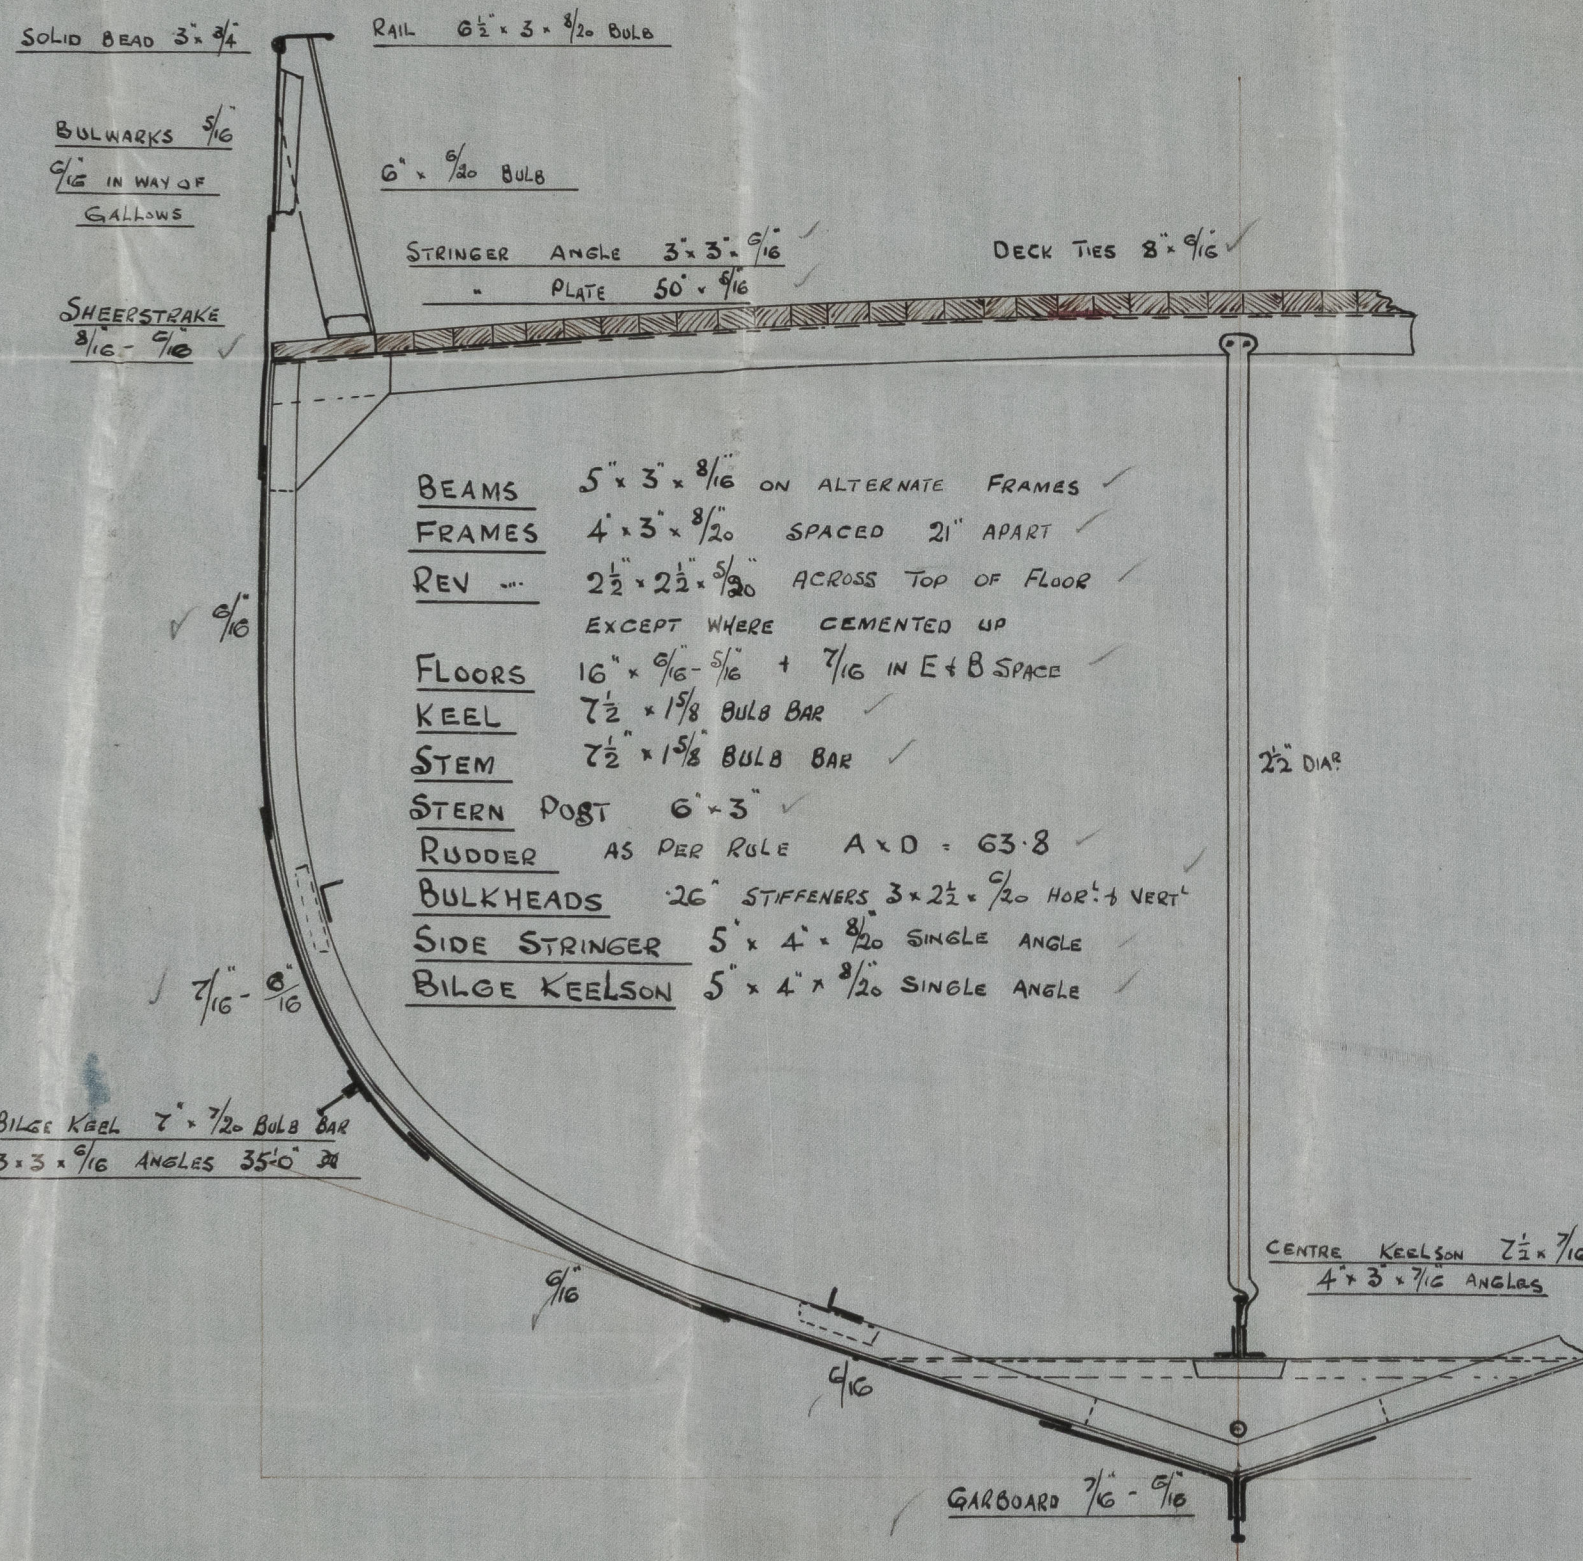

NUMERALS

B + D = 33.625 ✓
L x (B + D) = 4035 ✓

PROPORTIONS

$\frac{L}{D}$ = 9.79 ✓
 $\frac{L}{B}$ = 5.61 ✓

EQUIPMENT

1 ST BOWER ANCHOR	5 CWTs	EX STOCK	✓
2 ND " "	4 $\frac{1}{2}$		✓
KEDGE " "	2 $\frac{1}{2}$		✓
90 FATHOMS	1" CABLE		✓
60 "	5 $\frac{1}{2}$ " HANSE		✓
60 "	4" WARP		✓

RIVETING

BUTTS OF SHELL PLATING LAPPED
+ DOUBLE RIVETED EXCEPT GARBOARD
+ SHEERSTRAKE WHICH ARE TO BE
STRAPPED + DOUBLE RIVETED. LANDINGS
DOUBLE RIVETED. BULWARKS SINGLE

C.B.
24 7.11.

N^o 5-11

MIDSHIP SECTION

COCHRANE & SON.

Sp Elysian
Hull Rph No. 24587

008515-008523-0054

© 2021

Lloyd's Register
Foundation

$\frac{8}{9} + \frac{1}{9}$



© 2021

Lloyd's Register
Foundation

MADE IN U.S.A. OF MACHINERY

10-11-12

NO. 10

SHIP SECTION