


S.S. 165. LANGSDOORSNEDE MET DEKKEN SCHAAI 1/8" = 1'-0"

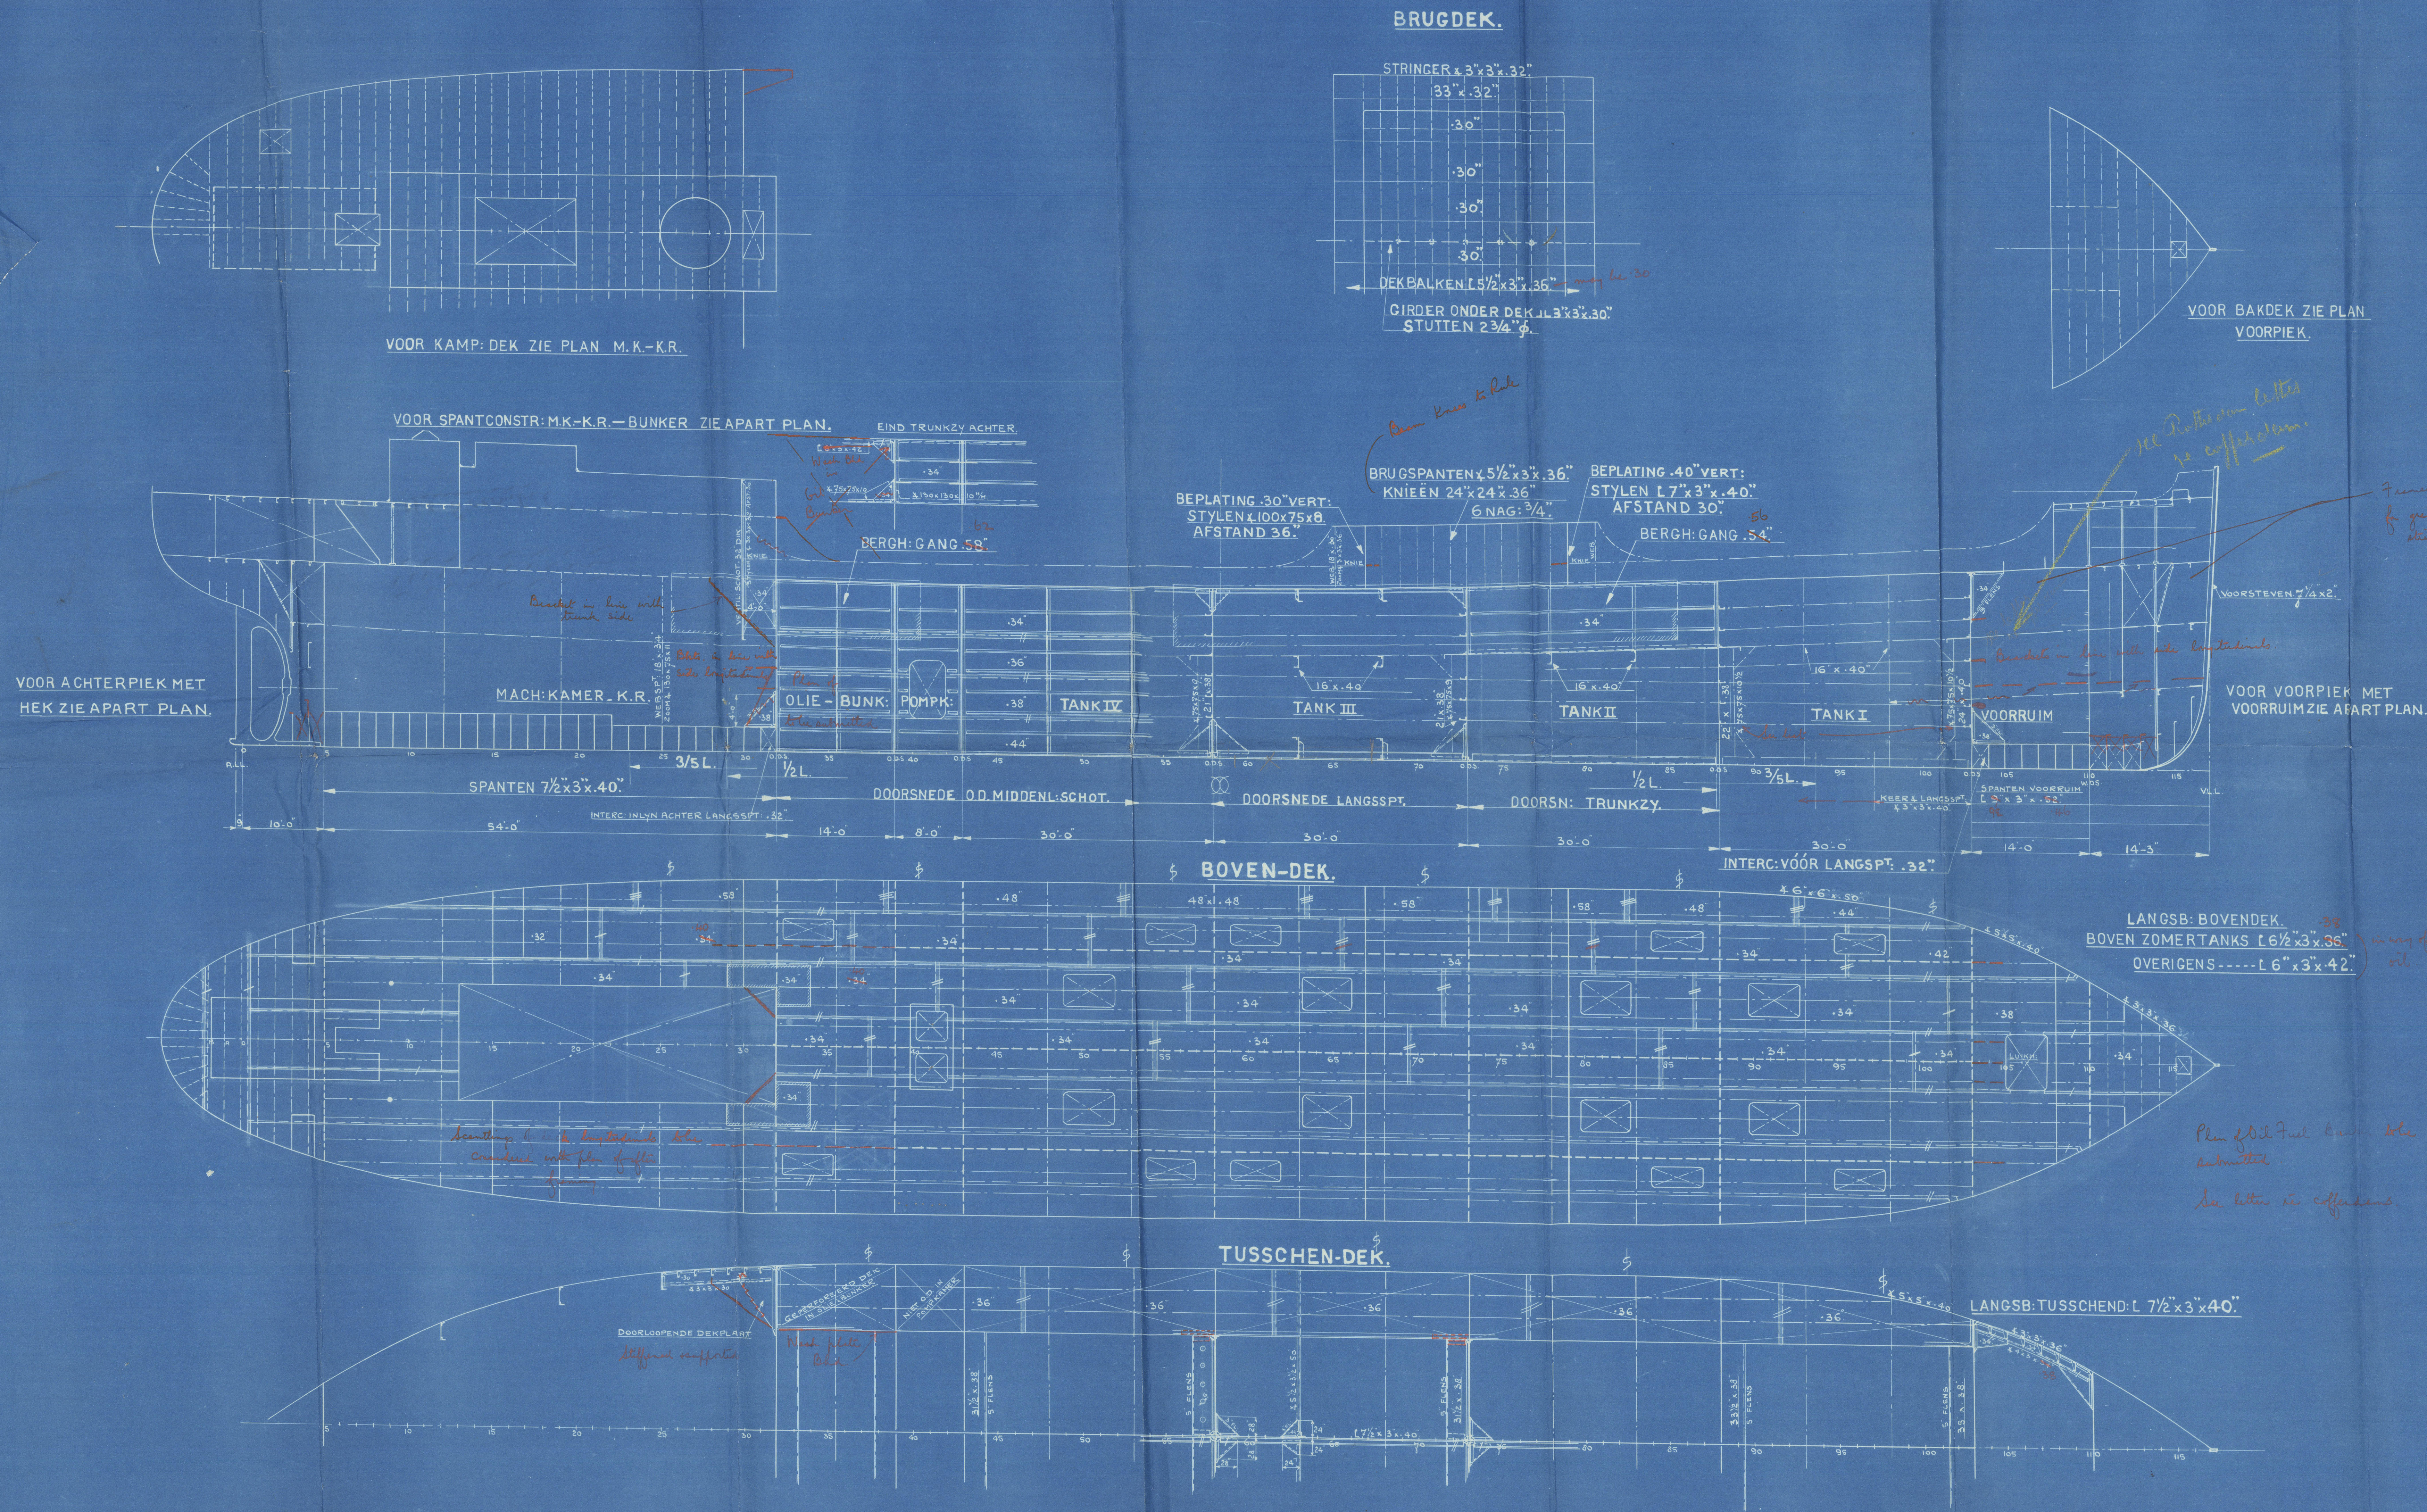

TANK	No	LANGSSPANTEN		TRANSVERSES				HORIZ. STYLEN	
		HOUD. INCL. KIMSP.	O.D. M.L. SCHOT	WEBS	ZOOM	WEBS	ZOOM	WEBS	ZOOM
TANK I	1	1.6 x 3.4 x .40	1.7 x 3.4 x .40					5.0 x 1.03	1.6 x 3.4 x .36
	2	1.6 x 3.4 x .40	1.7 x 3.4 x .40					5.0 x 1.03	1.6 x 3.4 x .36
	3	1.6 x 3.4 x .40	1.7 x 3.4 x .40					5.0 x 1.03	1.6 x 3.4 x .36
	4	1.6 x 3.4 x .40	1.7 x 3.4 x .40					5.0 x 1.03	1.6 x 3.4 x .36
	5	1.6 x 3.4 x .40	1.7 x 3.4 x .40					5.0 x 1.03	1.6 x 3.4 x .36
TANK II	6	1.6 x 3.4 x .40	1.7 x 3.4 x .40					5.0 x 1.03	1.6 x 3.4 x .36
	7	1.6 x 3.4 x .40	1.7 x 3.4 x .40					5.0 x 1.03	1.6 x 3.4 x .36
	8	1.6 x 3.4 x .40	1.7 x 3.4 x .40					5.0 x 1.03	1.6 x 3.4 x .36
	9	1.6 x 3.4 x .40	1.7 x 3.4 x .40					5.0 x 1.03	1.6 x 3.4 x .36
	10	1.6 x 3.4 x .40	1.7 x 3.4 x .40					5.0 x 1.03	1.6 x 3.4 x .36

MATERIAAL TANKS III EN IV ZIE GROOTSPANT			
NIET AANGEGEVEN MATERIAAL			
GEMIDDELDE TANKHOOGTE	TANK I = 21'-10"	MIDSCH. DEKHOOGTE	SCH. 103 = 23'-4"
"	" II = 20'-5"	"	" 88 = 21'-9"
"	" III = 9'-8"	"	" 73 = 20'-8"
"	" IV = 9'-8"	"	" 58 = 20'-4"
"	"	"	" 43 = 20'-7"
"	"	"	" 39 = 20'-10"

S.S. 165. LANGSDOORSNEDE MET DEKKEN.

- R.D.M. - - TEEKENKAMER - - S-

ONTVANGEN	1	2	3	4	5	6	7	8	9	10	11	12
BANKWERKEN												
BEDEUDELIGER												
KOPPELAGE												
MODELMAKERIJ												
OPZICHTER												
SCHRIJFMAKERS												
SMEDERIJ												
SPANTENBESCHUJ												
TARIEFMAKERS												
TIMMERWERK												
APD. W.												
LEERWERK												
Lloyd's												

No. 165002

15. 4. 29


Roll NO. 16
P. 100
h. 100

[Handwritten signature]

M. S. Soeombel

SOCCOMBEL

008541-008549-0062

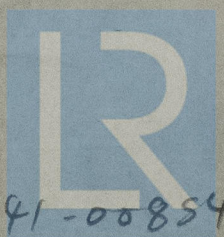

© 2020

Lloyd's Register
Foundation

008541-008549-0062